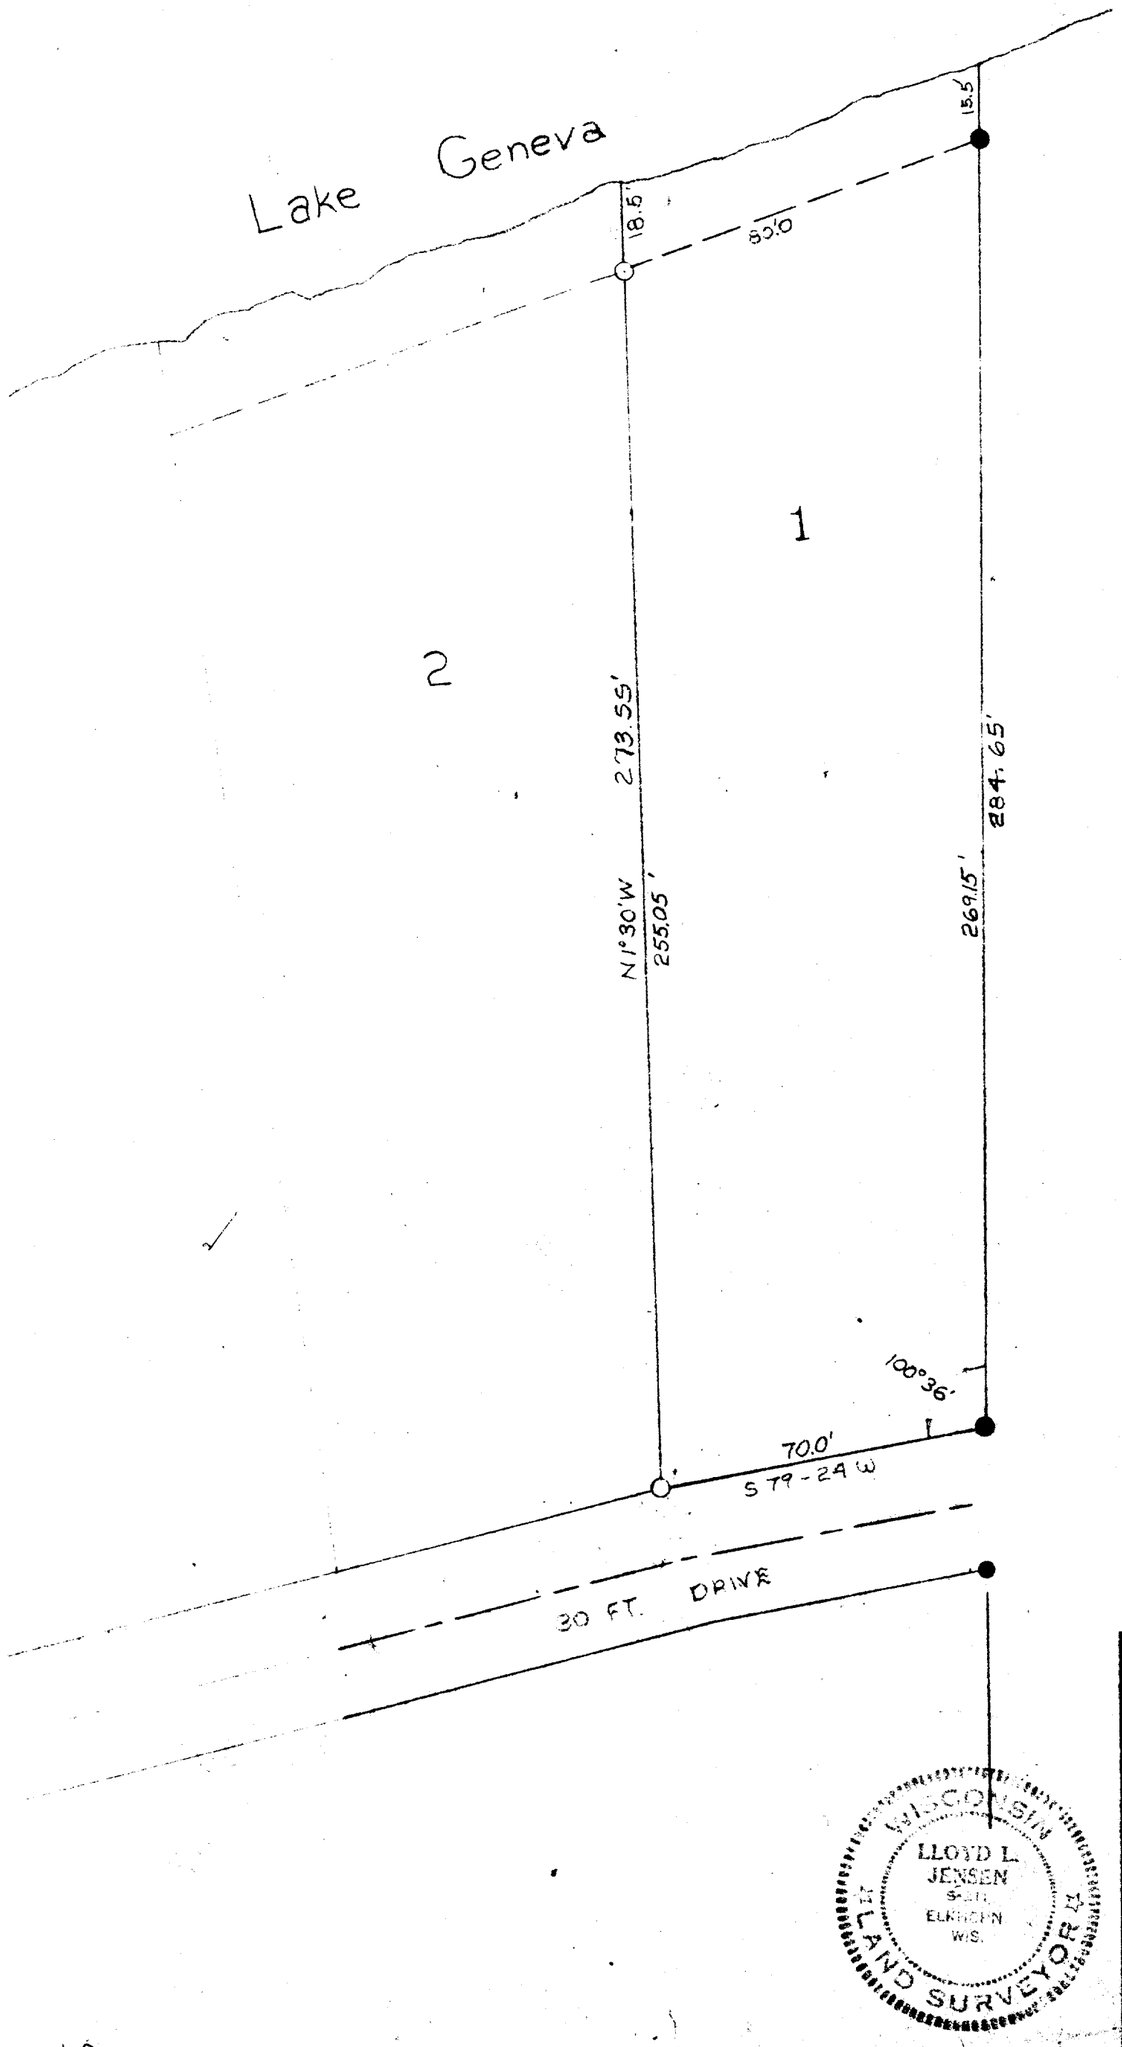


O IRON PIPE

● IRON PIPE IN CONCRETE

PLAT OF SURVEY

OF

Lot 1 of the Birches First Addition, Located in Section 9, T1N R17E of Walworth County Wisconsin

Lloyd L Jensen
SURVEYOR

SCALE 1" = 30'

DATE Nov. 1957

1BA1-1

117-165.1