PLAT OF SURVEY

PATHFINDER SURVEYING
FORMERLY KOLB LAND CONSULTING
929 WILLIAMS ST. LAKE GENEVA, WI.
(414) 248-3697

ORDERED BY : AL BETKER
P.O. BOX 925
DELAVAN, WI. 53115

DATE: 9/19/1997


LEGEND

⊙ FOUND IRON PIPE

● SET 1 IN. IRON PIPE

—X— FENCE

SCALE 1"= 20'

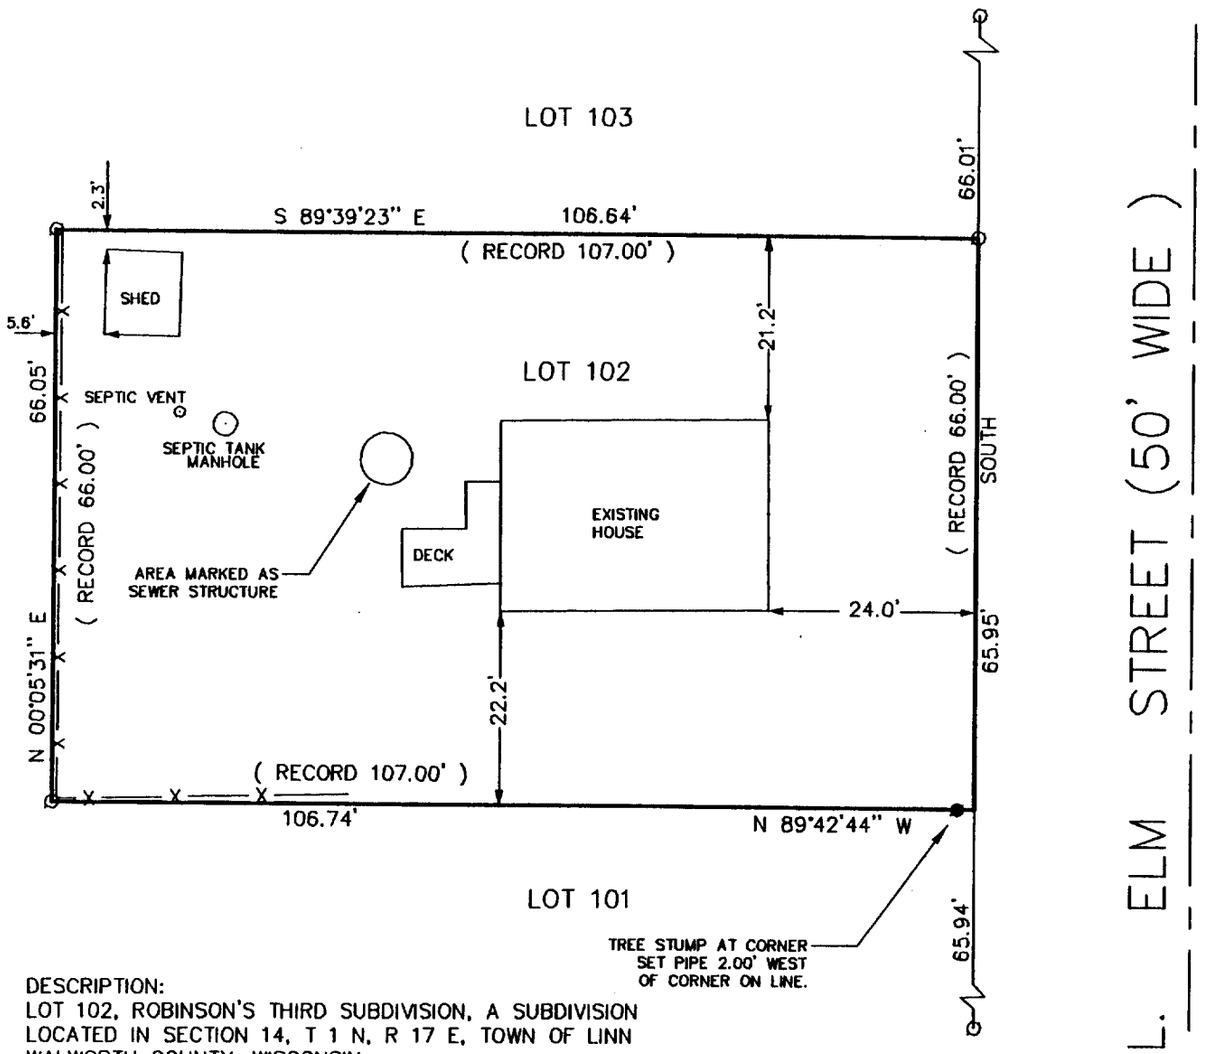


DESCRIPTION:
LOT 102, ROBINSON'S THIRD SUBDIVISION, A SUBDIVISION LOCATED IN SECTION 14, T 1 N, R 17 E, TOWN OF LINN WALWORTH COUNTY, WISCONSIN.

NOTE: NO BEARINGS ON SURVEYS OF RECORD CENTER LINE OF ELM STREET TAKEN TO BE NORTH.

RECEIVED
OCT 16 1997

THE ABOVE MAP IS A TRUE REPRESENTATION THEREOF AND SHOWS THE SIZE AND LOCATION OF ALL THE PROPERTY, EXTERIOR BOUNDARIES, THE LOCATION OF ALL VISIBLE BOUNDARY FENCES , APPARENT EASEMENTS , ROADWAYS AND VISIBLE ENCROACHMENTS , IF ANY.

THIS SURVEY IS MADE FOR THE USE OF THE PRESENT OWNERS OF THE PROPERTY , AND ALSO THOSE WHO PURCHASE , MORTGAGE OR GURANTEE TITLE THERETO WITHIN ONE (1) YEAR FROM DATE HERETO.

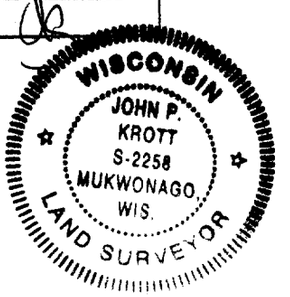

John P Krott

JOHN P. KROTT , R.L.S. 2258

NOTE: THIS IS NOT A CERTIFIED COPY UNLESS SEAL IS IN RED.

JOB NUMBER 97076/1-17-IRB3-80

IRB3-80