
PLAT OF SURVEY

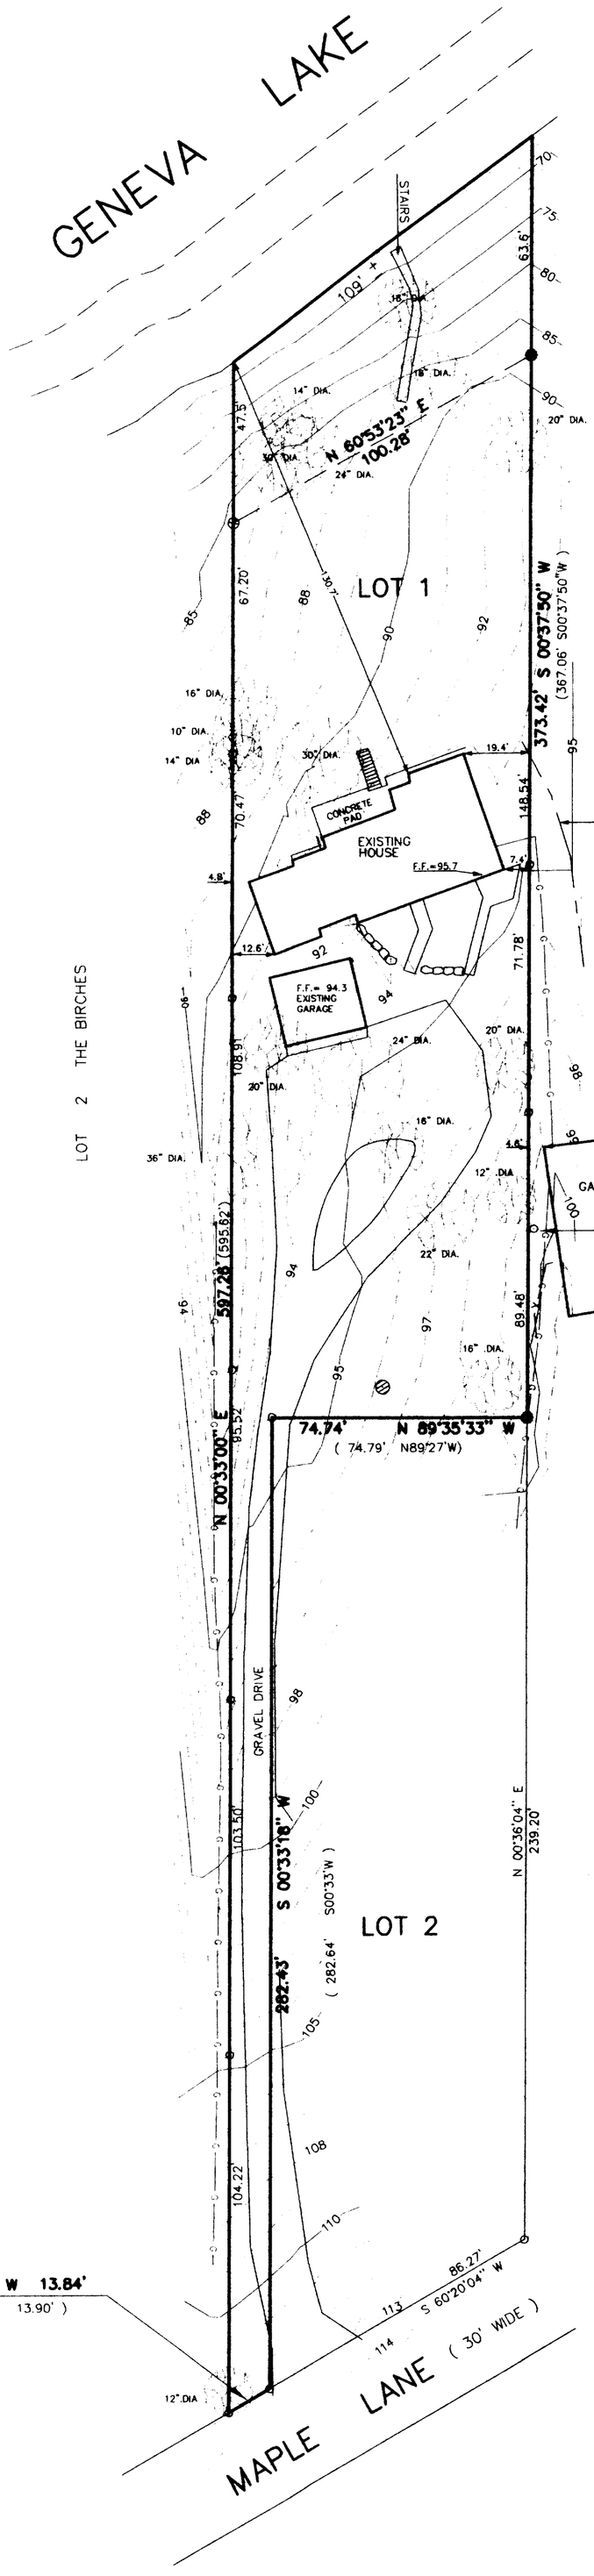

SCALE 1" = 30'

DESCRIPTION:

LOT 1 OF CERTIFIED SURVEY NO. 1086 LOCATED IN THE NORTHWEST 1/4 OF SECTION 10, TOWN 1 NORTH , RANGE 17 EAST , WALWORTH COUNTY , WISCONSIN.

LEGEND

⊕	FOUND 5" DIA. CONCRETE MONUMENT
o	FOUND 1" DIA. IRON PIPE
●	FOUND 3/4" REBAR
⊘	SOIL BORING
——x——	FENCE
——G——	GAS LINE
(XXXX)	RECORDED AS
FF	FINISH FLOOR ELEVATION
o	UTILITY POLE

RECEIVED
MAR 27 1998

THE ABOVE MAP IS A TRUE REPRESENTATION THEREOF AND SHOWS THE SIZE AND LOCATION OF ALL THE PROPERTY, EXTERIOR BOUNDARIES, THE LOCATION OF ALL VISIBLE BOUNDARY FENCES , APPARENT EASEMENTS , ROADWAYS AND VISIBLE ENCROACHMENTS , IF ANY.

THIS SURVEY IS MADE FOR THE USE OF THE PRESENT OWNERS OF THE PROPERTY , AND ALSO THOSE WHO PURCHASE , MORTGAGE OR GURANTEE TITLE THERETO WITHIN ONE (1) YEAR FROM DATE HERETO.

WISCONSIN JOHN P. KROTT S-2258 MUKWONAGO, WIS. LAND SURVEYOR

John P Krott
JOHN P. KROTT , R.L.S. 2258

DATE: 2 / 26 / 1998

NOTE: THS IS NOT A CERTIFIED COPY UNLESS SEAL IS IN RED.

IA-1086-1
117-1704

ORDERED BY:
REMAX GENEVA REALTY LTD
101 BROAD STREET
LAKE GENEVA , WI. 53147

PATHFINDER SURVEYING
FORMERLY KOLB LAND CONSULTING, INC.
929 WILLIAMS STREET, LAKE GENEVA WISCONSIN. 53147
(414) 248-3697

JOB NUMBER 1-17-IA108600001 98010