PLAT OF SURVEY

PATHFINDER SURVEYING
FORMERLY KOLB LAND CONSULTING
929 WILLIAMS STREET LAKE GENEVA, WI. 53147
(414) 248-3697


ORDERED BY:

DATE: 6/15/1998

KEEFE REAL ESTATE, INC. 751 GENEVA PKWY LAKE GENEVA WISCONSIN

DESCRIPTION:

LOTS 24 AND 25 OF ROBINSON'S SUBDIVISON LOCATED IN T1N, R17E, TOWN OF LYNN, WALWORTH COUNTY, WISCONSIN

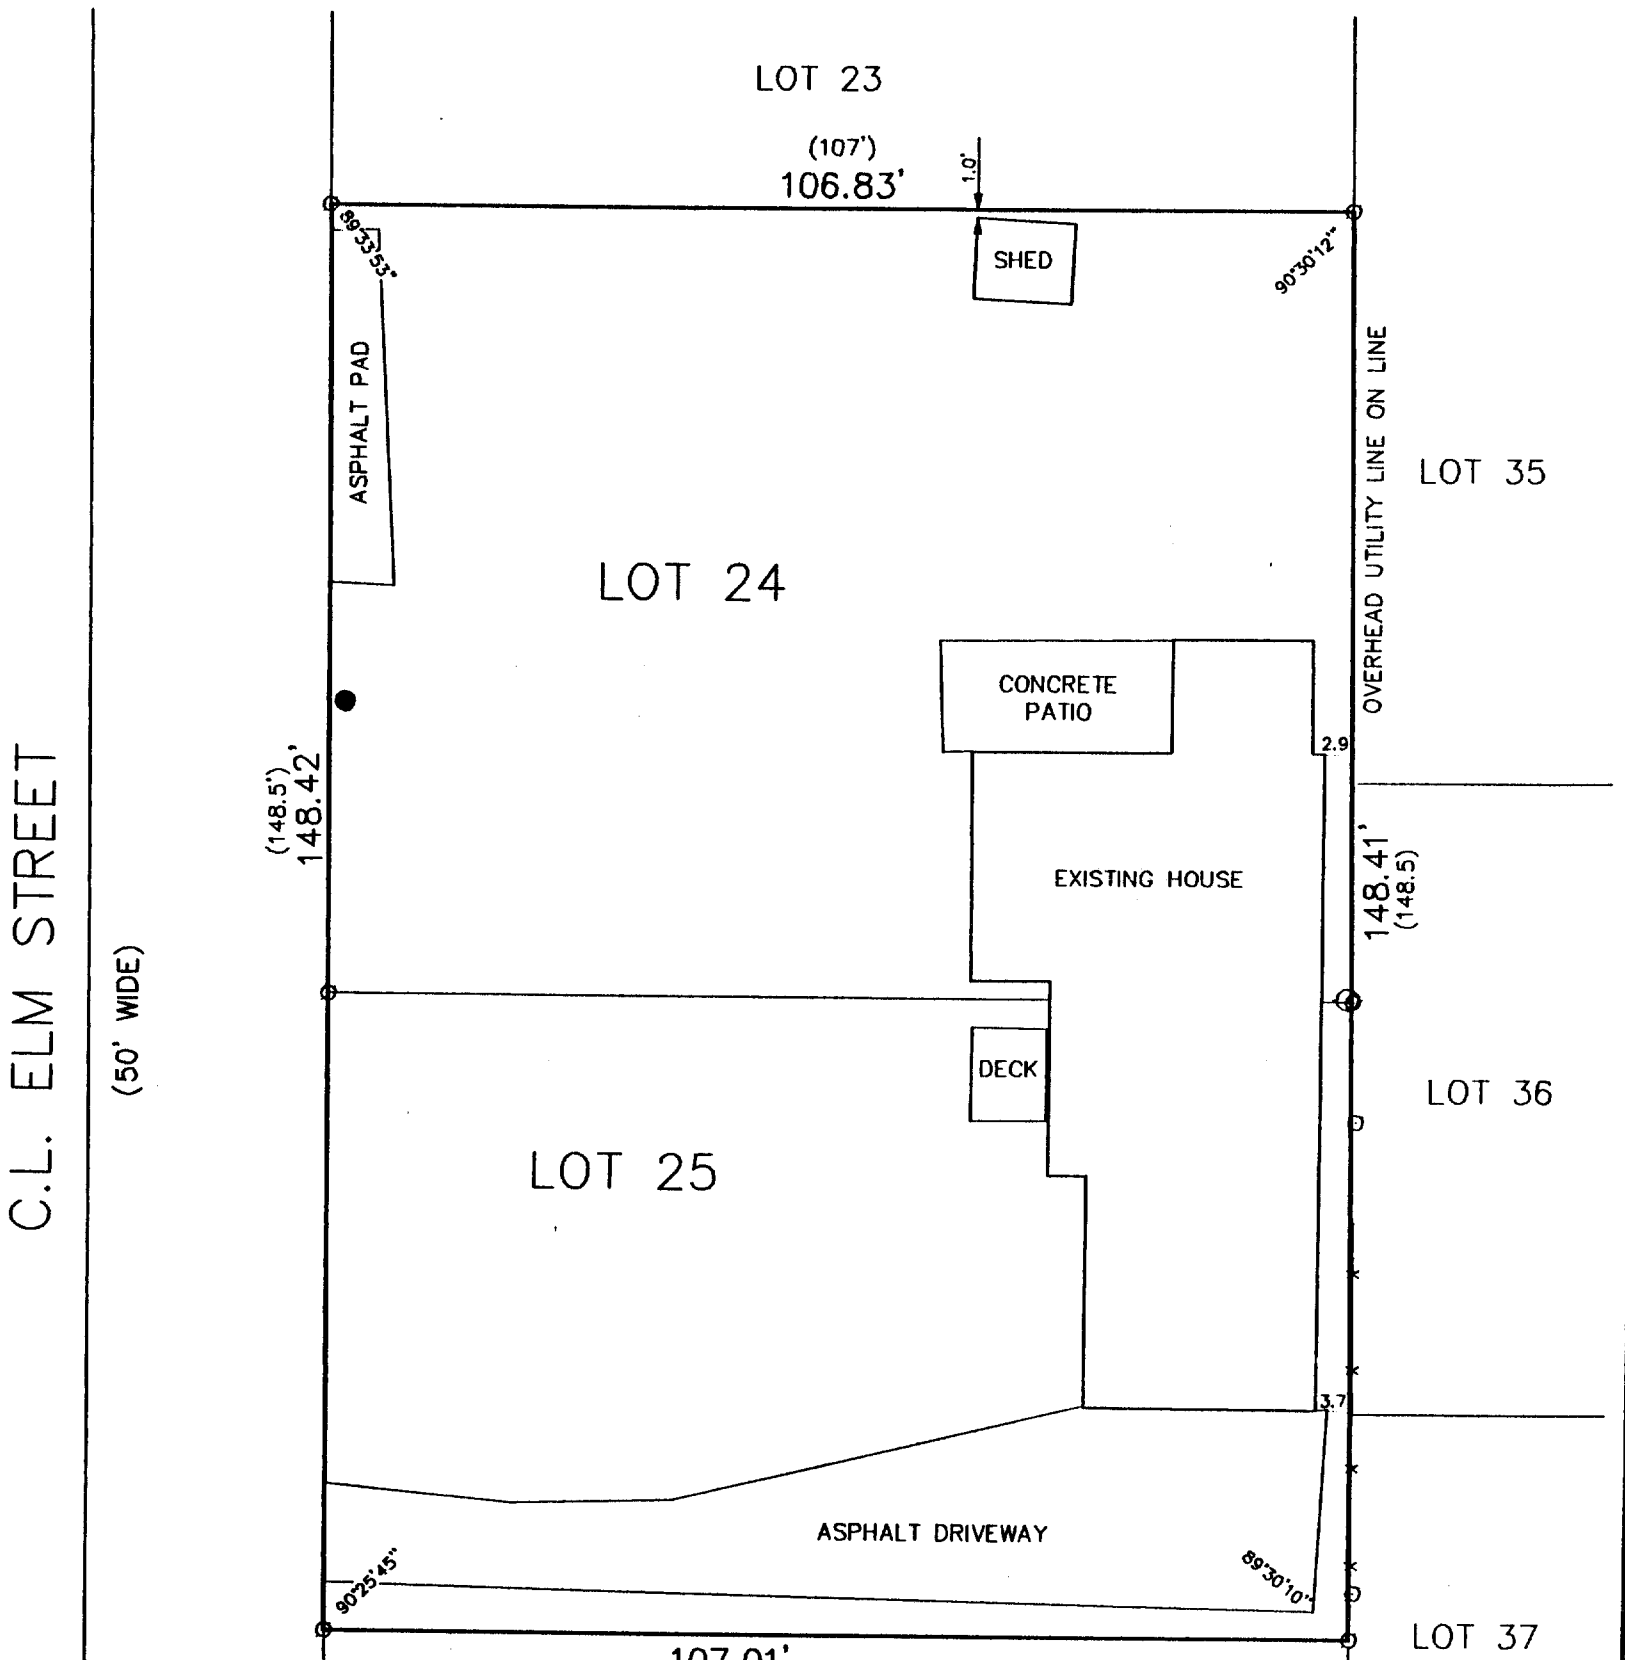

RECEIVED
AUG 4 1998

THE ABOVE MAP IS A TRUE REPRESENTATION THEREOF AND SHOWS THE SIZE AND LOCATION OF ALL THE PROPERTY, EXTERIOR BOUNDARIES, THE LOCATION OF ALL VISIBLE BOUNDARY FENCES , APPARENT EASEMENTS , ROADWAYS AND VISIBLE ENCROACHMENTS , IF ANY

THIS SURVEY IS MADE FOR THE USE OF THE PRESENT OWNERS OF THE PROPERTY , AND ALSO THOSE WHO PURCHASE , MORTGAGE OR GURANTEE TITLE THERETO WITHIN ONE (1) YEAR FROM DATE HERETO.

John P Krott

JOHN P. KROTT , R.L.S. 2258

SCALE 1" = 20'

LEGEND

- ⊙ FOUND IRON PIPE
- —x— FENCE
- ⊙ POWER POLE
- ● WATER WELL
- (XXXX) RECORDED AS

WISCONSIN
JOHN P. KROTT
S-2258
MUKWONAGO, WIS.
LAND SURVEYOR

NOTE: THIS IS NOT A CERTIFIED COPY UNLESS SEAL IS IN RED.

JOB NUMBER 98100 1-17- IRB 100019

IRB1-19
117-1720