PLAT OF SURVEY

PATHFINDER SURVEYING
FORMERLY KOLB LAND CONSULTING
929 WILLIAMS STREET LAKE GENEVA, WI. 53147
(414) 248-3697


ORDERED BY:

LAKE GENEVA PROPERTIES
520 BROAD ST.
LAKE GENEVA, WI.
53147

DATE: 7 / 17 / 1998

DESCRIPTION:

THE NORTH 1/2 OF LOT 19 AND ALL OF LOTS 20 AND 21, IN BLOCK 7 OF MAPLE HILLS "A" SUBDIVISION LOCATED IN SECTION 18 , TOWN 1 NORTH , RANGE 17 EAST, TOWN OF LINN , WALWORTH COUNTY , WISCONSIN.

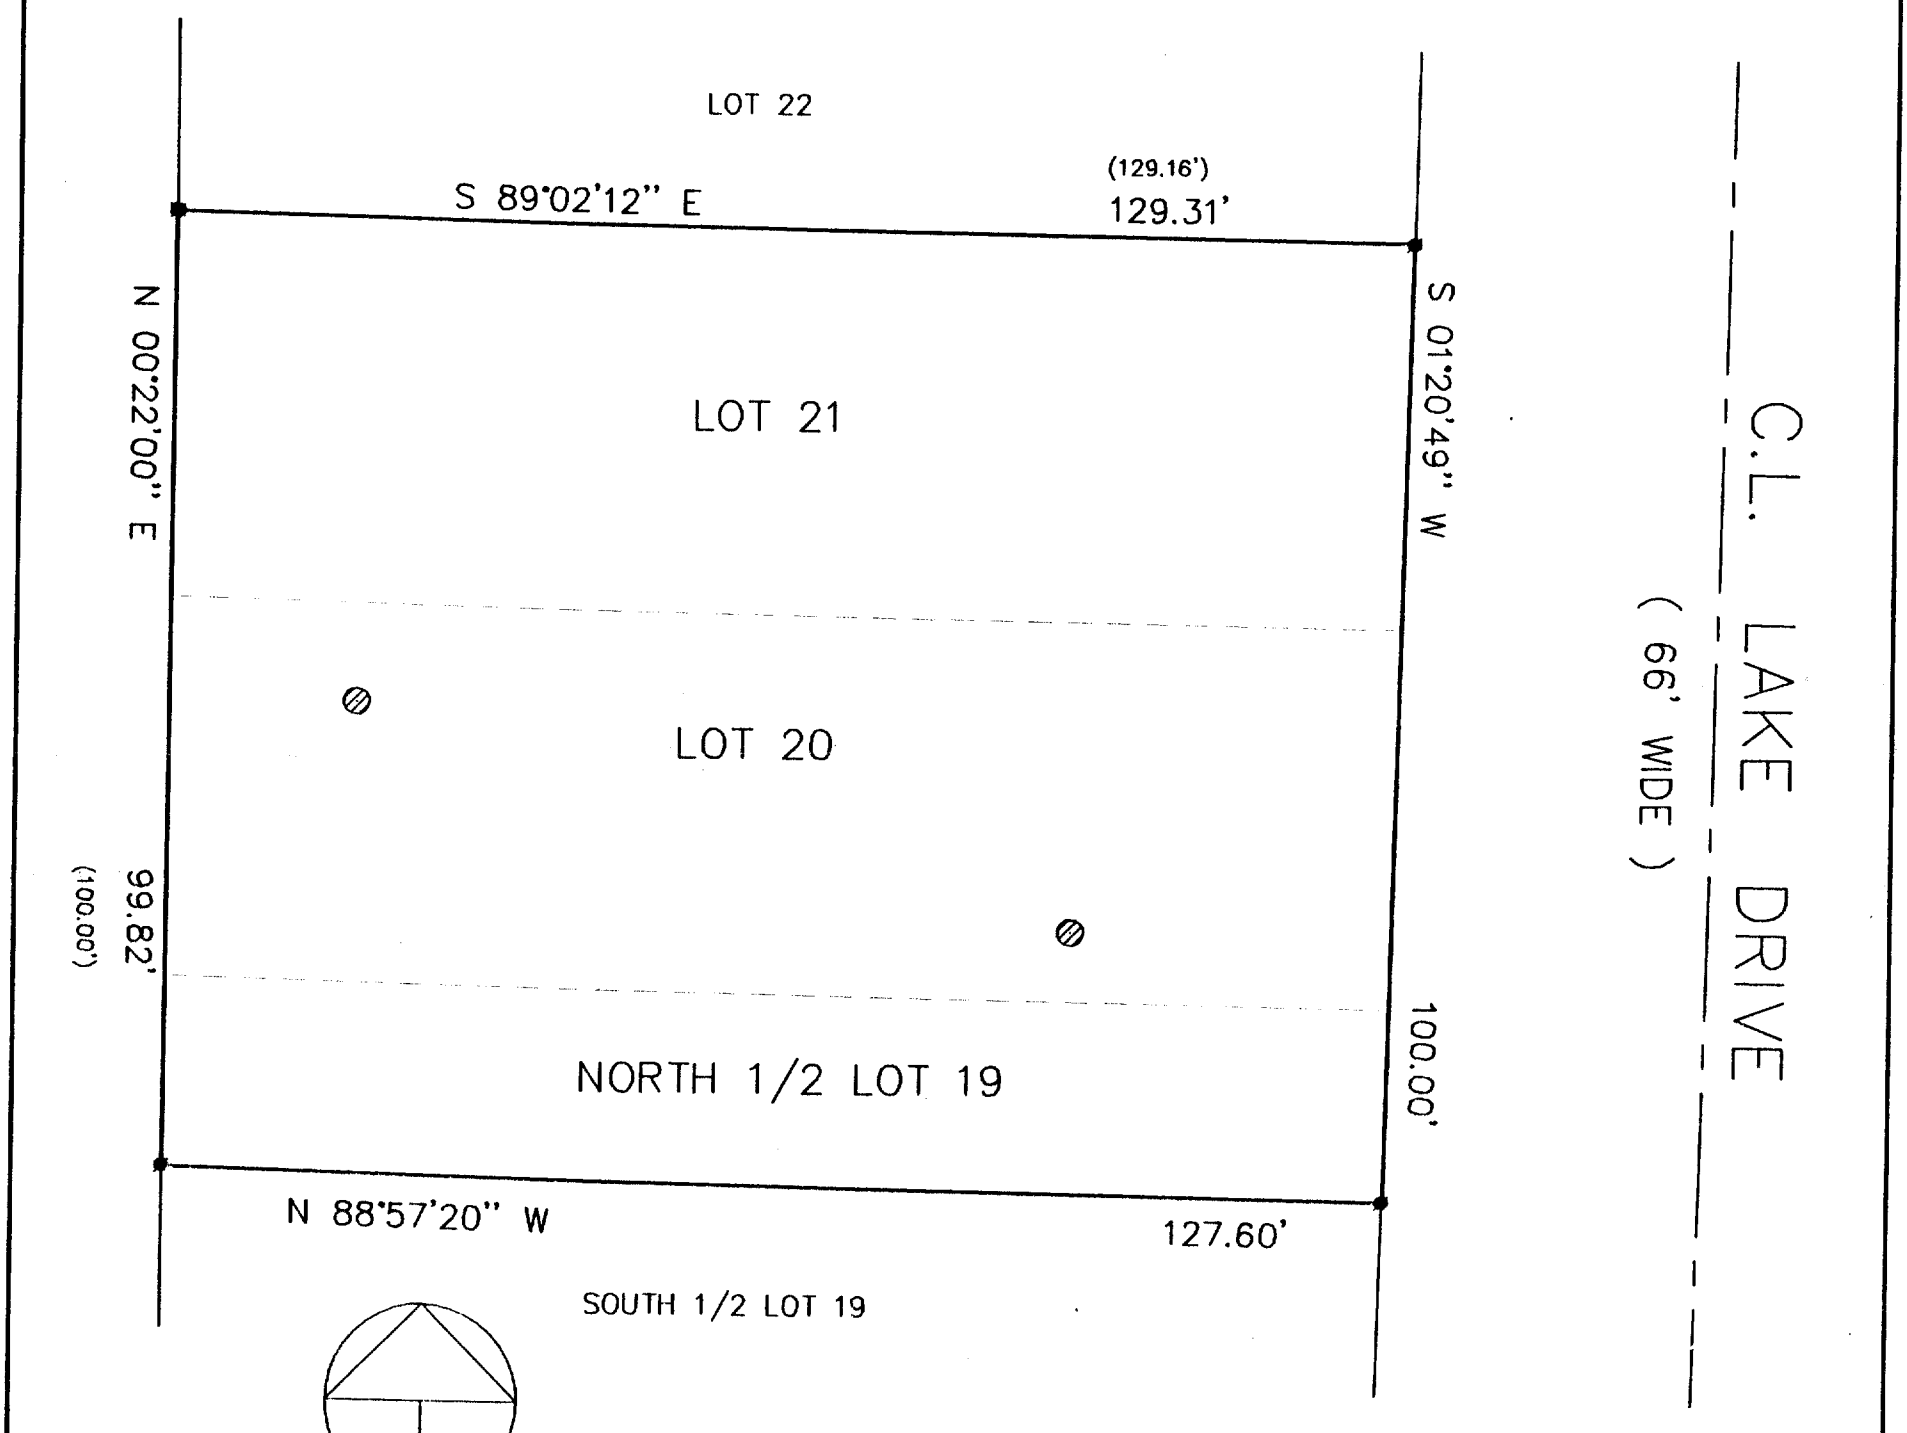

LEGEND

- ● FOUND IRON ROD
- ● SET IRON PIPE
- (XXXX) RECORDED AS
- ⊘ SOIL BORING

THE ABOVE MAP IS A TRUE REPRESENTATION THEREOF AND SHOWS THE SIZE AND LOCATION OF ALL THE PROPERTY, EXTERIOR BOUNDARIES, THE LOCATION OF ALL VISIBLE BOUNDARY FENCES , APPARENT EASEMENTS , ROADWAYS AND VISIBLE ENCROACHMENTS , IF ANY

THIS SURVEY IS MADE FOR THE USE OF THE PRESENT OWNERS OF THE PROPERTY , AND ALSO THOSE WHO PURCHASE , MORTGAGE OR GURANTEE TITLE THERETO WITHIN ONE (1) YEAR FROM DATE HERETO.

John P Krott

JOHN P. KROTT , R.L.S. 2258

RECEIVED
AUG 4 1998

WISCONSIN
JOHN P. KROTT
S-2258
MUKWONAGO, WIS.
LAND SURVEYOR

NOTE: THIS IS NOT A CERTIFIED COPY UNLESS SEAL IS IN RED.

JOB NUMBER: 98119 1-17-IMH00189

IMH - 189
117-1721