

PLAT OF SURVEY

LOTS 4, 5, 6 & 7 OF BLOCK 17
WOODALE ADDITION SUBDIVISION

LOCATED IN THE EAST 1/2 OF THE NORTHWEST 1/4
SECTION 16, TOWN 1 NORTH, RANGE 16 EAST,
TOWN OF LINN, WALWORTH COUNTY, WISCONSIN

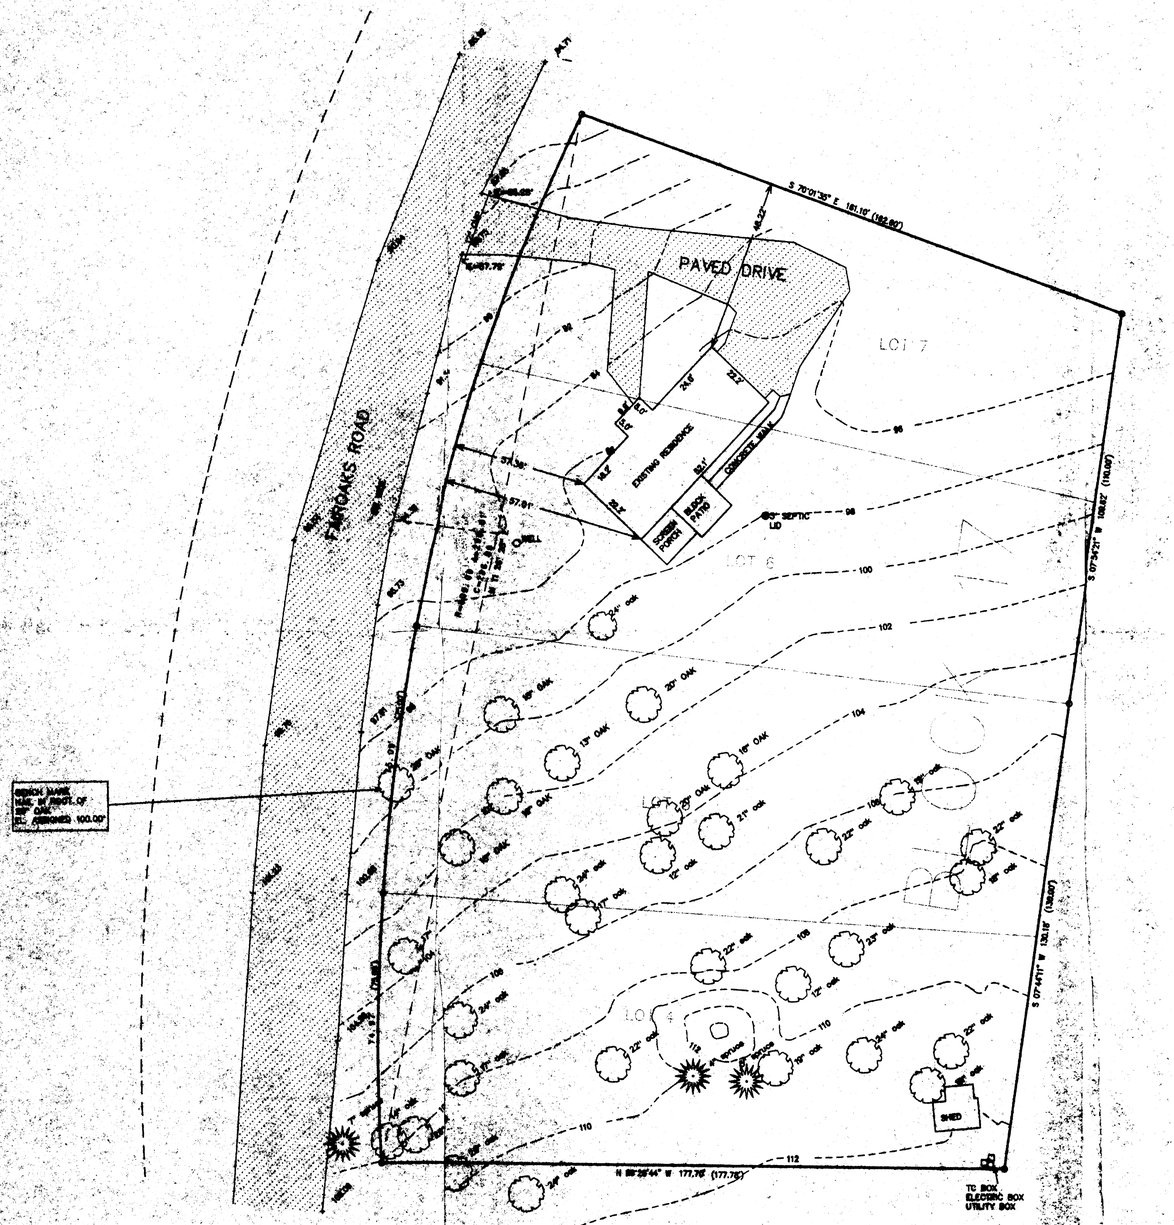

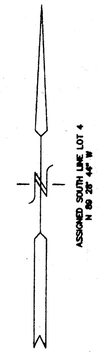

LEGEND

O = FOUND IRON PIPE

(XXX) = RECORDED AS

10 5 0 10 20 30 40 50 60 70 80 90 100
MAP SCALE IN FEET ORIGINAL 1" = 20'

NOTE: COPIES OF THIS MAP TO WHICH THE FOLLOWING CERTIFICATE WILL APPLY ARE BLUE-LINE PRINTS SHOWING SURVEYOR'S ORIGINAL SEAL AND SIGNATURE IN BLACK INK. OTHER OR ANY FURTHER OR MASTERS ALTERATIONS WHICH DO NOT REPRESENT THE SURVEYOR'S WORK PRODUCT.

I HEREBY CERTIFY THAT THE ABOVE DESCRIBED PROPERTY HAS BEEN SURVEYED UNDER MY DIRECTION AND THAT THE ABOVE MAP IS A TRUE REPRESENTATION THEREOF AND SHOWS THE SIZE AND LOCATION OF THE PROPERTY AND ITS EXTERIOR BOUNDARIES. THIS SURVEY IS MADE FOR THE USE OF THE PRESENT OWNERS OF THE PROPERTY, AND ALSO THOSE WHO PURCHASE, MORTGAGE, OR GUARANTEE THE TITLE THERETO WITHIN ONE YEAR FROM THE DATE HEREOF.

DATED: 9-8-98

PETER S. GORDON S-2101

WISCONSIN PETER S. GORDON S-2101 ELKHORN, WI LAND SURVEYOR

RECEIVED SEP 2 1998

WORK ORDERED BY:
ARTHUR & MARILYN AUSTIN
N 1538 FAIR OAKS ROAD
LAKE GENEVA, WI 53147

PARKS, HANSEN & ASSOCIATES, INC.
Engineering, Architecture, Surveying
7 Ridgeway Court P.O. Box 437
ELKHORN, WISCONSIN 53121
Office: (414) 723-2648
Fax: (414) 723-5866

Project no.	5072
Date	8/6/98
Sheet no.	1 OF 1