
PLAT OF SURVEY

LOT 13 OF LAKE GENEVA BEACH

LOCATED IN SECTION 11, TOWN 1 NORTH, RANGE 17 EAST,
WALWORTH COUNTY, WISCONSIN

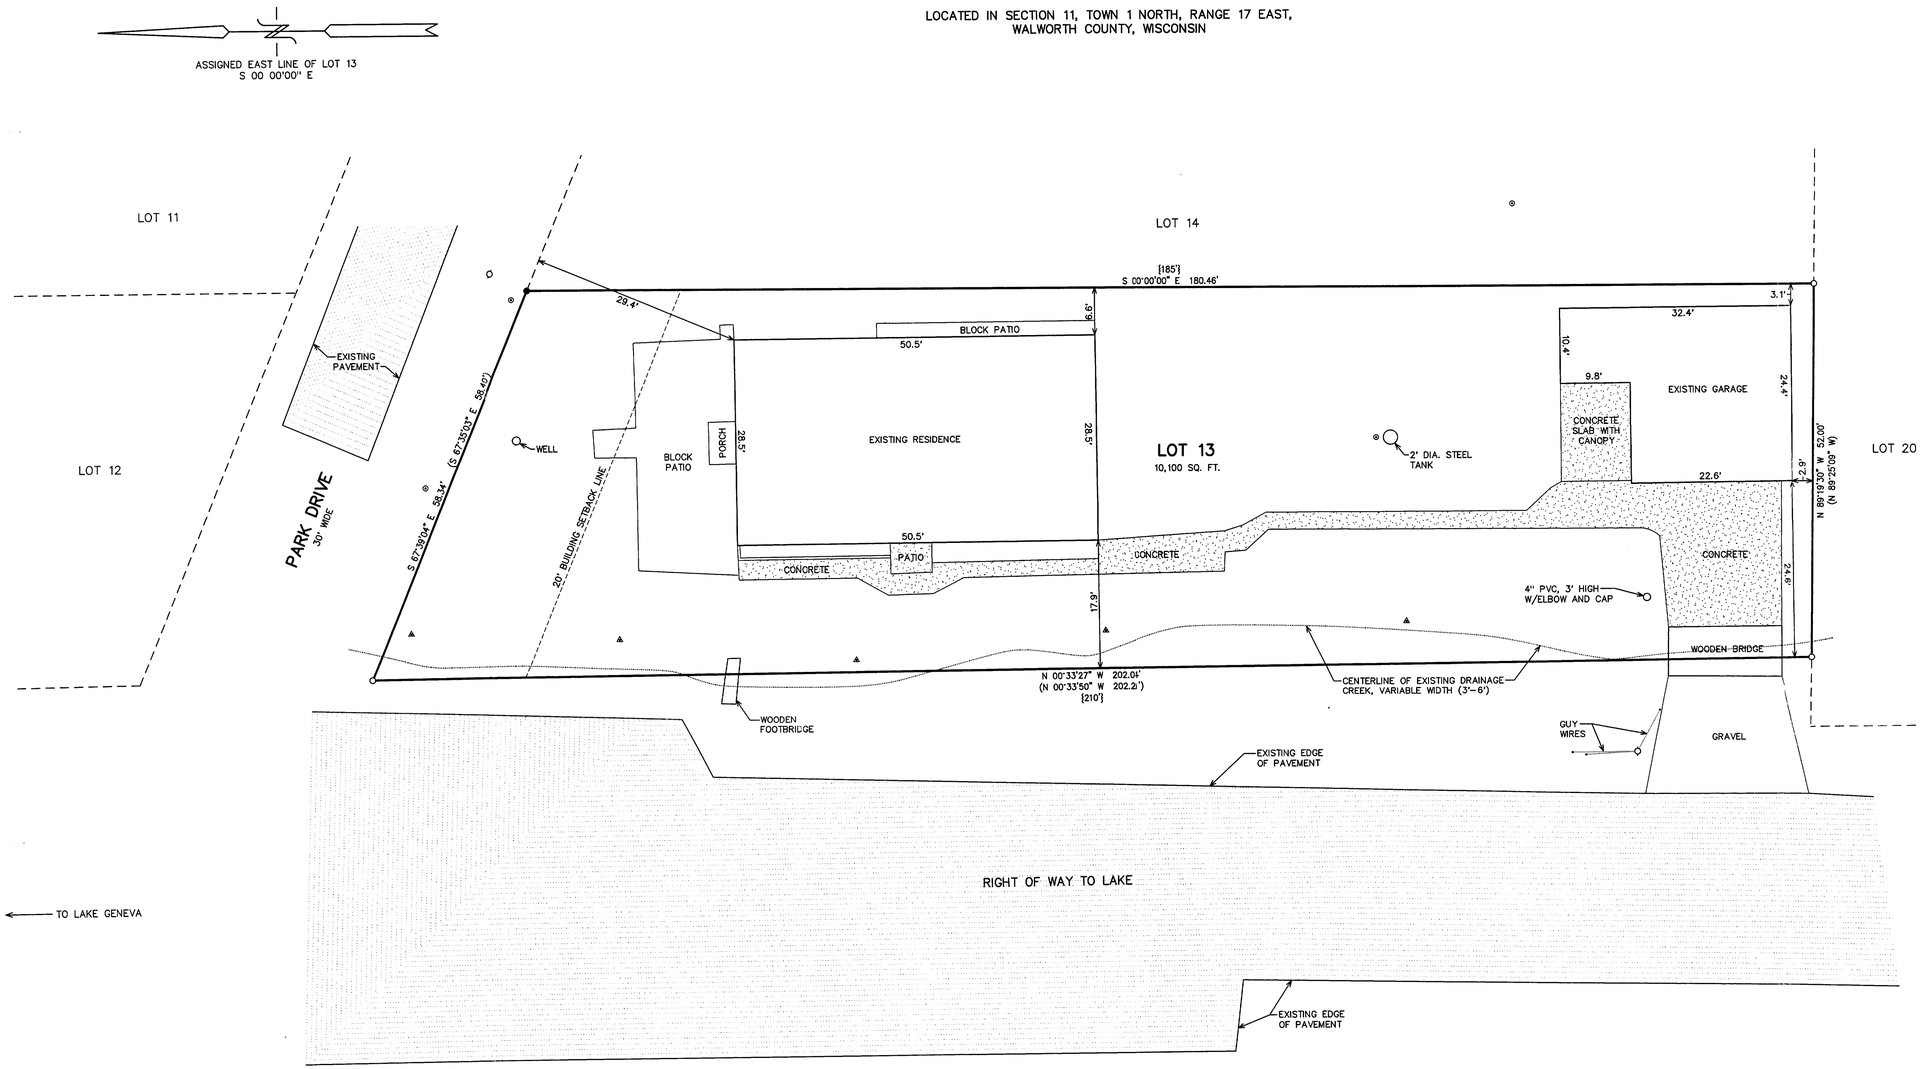

LEGEND

- ○ = FOUND IRON PIPE STAKE
- ● = FOUND CONCRETE MONUMENT WITH 1/8" IRON PIN
- ◇ = UTILITY POLE LOCATED
- ▲ = YARD LIGHT LOCATED
- ⊙ = CAPPED PVC PIPE FOUND (POSSIBLE VENT)
- (XXX) = RECORD DIMENSION FROM SURVEY BY G.T. DUNHAM, 1/29/1982.
- {XXX} = RECORD DIMENSION FROM TAX MAP

5 0 5 10 15 20 25 30 35 40 45 50
MAP SCALE IN FEET ORIGINAL 1" = 10'

NOTE: COPIES OF THIS MAP TO WHICH THE FOLLOWING CERTIFICATE WILL APPLY SHOW THE SURVEYOR'S ORIGINAL SEAL AND SIGNATURE IN RED INK. COPIES BY ANY OTHER MEANS MAY HAVE ALTERATIONS WHICH DO NOT REPRESENT THE SURVEYOR'S WORK PRODUCT.

I HEREBY CERTIFY THAT THE ABOVE DESCRIBED PROPERTY HAS BEEN SURVEYED UNDER MY DIRECTION AND THAT THE ABOVE MAP IS A TRUE REPRESENTATION THEREOF AND SHOWS THE SIZE AND LOCATION OF THE PROPERTY AND ITS EXTERIOR BOUNDARIES. THIS SURVEY IS MADE FOR THE USE OF THE PRESENT OWNERS OF THE PROPERTY, AND ALSO THOSE WHO PURCHASE, MORTGAGE, OR GUARANTEE THE TITLE THERETO WITHIN ONE YEAR FROM THE DATE HEREOF.

DATED: 12/9/98

PETER S. GORDON R.L.S. 2101

WISCONSIN PETER S. GORDON S-2101 ELKHORN, WI LAND SURVEYOR

RECEIVED DEC 28 1998

ILCB-9 117-1765

PLAT OF SURVEY
LOT 13 OF LAKE GENEVA BEACH
TOWN OF LINN
WALWORTH COUNTY, WISCONSIN

– WORK ORDERED BY –
JOHN BARKEN
CHRIS HUGHES
P.O. BOX 877
WILLIAMS BAY, WISCONSIN 53191

FARRIS, HANSEN & ASSOCIATES, INC.
Engineering, Architecture, Surveying
7 Ridgway Court P.O. Box 437
ELKHORN, WISCONSIN 53121
Office: (414) 723-2098
Fax: (414) 723-5886

REVISIONS

PROJECT NO. 5171
DATE 12/09/98
SHEET NO. 1 OF 1