FARRIS, HANSEN & ASSOCIATES, INC.


ENGINEERING, ARCHITECTURE, SURVEYING

7 RIDGEWAY COURT – P.O. BOX 437, ELKHORN, WISCONSIN, 53121

PHONE: (414) 723-2098 FAX: (414) 723-5886

10 5 0 10 20 30 40 50 60 70 80 90 100

MAP SCALE IN FEET ORIGINAL 1" = 20'

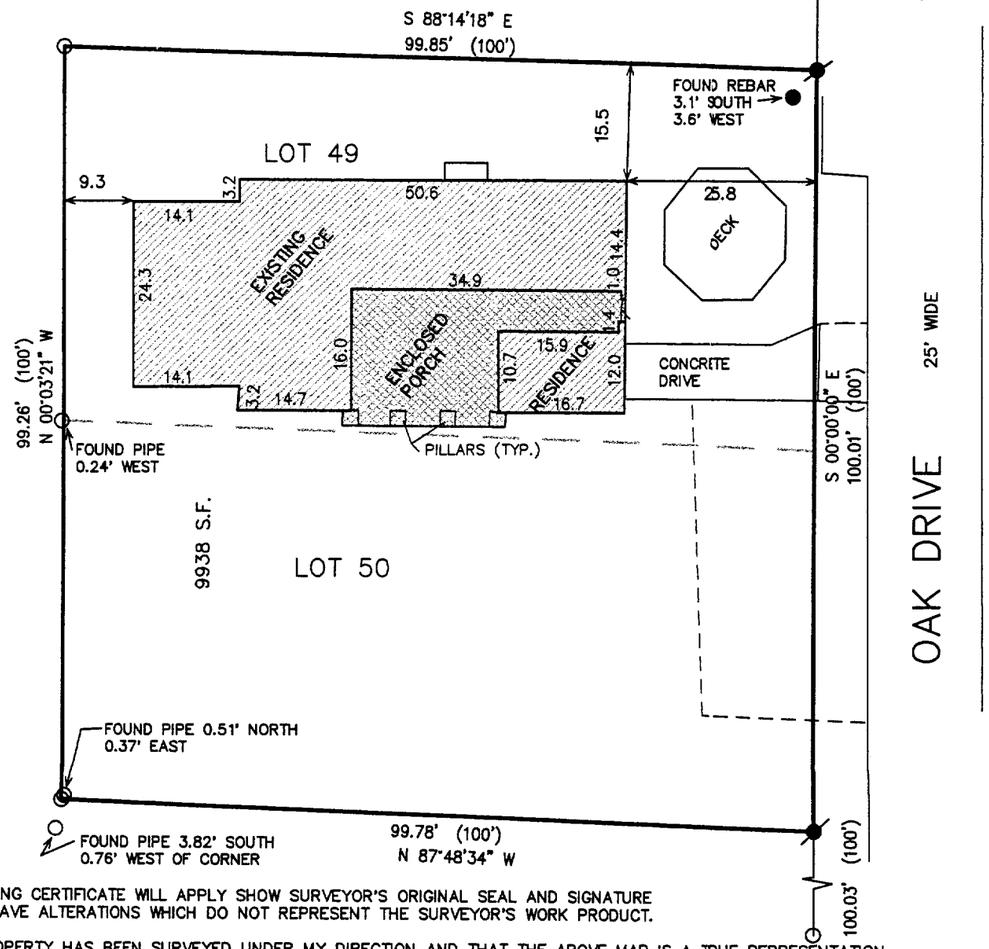

PLAT OF SURVEY
LOTS 49 & 50
EDGEWATER TERRACE

LOCATED IN PART OF SEC. 9, T1N, R17E
WALWORTH COUNTY, WISCONSIN

PETER S. GORDON S-2101 ELKHORN, WI LAND SURVEYOR

RECEIVED JUN 26 1999

ASSIGNED SOUTH LINE LOT 15 BLOCK 1 N 90 00' E

WORK ORDERED BY:
THE RAULAND AGENCY
118 KENOSHA STREET
WALWORTH, WISCONSIN 53184

NOTE: COPIES OF THIS MAP TO WHICH THE FOLLOWING CERTIFICATE WILL APPLY SHOW SURVEYOR'S ORIGINAL SEAL AND SIGNATURE IN RED INK. COPIES BY ANY OTHER MEANS MAY HAVE ALTERATIONS WHICH DO NOT REPRESENT THE SURVEYOR'S WORK PRODUCT.

I HEREBY CERTIFY THAT THE ABOVE DESCRIBED PROPERTY HAS BEEN SURVEYED UNDER MY DIRECTION AND THAT THE ABOVE MAP IS A TRUE REPRESENTATION THEREOF AND SHOWS THE SIZE AND LOCATION OF THE PROPERTY AND ITS EXTERIOR BOUNDARIES. THIS SURVEY IS MADE FOR THE USE OF THE PRESENT OWNERS OF THE PROPERTY, AND ALSO THOSE WHO PURCHASE, MORTGAGE, OR GUARANTEE THE TITLE THERETO WITHIN ONE YEAR FROM THE DATE HEREOF.

DATED: 6-21-99

PETER S. GORDON R.L.S. 2101

LEGEND
- ○ = FOUND IRON PIPE STAKE 1" DIA.
- ◐ = SET IRON REBAR STAKE
- ● = FOUND IRON REBAR STAKE
- (XXX) = RECORDED AS

PROJECT 5311

SHEET 1 OF 1

JUN 21 1999

117-1793 IE-45