# PLAT OF SURVEY


PATHFINDER SURVEYING
FORMERLY KOLB LAND CONSULTING
929 WILLIAMS ST. LAKE GENEVA, WI.
(262) 248-3697

ORDERED BY : DOMINIC & LORETTA RUSKEY
244 MONSON CT.
SCHAUMBURG , IL
60173

DATE: 4-14-2000

## DESCRIPTION

LOT 2 BLOCK 3 ROWENA PARK A SUBDIVISION LOCATED IN SECTION 5, TOWN 1 NORTH , RANGE 17 EAST , WALWORTH COUNTY, WISCONSIN.

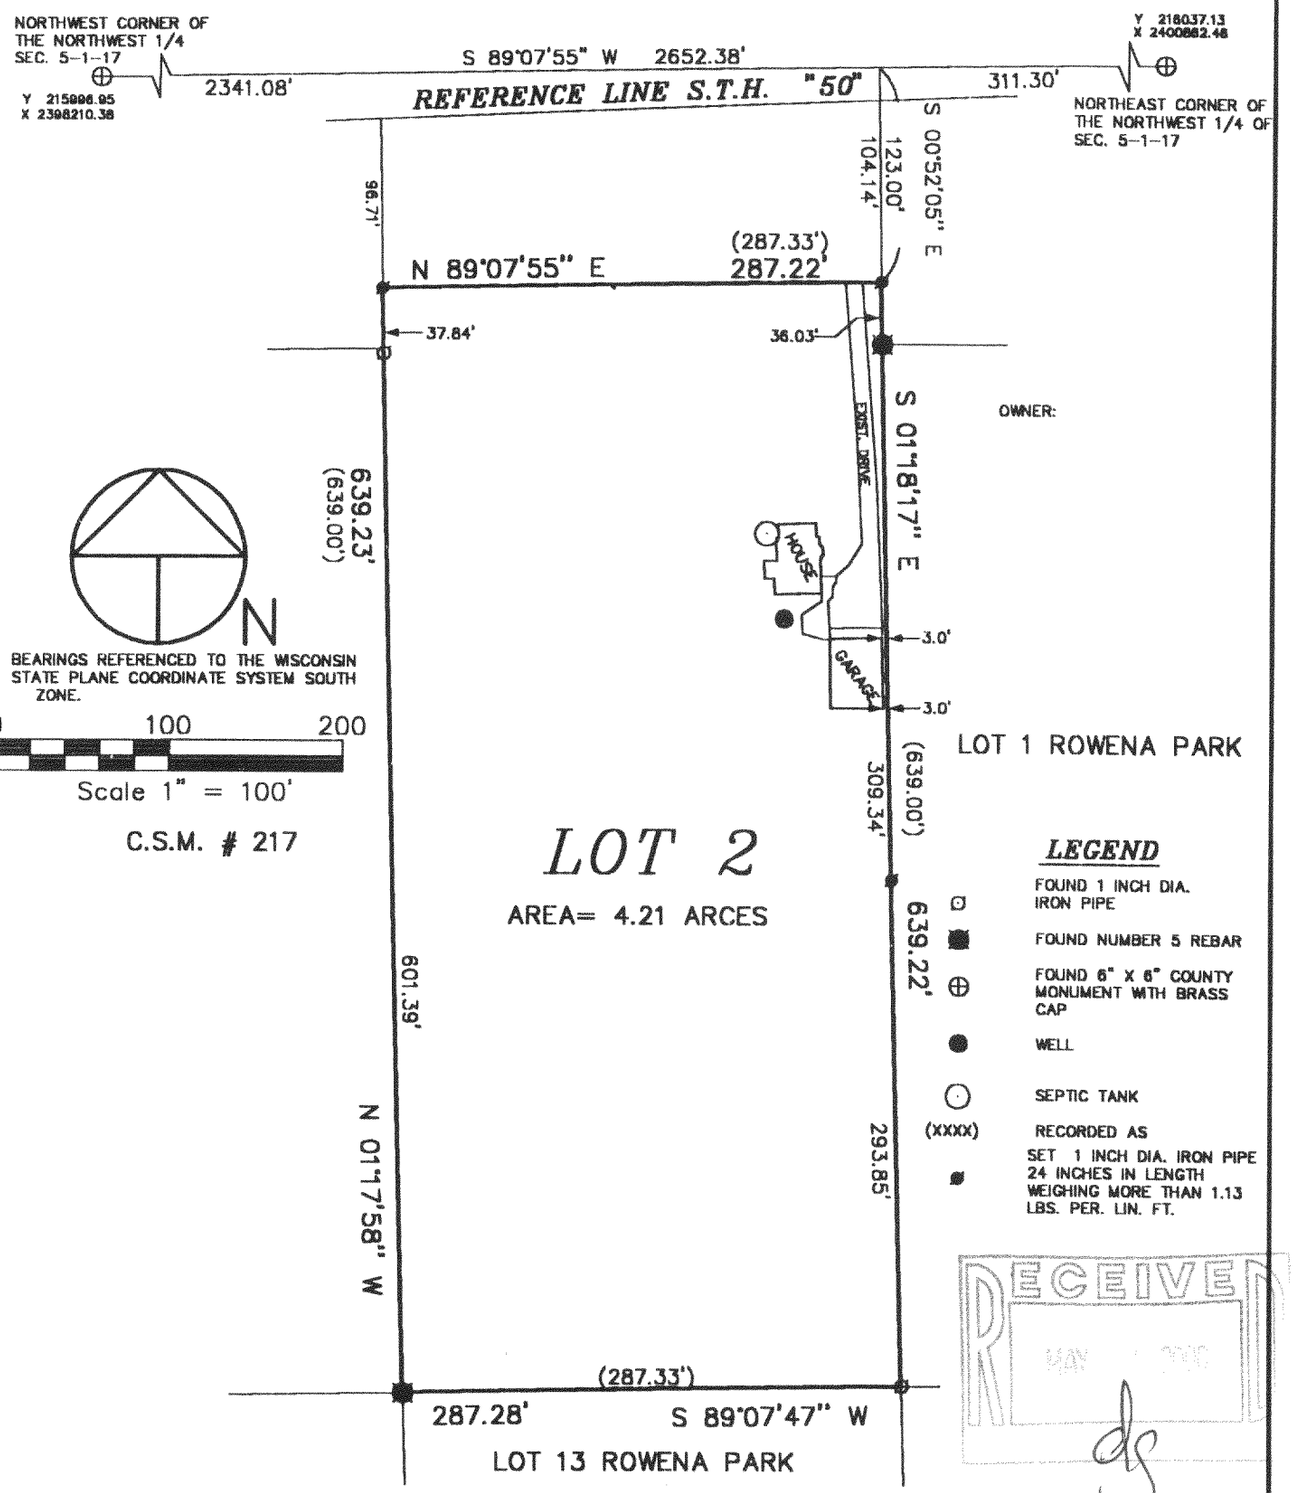


### LEGEND

- FOUND 1 INCH DIA. IRON PIPE
- FOUND NUMBER 5 REBAR
- FOUND 6" X 6" COUNTY MONUMENT WITH BRASS CAP
- WELL
- SEPTIC TANK
- (XXXX) RECORDED AS
- SET 1 INCH DIA. IRON PIPE 24 INCHES IN LENGTH WEIGHING MORE THAN 1.13 LBS. PER. LIN. FT.

RECEIVED
MAY

THE ABOVE MAP IS A TRUE REPRESENTATION THEREOF AND SHOWS THE SIZE AND LOCATION OF ALL THE PROPERTY, EXTERIOR BOUNDARIES, THE LOCATION OF ALL VISIBLE BOUNDARY FENCES , APPARENT EASEMENTS , ROADWAYS AND VISIBLE ENCROACHMENTS , IF ANY.

THIS SURVEY IS MADE FOR THE USE OF THE PRESENT OWNERS OF THE PROPERTY , AND ALSO THOSE WHO PURCHASE , MORTGAGE OR GURANTEE TITLE THERETO WITHIN ONE (1) YEAR FROM DATE HERETO.

JOHN P. KROTT , R.L.S. 2258

WISCONSIN JOHN P. KROTT S-2258 MUKWONAGO, WIS. LAND SURVEYOR

NOTE: THIS IS NOT A CERTIFIED COPY UNLESS SEAL IS IN RED.

JOB NUMBER 99288- 1-17-IRB-32B

117-1871

IRB-32B