**ABERNATHY and ASSOCIATES**
Kenneth B. Abernathy Jr.
Wisconsin Registered Land Surveyor S-1594


W4056 BRAY RD.
ELKHORN, WI. 53121
PHONE: (262) 723-4260 (OFFICE)
(262) 723-7209 (FAX)
Email: abernathy@elknet.net

**PLAT OF SURVEY**

RECEIVED
AUG 3 0 2000

*A TOPOGRAPHICAL SURVEY OF PART OF TAX KEY NOS. IH 00006 AND IL 300002, LOCATED IN THE NORTHEAST 1/4 OF SECTION 3, TOWN 1 NORTH, RANGE 17 EAST, TOWN OF LINN, WALWORTH COUNTY, WISCONSIN*

*OWNER: WILLIAM WRIGLEY JR.*
*410 N. MICHIGAN AVE. RM 1600*
*CHICAGO. IL. 60611*

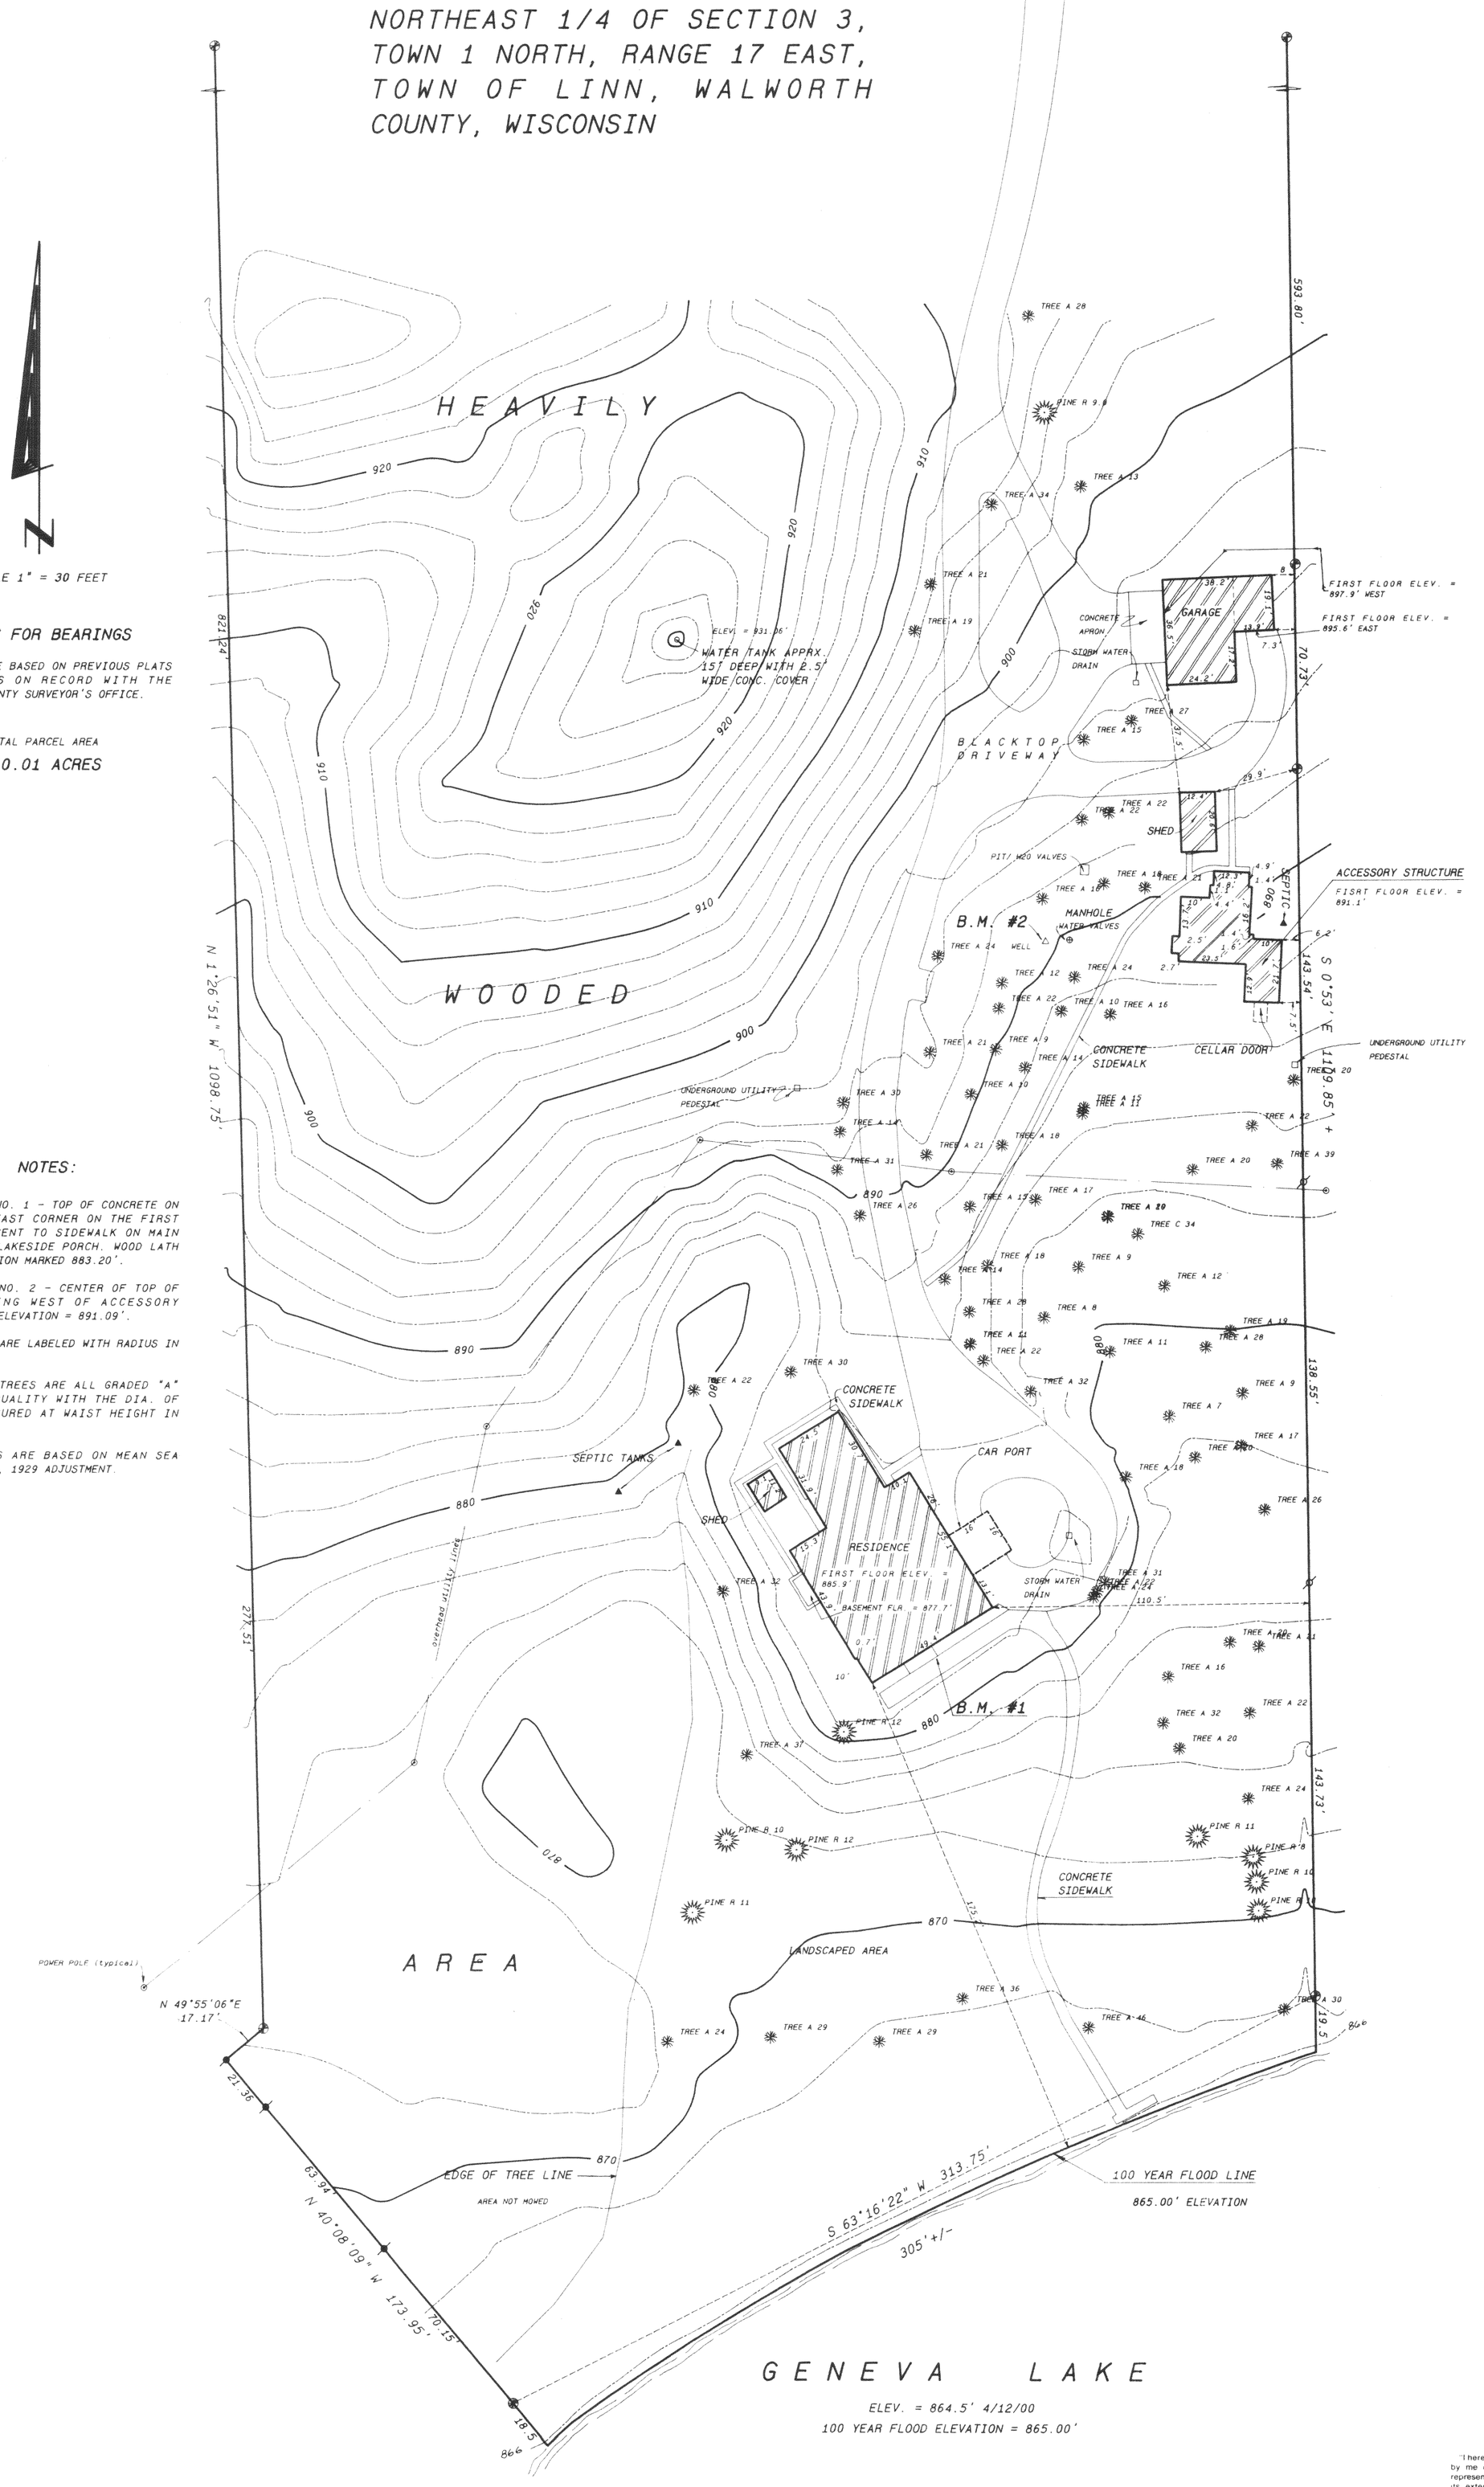


**SCALE: 1"= 30 FEET**

"I hereby certify that the above described property has been surveyed by me or under my direction and that the above map is a true representation thereof and shows the size and location of the property, its exterior boundaries, the location of all visible structures and dimensions of all principal buildings thereon, boundary fences, apparent easements, roadways and visible encroachments, if any.

This survey is made for the use of the present owners of the property, and also those who purchase, mortgage, or guarantee the title thereto within one year from date hereof.

WISCONSIN KENNETH B. ABERNATHY, JR. S-1594 ELKHORN WI LAND SURVEYOR

Kenneth B. Abernathy

**KENNETH B. ABERNATHY, JR.**
**WISCONSIN REGISTERED LAND SURVEYOR, S-1594**

**Date:** APRIL 21, 2000 **Job No.** 99.1004

DESIGN PRODUCTS 093122

IL-3-2

117-1896