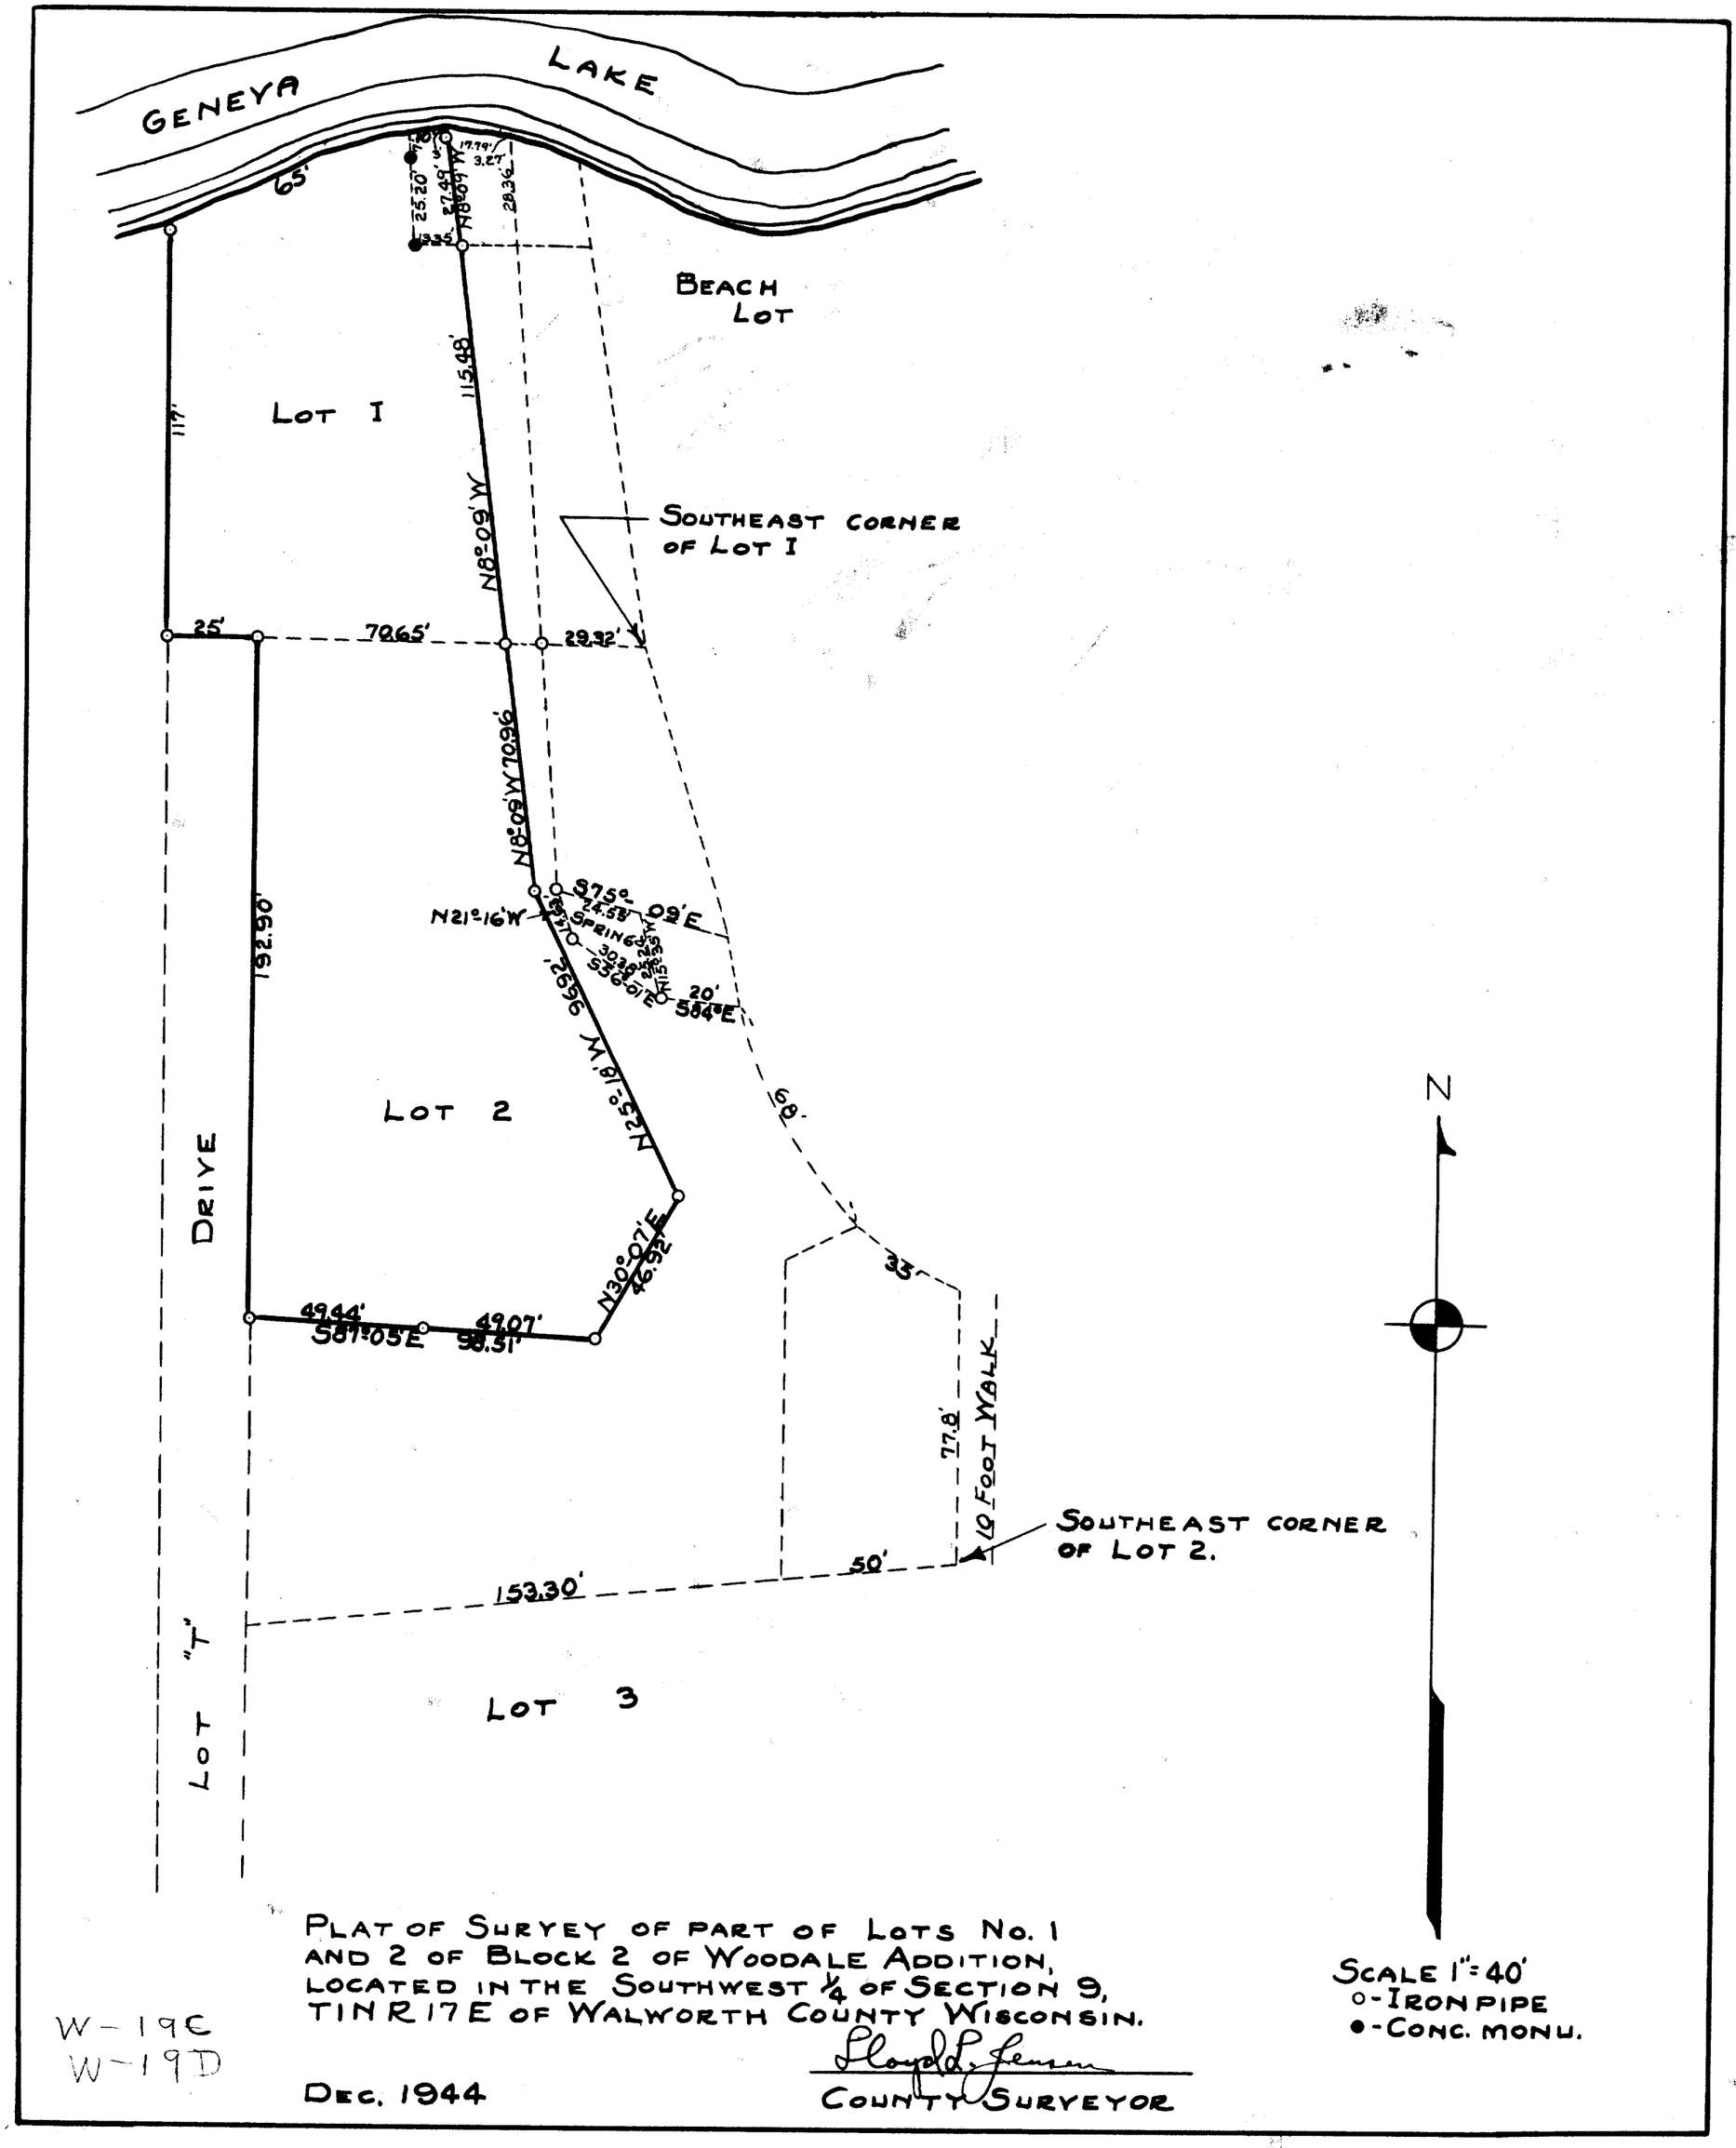


PLAT OF SURVEY OF PART OF LOTS NO. 1 AND 2 OF BLOCK 2 OF WOODALE ADDITION, LOCATED IN THE SOUTHWEST ¼ OF SECTION 9, T1N R17E OF WALWORTH COUNTY WISCONSIN.

DEC. 1944

Lloyd L. Jensen
COUNTY SURVEYOR

SCALE 1"=40'
o-IRON PIPE
●-CONC. MONU.

W-19C
W-19D

117-19.1