
ABELL
SURVEYING & MAPPING

1140 SEQUOIA STREET · DELAVAN, WISCONSIN 53115
262-728-6737

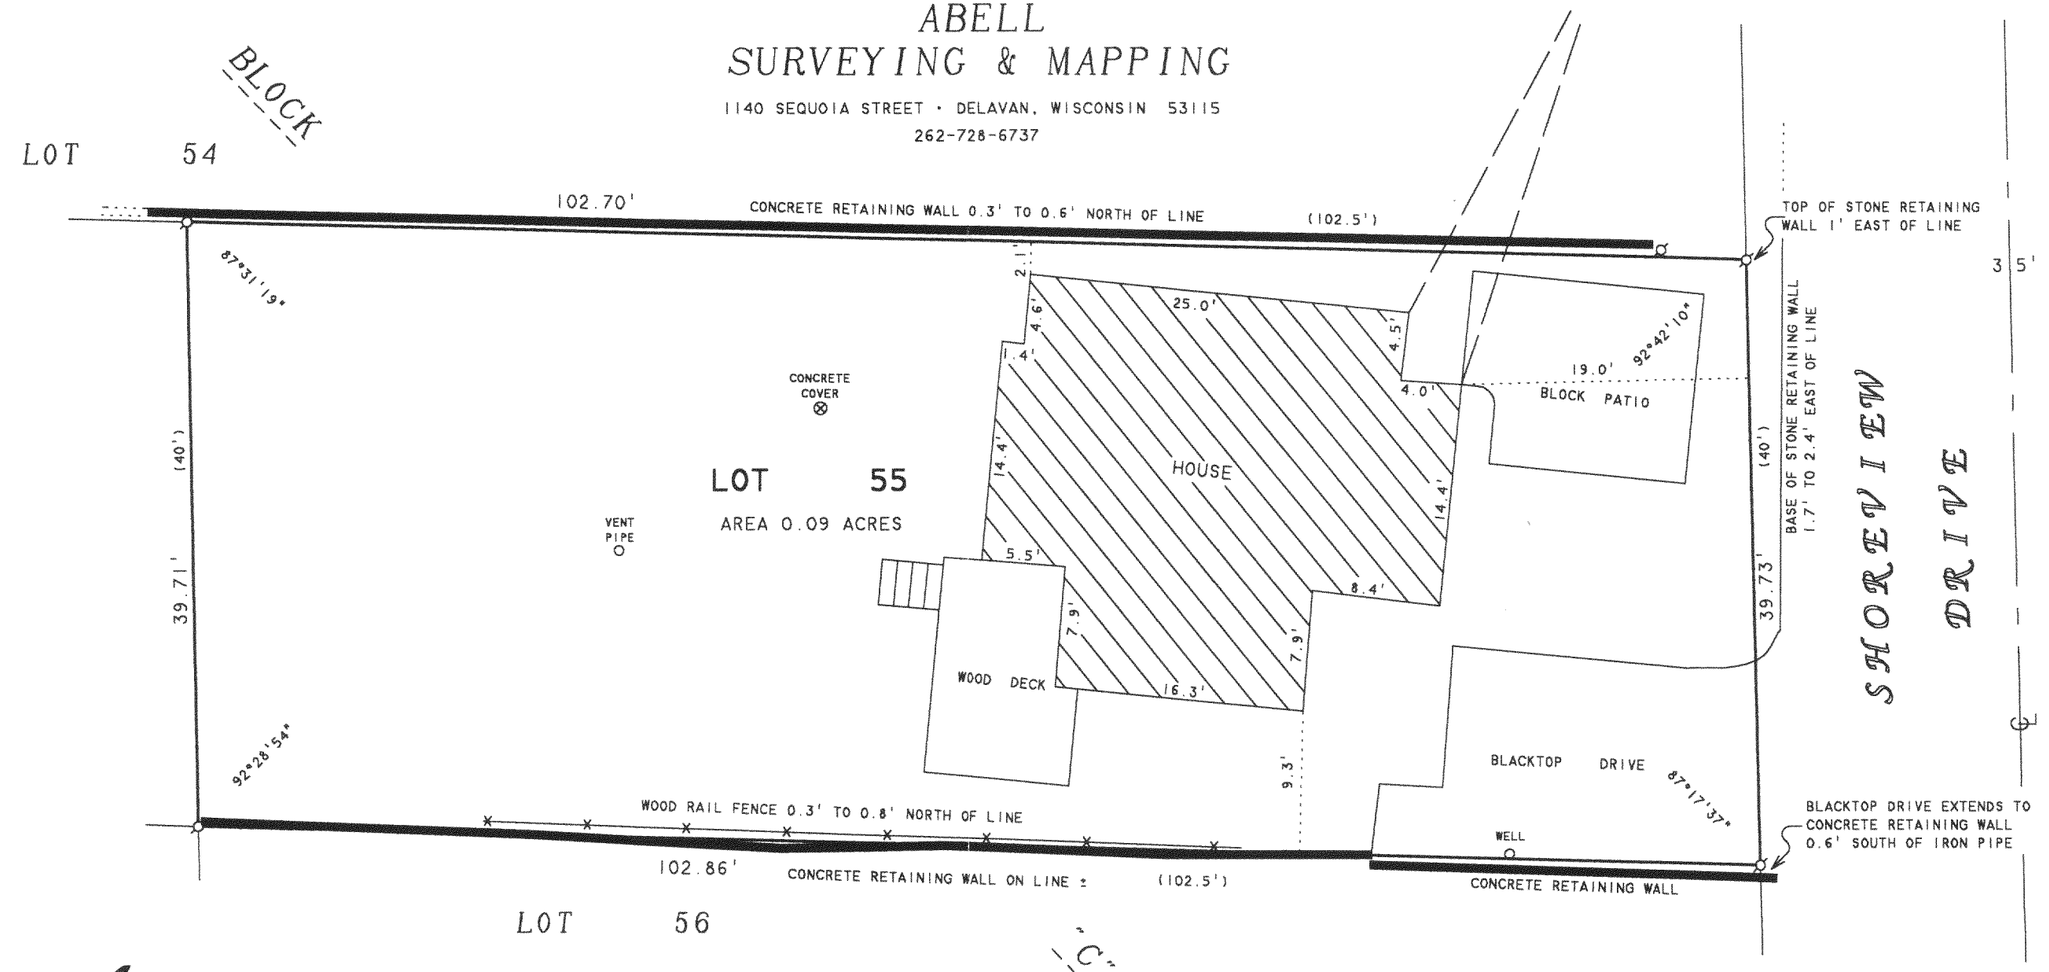

N

SCALE 1"=10'

LEGEND

- ⌀ -IRON PIPE FOUND
- -x-x- -WOOD RAIL FENCE
- ——— ——— -OVERHEAD UTILITY LINES
- ( )-RECORDED AS

PLAT OF SURVEY OF

LOT 55, BLOCK "C", CISCO BEACH SUBDIVISION,
LOCATED IN T1N, R17E, WALWORTH COUNTY, WISCONSIN.

RECEIVED
DEC 18 2000

ORDERED BY: RE/MAX-LAKES AREA REALTORS
1815 N. SHORE DRIVE
DELAVAN, WI. 53115

I HEREBY CERTIFY THAT I HAVE SURVEYED THE ABOVE DESCRIBED PROPERTY AND THAT THE ABOVE MAP IS A TRUE REPRESENTATION THEREOF AND SHOWS THE SIZE AND LOCATION OF THE PROPERTY, ITS EXTERIOR BOUNDARIES, THE LOCATION OF ALL VISIBLE STRUCTURES AND DIMENSIONS OF ALL PRINCIPAL BUILDINGS THEREON, BOUNDARY FENCES, APPARENT EASEMENTS, ROADWAYS AND VISIBLE ENCROACHMENTS, IF ANY, TO THE BEST OF MY KNOWLEDGE AND BELIEF.

THIS SURVEY IS MADE FOR THE USE OF THE PRESENT OWNERS OF THE PROPERTY, AND ALSO THOSE WHO PURCHASE, MORTGAGE, OR GUARANTEE THE TITLE THERETO WITHIN ONE (1) YEAR FROM DATE HEREON.

David F. Abell

DAVID F. ABELL
WISCONSIN REGISTERED LAND SURVEYOR, S-1596

November 9, 2000

DATE JOB NUMBER - 00178

NOTE: THIS IS NOT A CERTIFIED COPY UNLESS SEALED.

ICI-70

117-1949