
FARRIS, HANSEN & ASSOCIATES, INC.

ENGINEERING – ARCHITECTURE – SURVEYING
7 RIDGWAY COURT – P.O. BOX 437 – ELKHORN, WISCONSIN 53121
PHONE: (262) 723-2098 FAX: (262) 723-5886

– WORK ORDERED BY –
KATIE MCNAMEE
N1744 HILLSIDE ROAD
LAKE GENEVA, WI, 53147

PLAT OF SURVEY

LOTS 52 & 53 OF LAKE GENEVA BEACH SUBDIVISION
TOWN 1 NORTH, RANGE 17 EAST, WALWORTH COUNTY, WISCONSIN

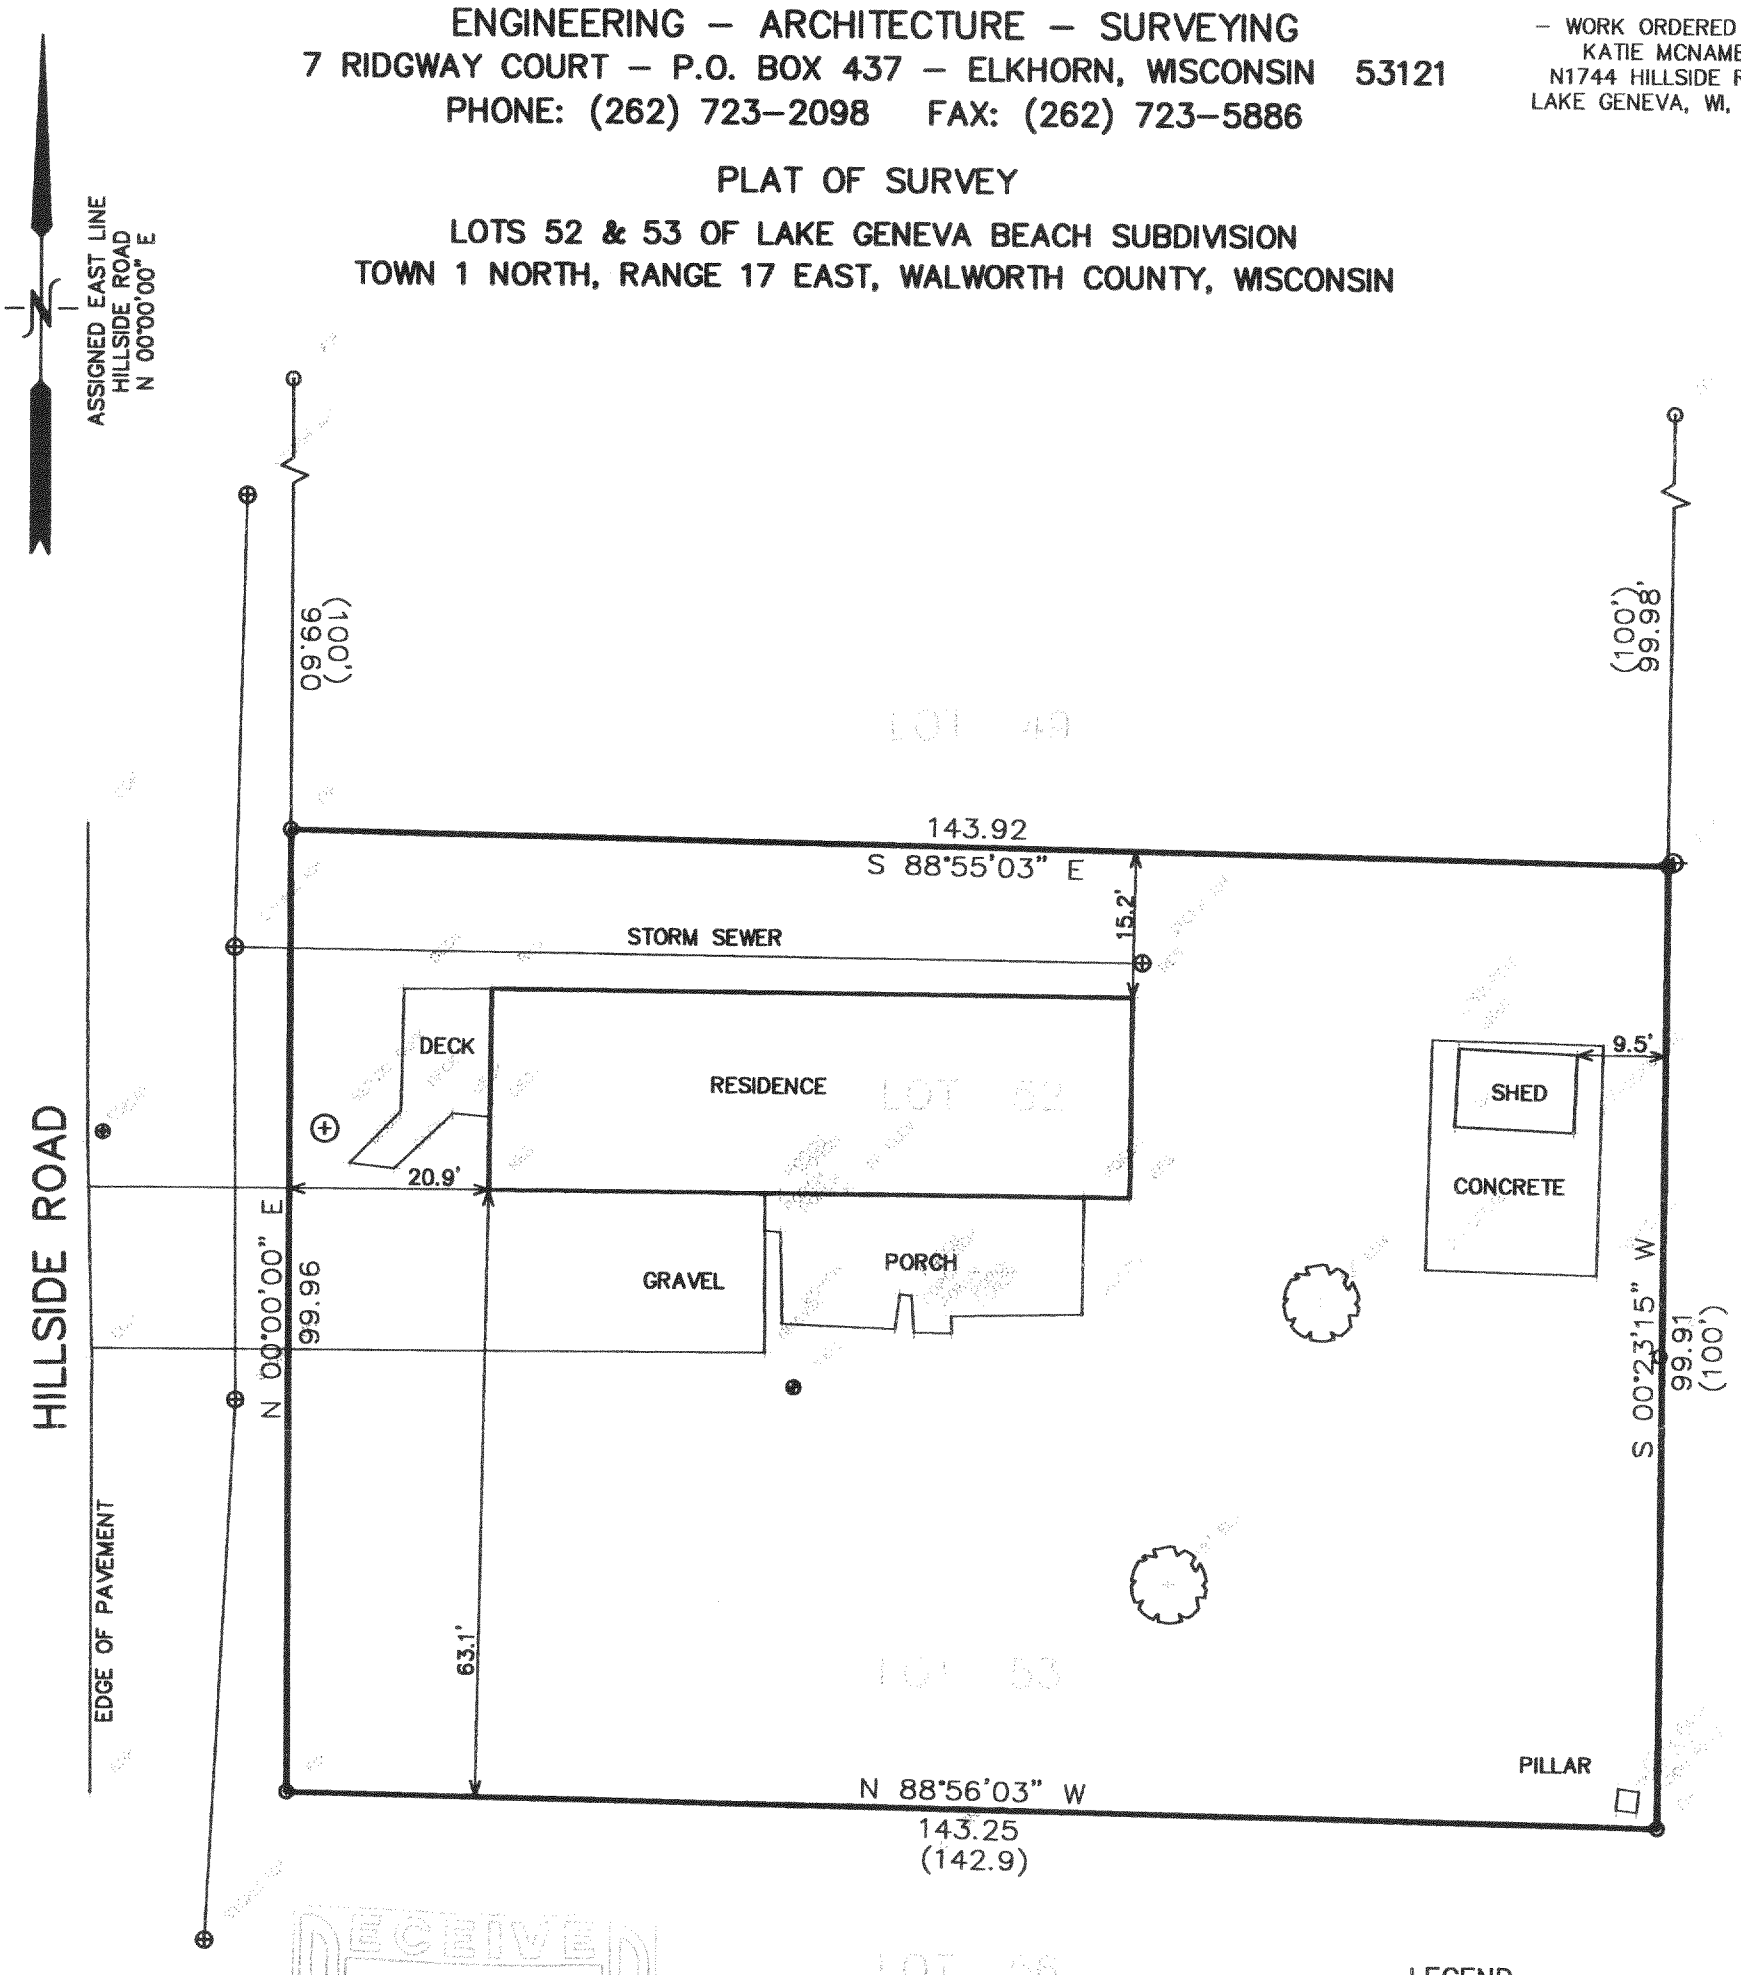

RECEIVED
SEP 10 2001

LEGEND

O	=	FOUND IRON PIPE STAKE
	=	SET IRON REBAR STAKE
(XXX)	=	RECORDED AS

NOTE: COPIES OF THIS MAP TO WHICH THE FOLLOWING CERTIFICATE WILL APPLY SHOW SURVEYOR'S ORIGINAL SEAL AND SIGNATURE IN RED INK. COPIES BY ANY OTHER MEANS MAY HAVE ALTERATIONS WHICH DO NOT REPRESENT THE SURVEYOR'S WORK PRODUCT.

I HEREBY CERTIFY THAT THE ABOVE DESCRIBED PROPERTY HAS BEEN SURVEYED UNDER MY DIRECTION AND THAT THE ABOVE MAP IS A TRUE REPRESENTATION THEREOF AND SHOWS THE SIZE AND LOCATION OF THE PROPERTY AND ITS EXTERIOR BOUNDARIES. THIS SURVEY IS MADE FOR THE USE OF THE PRESENT OWNERS OF THE PROPERTY, AND ALSO THOSE WHO PURCHASE, MORTGAGE, OR GUARANTEE THE TITLE THERETO WITHIN ONE YEAR FROM THE DATE HEREOF.

DATED: 7-9-2001

PETER S. GORDON R.L.S. 2101

PETER S. GORDON S-2101 ELKHORN, WI LAND SURVEYOR

10 5 0 10 20 30 40 50 60 70 80 90 100
MAP SCALE IN FEET ORIGINAL 1" = 20'

PROJECT: 5838
DATE: 07/05/01
SHEET 1 OF 1

ILCB-46
JUL 09 2001

117-2026