
AMBIT LAND SURVEYING
P. O. Box 42
Bassett, WI. 53101

PLAT OF SURVEY

PHONE 262-537-4874
FAX 262-537-4221

OF

Lots 7 and 8, Block 11 of WOODDALE ADDITION, being part of the East Half of the Southwest Quarter of Section 9, and also part of the East Half of the Northwest Quarter of Section 16, Township 1 North, Range 17 East of the 4th Principal Meridian, Town of Linn, County of Walworth, State of Wisconsin.

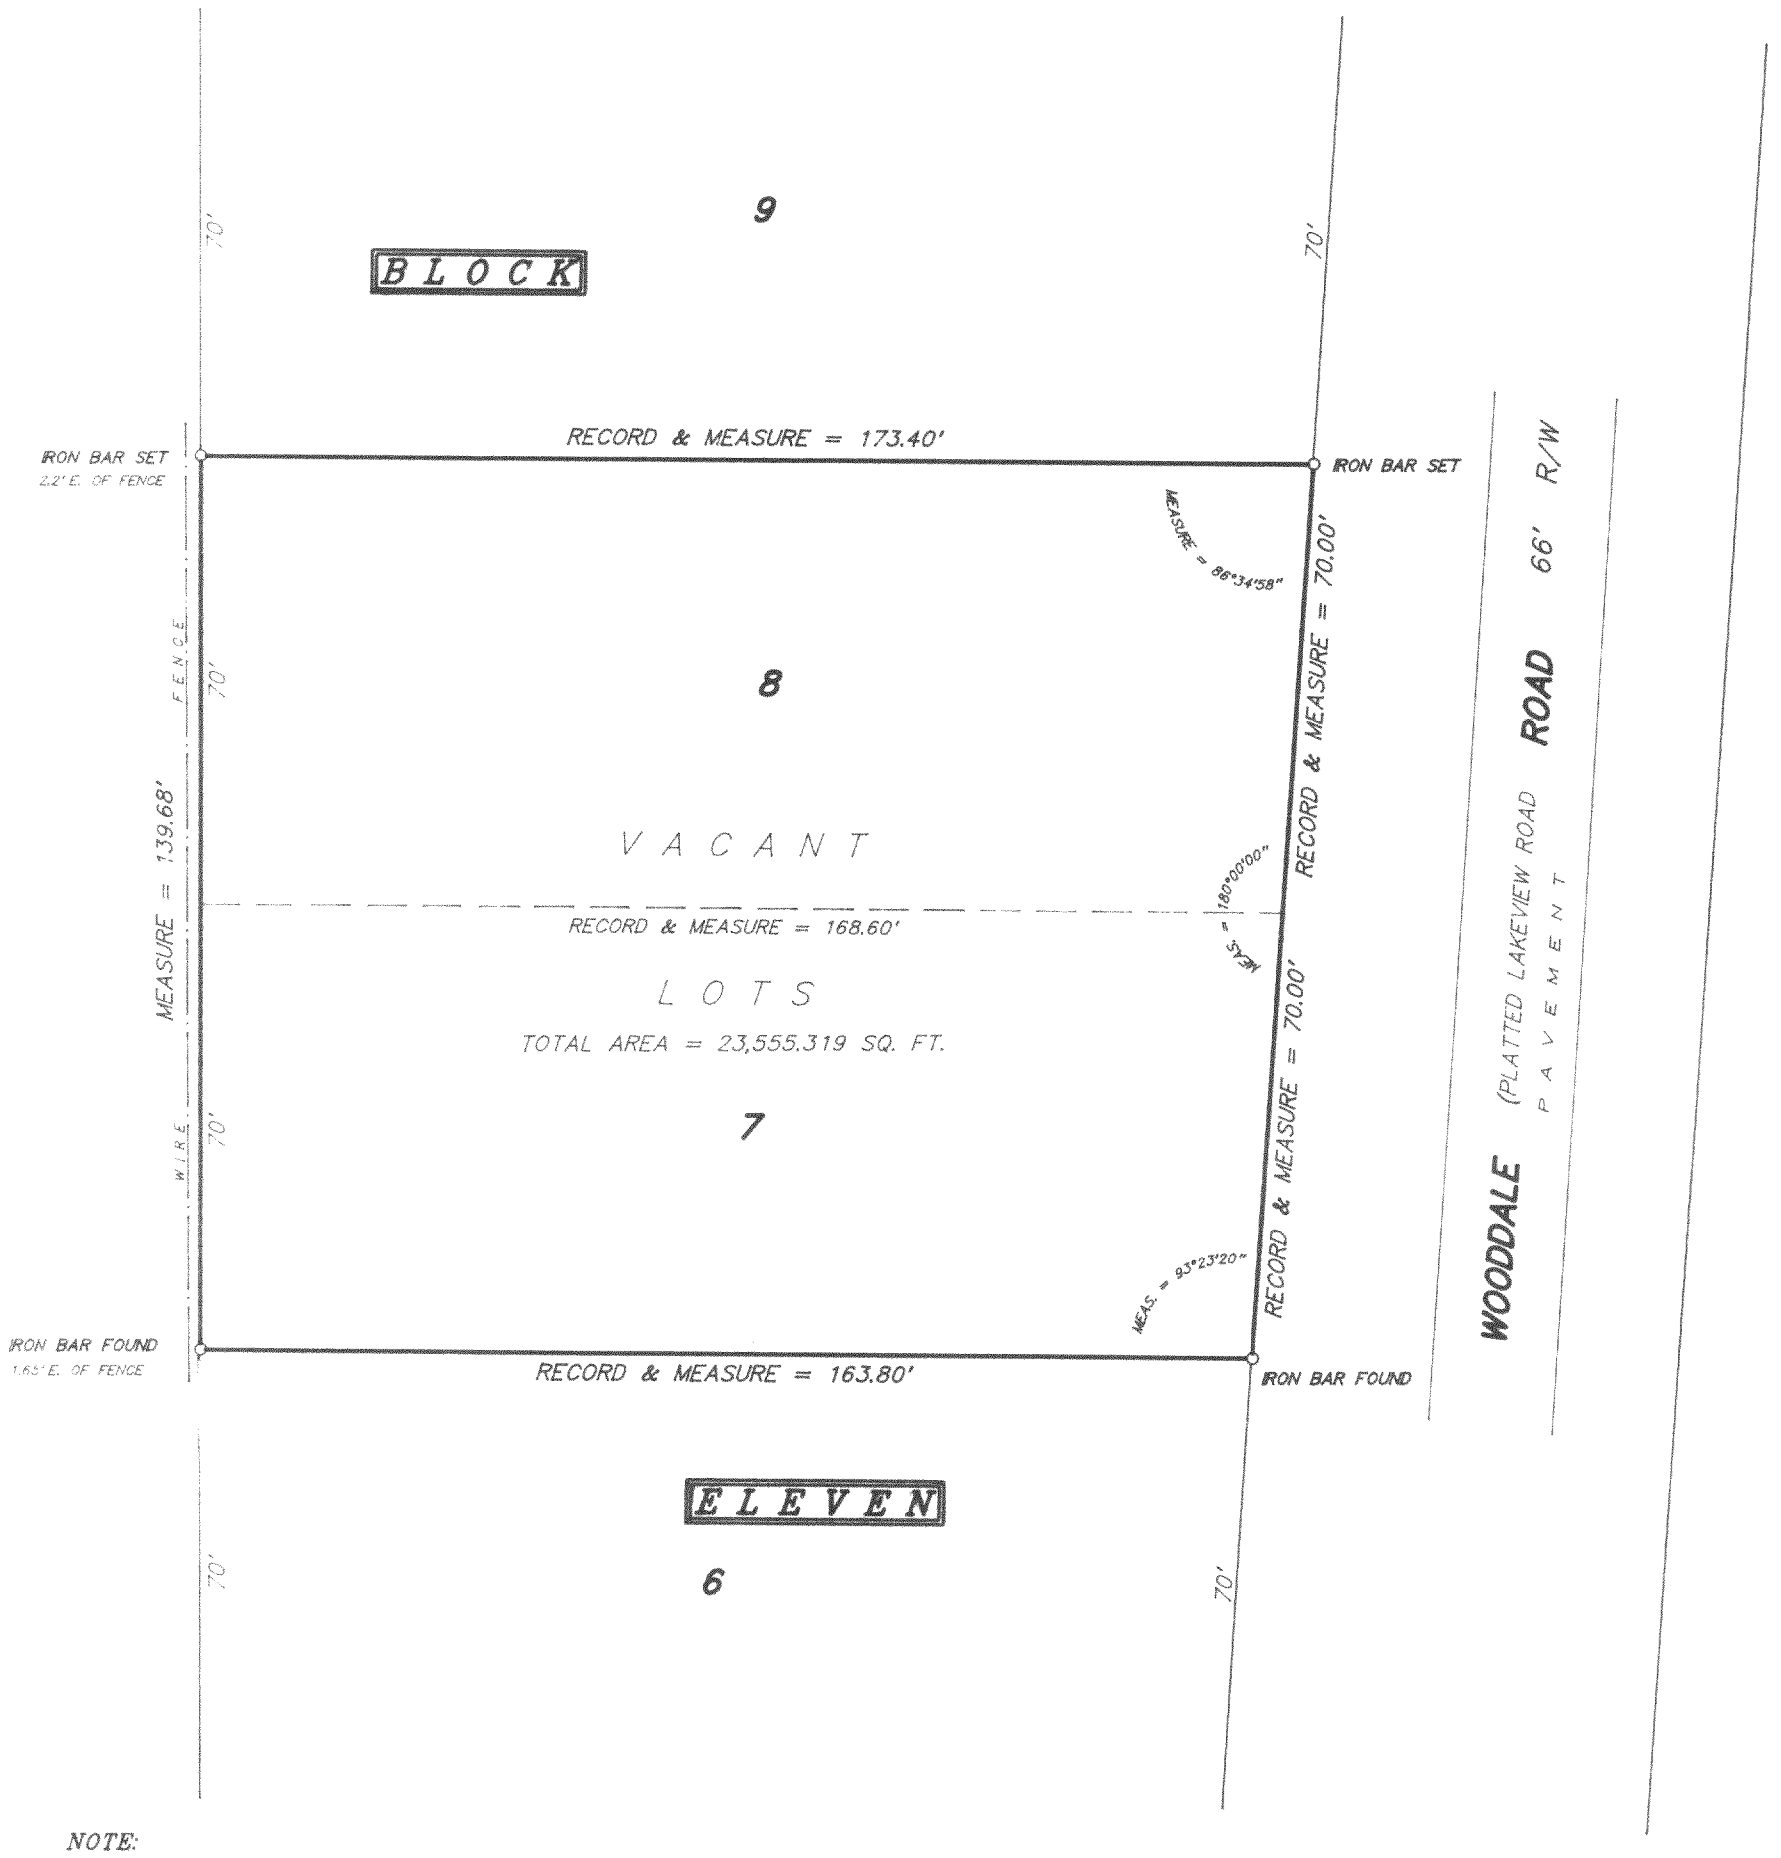

NOTE:

The platted curve information along Wooddale Road is to ambiguous to determine the start and end of the curve(s).

Field evidence was lacking for curve location, therefore front lot corners were calculated using record distance-distance intersections and no arces were used along front lot lines.

RECEIVED
OCT 3 2001

N

SCALE 1 inch = 30 feet

ORDERED BY J. Syver

JOB NO. 0 1 0 3 8

I hereby certify that I have surveyed the above described property and the above plat is a true representation thereof and shows the size and location of the property, its exterior boundaries, the location and dimensions of all visible structures thereon, boundary fences, apparent easements and roadways and visible encroachments, if any.

This survey is made for the exclusive use of the present owners of the property, and also those who purchase, mortgage, or guarantee the title thereto within one year from the date hereof.

Dated at Bassett, Wisconsin this _____ day of _____ 2001.

Mark A. Bolender
Wisconsin Registered Land Surveyor S - 1784

IW-60A2
117-2039