DEGEN, FOAT SURVEYING ASSOCIATES

100 SOUTH SECOND STREET
WATERFORD, WISCONSIN
(262)534-5404 (FAX)534-2022


015221
015221S1.DWG

PLAT OF SURVEY

LOT 1, WALWORTH COUNTY CERTIFIED SURVEY MAP NO. 1323, RECORDED IN VOLUME 6 OF CERTIFIED SURVEYS ON PAGE 128, WALWORTH COUNTY REGISTER OF DEEDS, BEING PART OF THE SOUTHWEST 1/4 OF SECTION 11 AND PART OF THE NORTHWEST 1/4 OF SECTION 14, TOWN 1 NORTH, RANGE 17 EAST, TOWN OF LINN, WALWORTH COUNTY, WISCONSIN.

SURVEY ORDERED BY: LINDA TONGE
KEEFE REALTY
P.O. BOX 460
LAKE GENEVA, WI 53147

NOTE: SEPTIC SYSTEM IS ON ADJOINING PROPERTIES

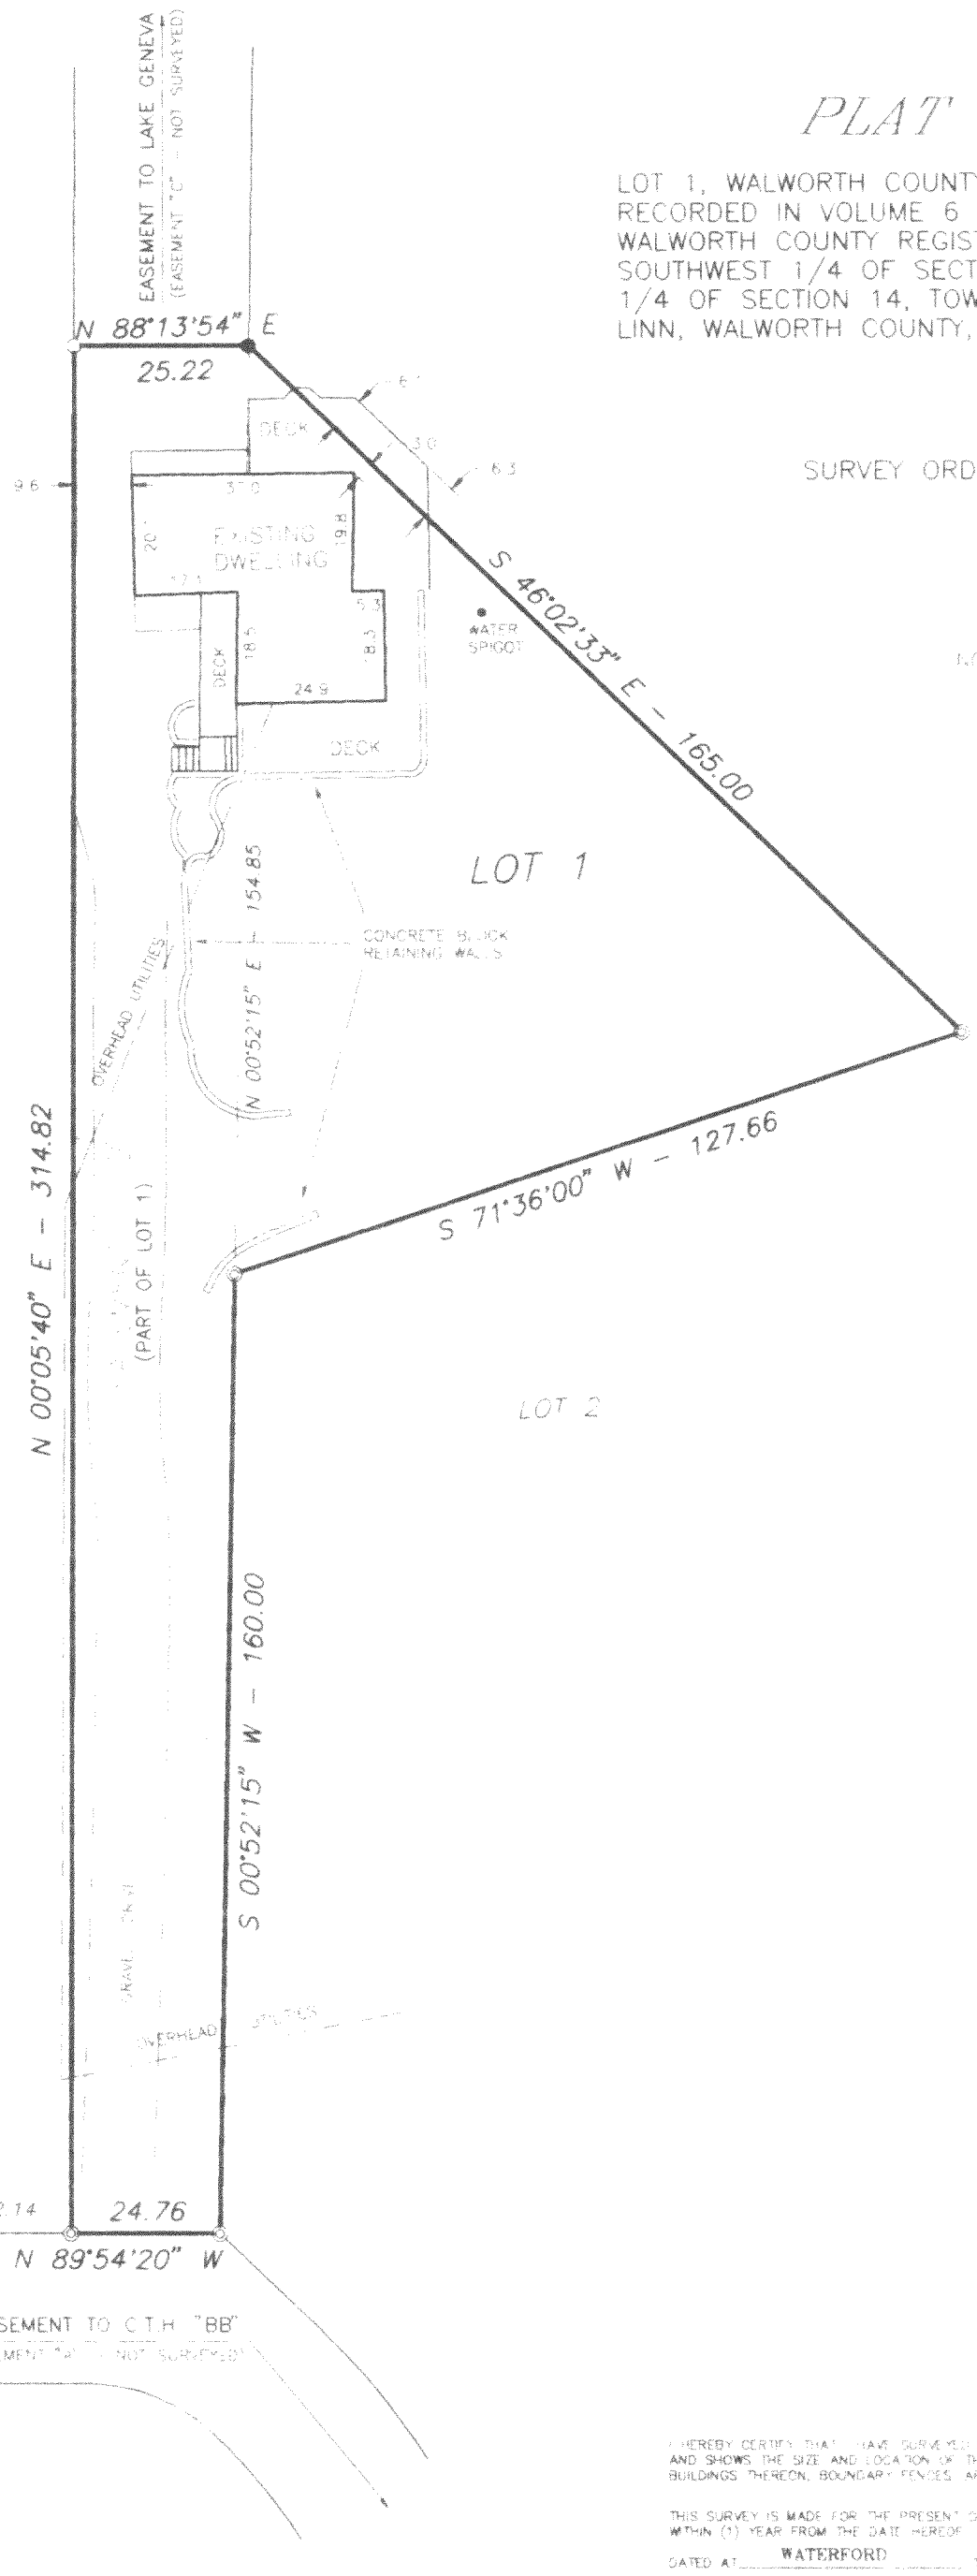

SCALE 1" = 30'

LEGEND

- ○ = FOUND 1" 2" IRON PIPE
- ⊙ = FOUND 3/4" IRON PIPE
- ● = FOUND IRON ROD
- ( ) = RECORDED AS

RECEIVED
OCT 3 2001

I HEREBY CERTIFY THAT I HAVE SURVEYED THE ABOVE DESCRIBED PROPERTY AND THE ABOVE MAP IS A TRUE REPRESENTATION THEREOF AND SHOWS THE SIZE AND LOCATION OF THE PROPERTY, THE LOCATION OF ALL VISIBLE STRUCTURES AND DIMENSIONS OF ALL PRINCIPAL BUILDINGS THEREON, BOUNDARY FENCES, APPARENT EASEMENTS, ROADWAY AND VISIBLE ENCROACHMENTS, IF ANY.

THIS SURVEY IS MADE FOR THE PRESENT OWNERS OF THE PROPERTY AND ALSO THOSE WHO PURCHASE OR GUARANTEE THE TITLE THERETO WITHIN (1) YEAR FROM THE DATE HEREOF.

DATED AT WATERFORD THIS 9TH DAY OF AUGUST, 20 01

RECERTIFIED _____

IA-1323-1

117-2044