


PLAT OF SURVEY

LOTS 16 AND 17 AND TWO 10 FOOT STRIPS OF LAND ON THE WATER FRONT DESIGNATED AS PARCELS NO. 8 AND 9 OF ALTA VISTA ESTATES, LOCATED IN GOVERNMENT LOT 2, AND IN THE SOUTHEAST 1/4 OF THE NORTHEAST 1/4 OF SECTION 4, TOWN 1 NORTH, RANGE 17 EAST, WALWORTH COUNTY, WISCONSIN.

LINE	DISTANCE
L1	6.67
L2	4.00
L3	4.00
L4	4.00
L5	3.33
L6	2.00
L7	7.00
L8	2.00
L9	3.33
L10	5.67
L11	4.00
L12	2.00
L13	4.00
L14	1.33

DETAIL OF RESIDENCE
SCALE 1" = 20 FEET



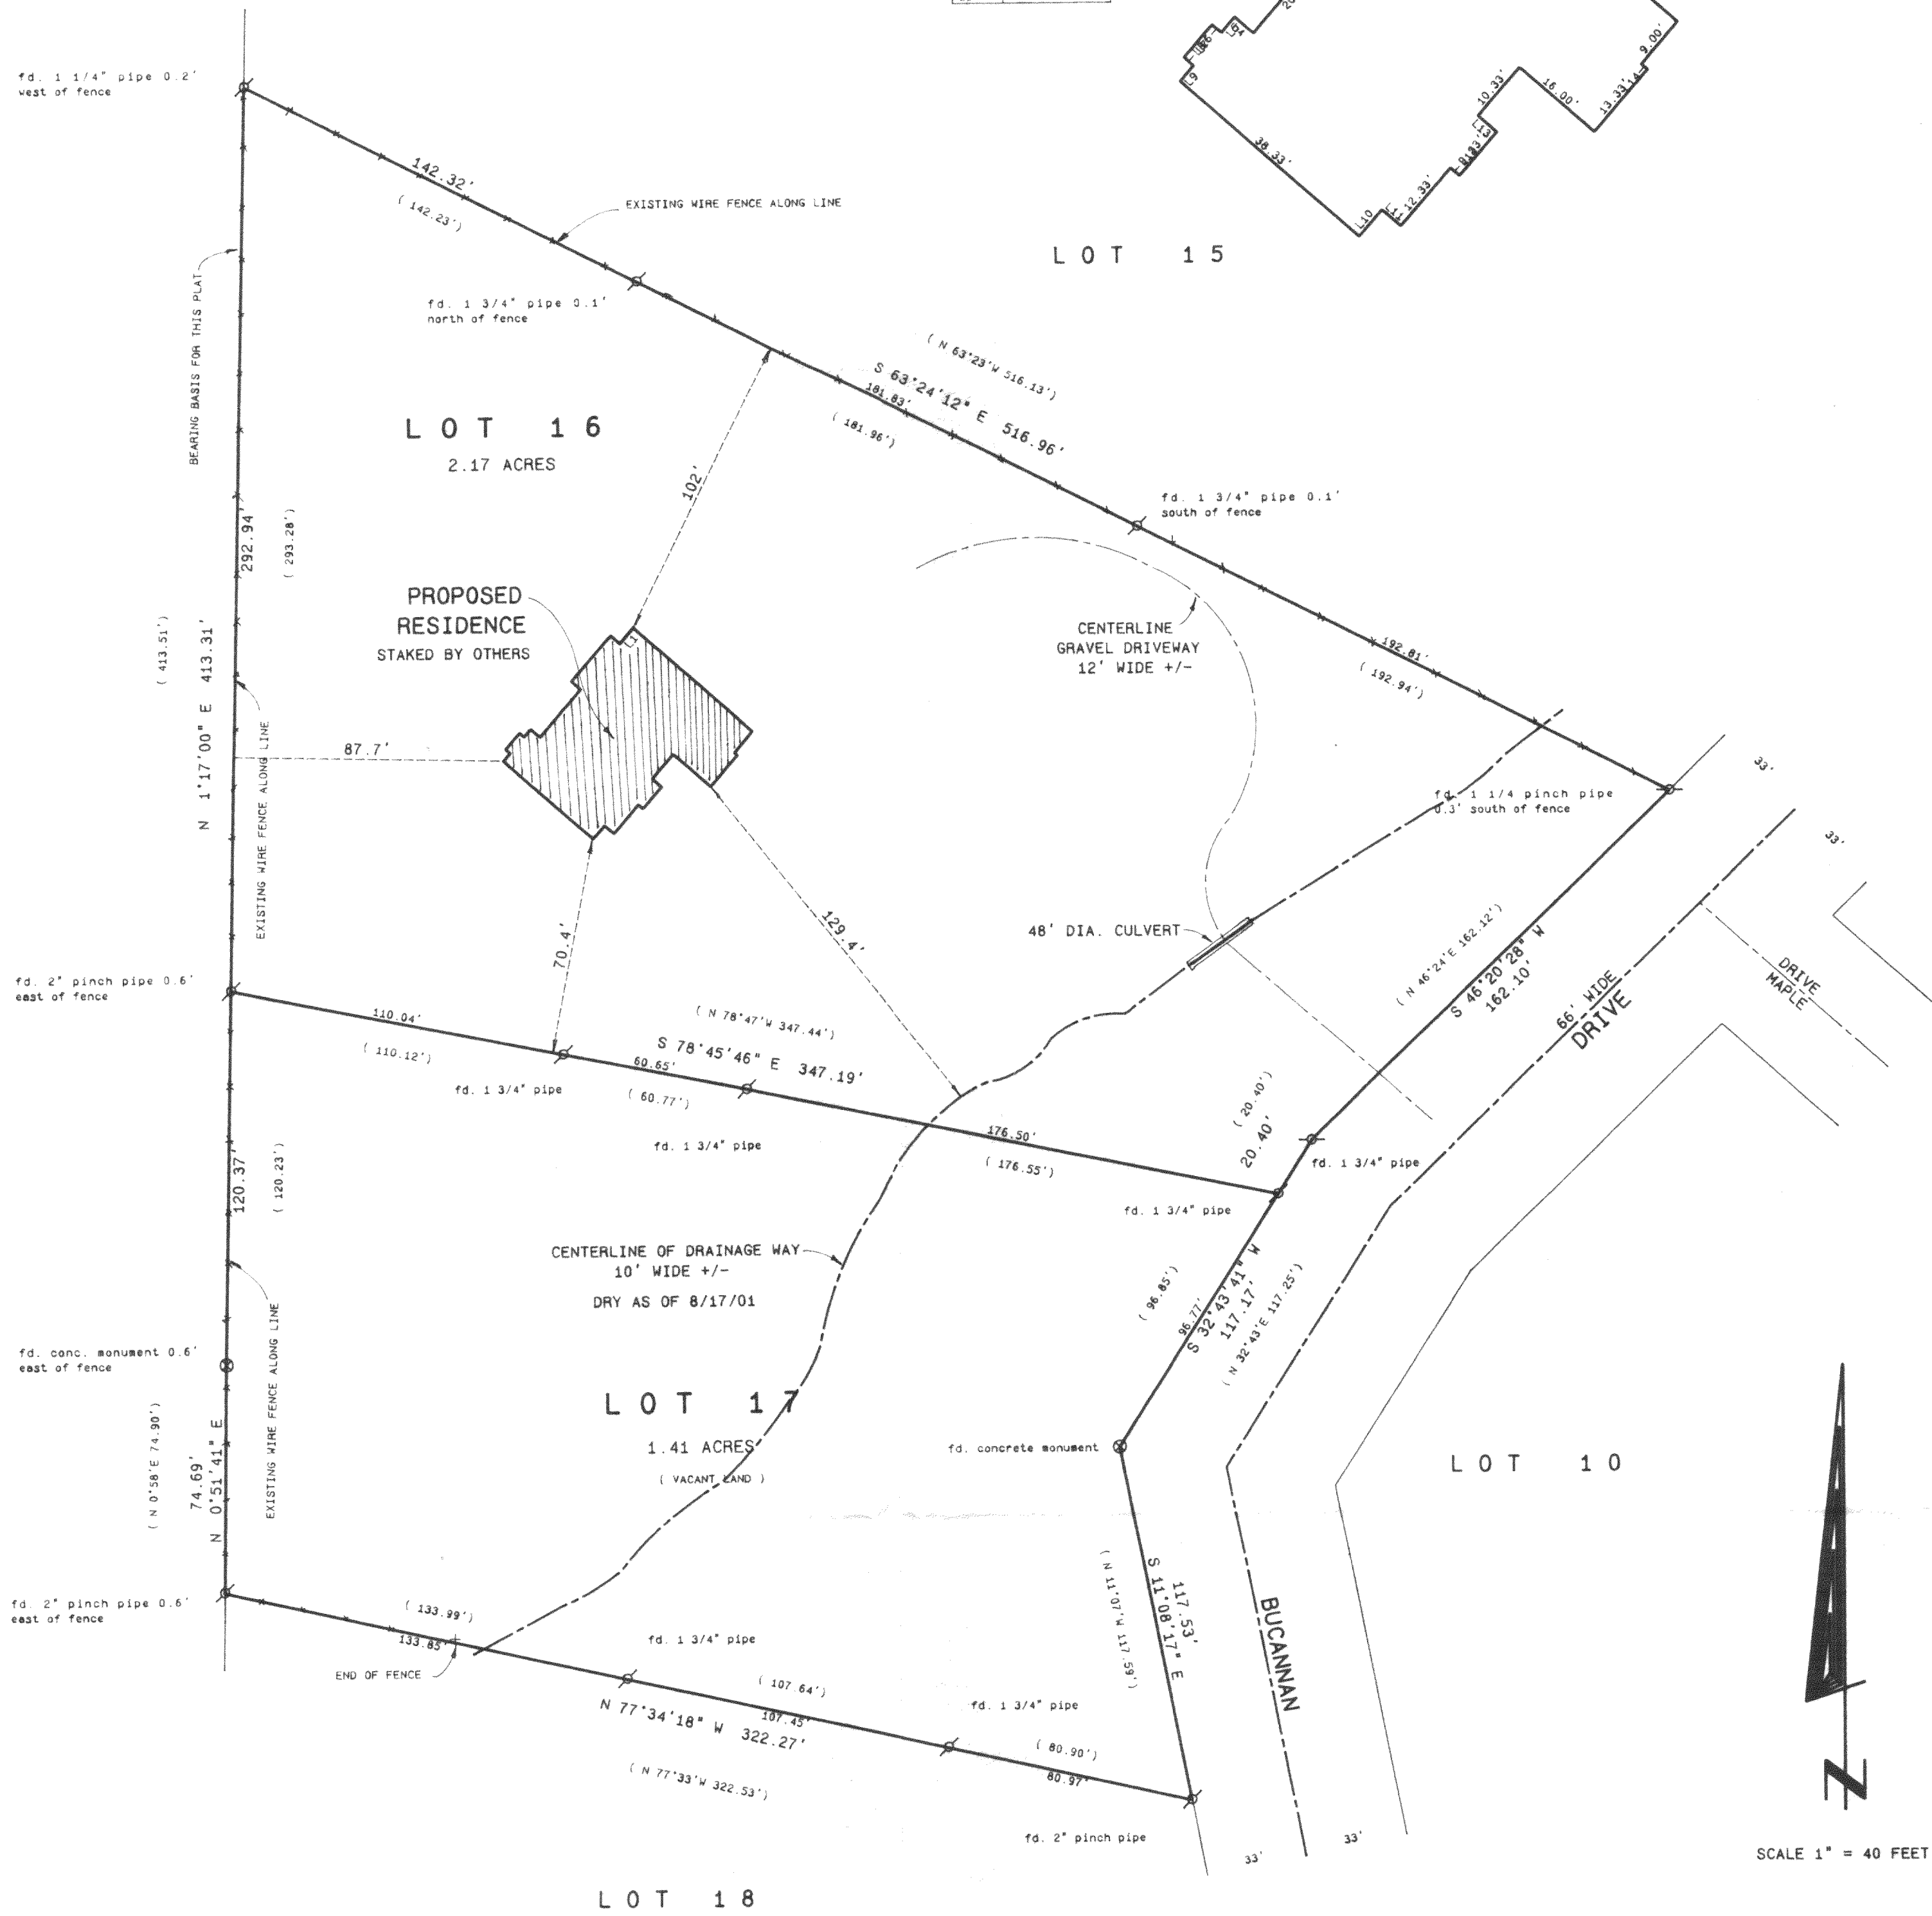


LEGAL DESCRIPTION

WARRANTY DEED RECORDED IN VOL. 619 P. 487 AS DOCUMENT NO. 570600 DATED JUNE 3rd, 1965. ERWIN J JANICKE AND GERDA JANICKE, husband and wife TO RICHARD H. HOWLAND and MARILYN M. HOWLAND, his wife.

OWNERS: JOHN and JEAN BLIX
549 SIOUX DRIVE
FONTANA, WI. 53125

REVISED 8/17/01 TO SHOW PROPOSED RESIDENCE, DRAINAGE WAY, DRIVE AND CULVERT.

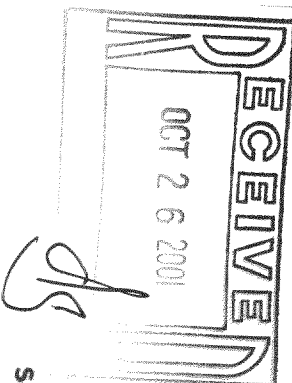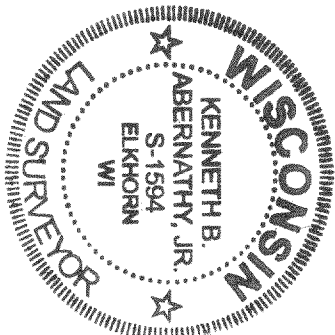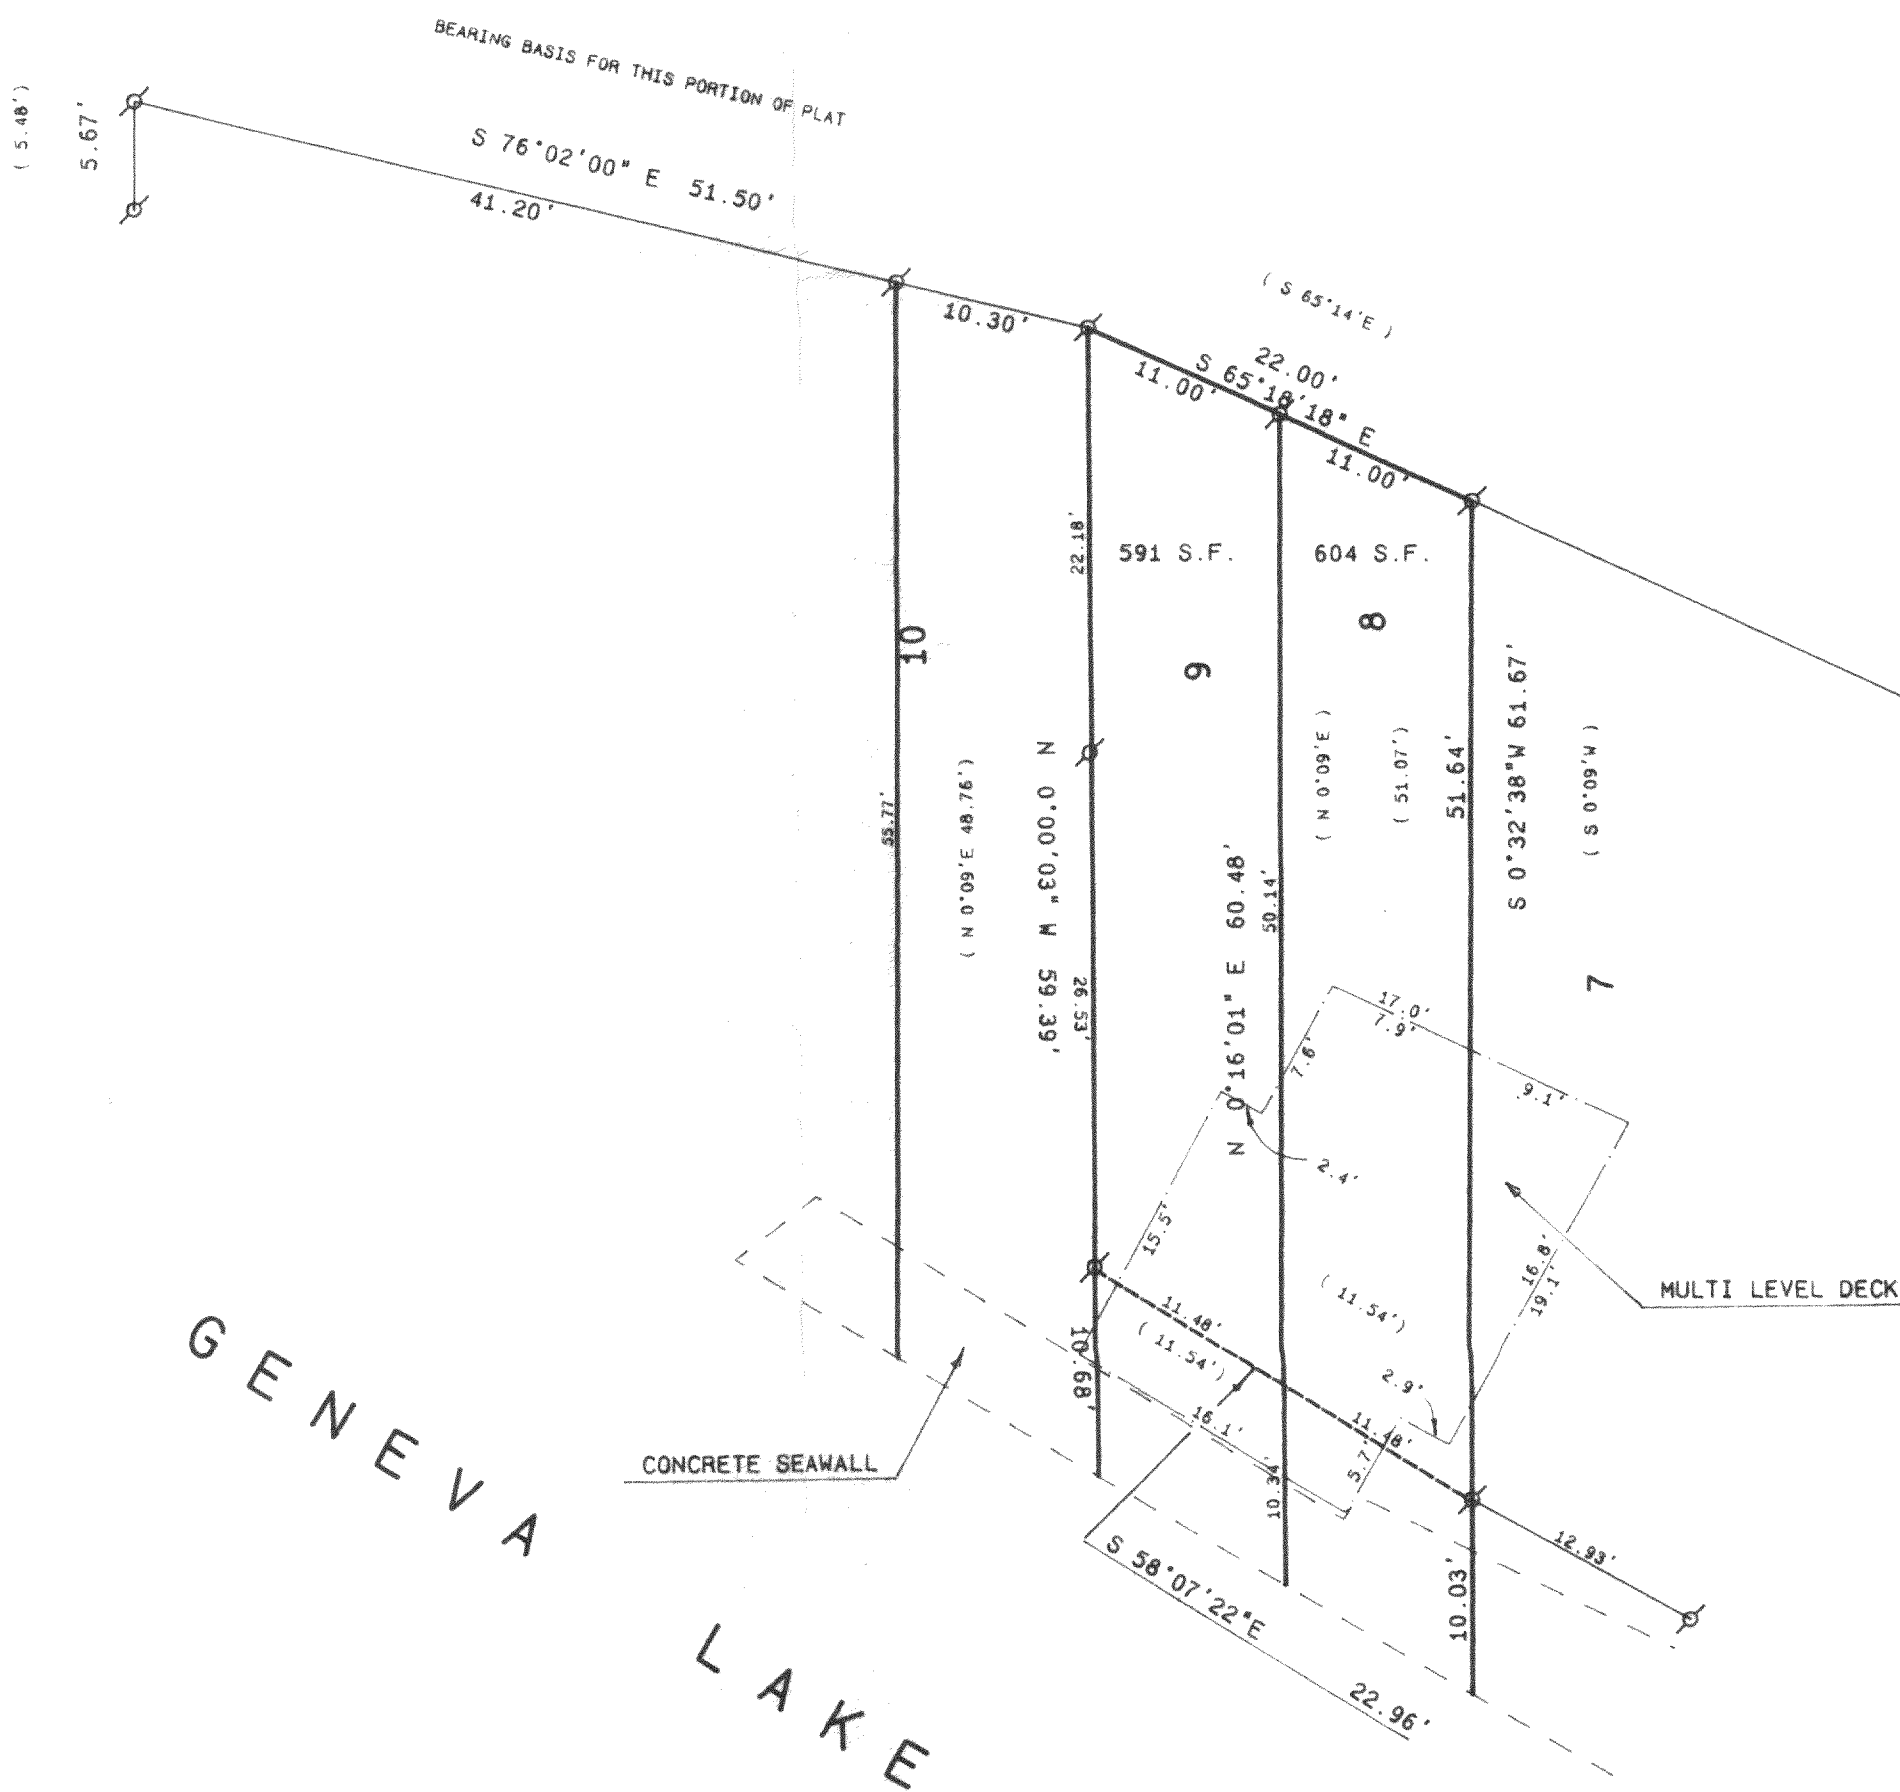

SCALE: 1"= 40 FEET

Legend

Kenneth B. Abernathy Jr.
WISCONSIN REGISTERED LAND SURVEYOR
S-1594
Date: FEBRUARY 7, 1997 Job No. 97-005