ABERNATHY and ASSOCIATES
Kenneth B. Abernathy Jr.
Wisconsin Registered Land Surveyor S-1594

W4056 BRAY RD.
ELKHORN, WI. 53121
PHONE: (262) 723-4260 (OFFICE)
(262) 723-7209 (FAX)
Email: abernathy@elknet.net

# PLAT OF SURVEY

RECEIVED
APR 24 2002

PROPOSED ROAD VACATION AND DEDICATION FOR HIGH MEADOW DRIVE ADJACENT TO LOT 3 OF CERTIFIED SURVEY MAP NO. 2844 AND LOT 1 OF CERTIFIED SURVEY MAP NO. 3049, LOCATED IN THE NORTHWEST 1/4 AND THE SOUTHWEST 1/4 OF THE NORTHEAST 1/4 OF SECTION 15, TOWN 1 NORTH, RANGE 17 EAST. TOWN OF LINN, WALWORTH COUNTY, WISCONSIN.


## LEGAL DESCRIPTION OF ROAD VACATION


ROAD AND CUL DE SAC VACATION FOR HIGH MEADOW DRIVE ADJACENT TO LOT 3 OF CERTIFIED SURVEY MAP NO. 2844 AND LOT 1 OF CERTIFIED SURVEY MAP NO. 3049, LOCATED IN THE NORTHWEST 1/4 AND THE SOUTHWEST 1/4 OF THE NORTHEAST 1/4 OF SECTION 15, TOWN 1 NORTH, RANGE 17 EAST. TOWN OF LINN, WALWORTH COUNTY, WISCONSIN, DESCRIBED AS FOLLOWS: BEGIN AT A FOUND IRON PIPE WHICH MARKS THE SOUTHEAST CORNER OF LOT 3 OF CERTIFIED SURVEY MAP NO. 2844; THENCE ALONG THE ARC OF A CURVE TO THE RIGHT, WHOSE CHORD BEARS N 32°28'37" E 208.45 HAVING A RADIUS OF OF 451.00 FEET AND A CENTRAL ANGLE OF 26°43'25", 210.35 FEET TO A FOUND IRON PIPE; THENCE ALONG THE ARC OF A CURVE TO THE RIGHT, WHOSE CHORD BEARS S 39°28'49" E 66.26 HAVING A RADIUS OF 66 FEET AND A CENTRAL ANGLE OF 299°44'28", 345.28 FEET TO A FOUND IRON PIPE; THENCE ALONG THE ARC OF A CURVE TO THE LEFT ALONG SAID ROAD LINE, WHOSE CHORD BEARS S 32°12'00" W 171.02 FEET HAVING A RADIUS OF 385.00 FEET AND A CENTRAL ANGLE OF 25°39'55", 172.46 FEET TO A FOUND IRON ROD WHICH MARKS THE SOUTHWESTERLY CORNER OF LOT 1 OF CERTIFIED SURVEY MAP NO. 3049; THENCE N 72°21'49" W 66.03 FEET TO THE POINT OF BEGINNING. SAID ROAD CONTAINS 25,918 SQUARE FEET OF LAND MORE OR LESS.

## LEGAL DESCRIPTION FOR ROAD DEDICATION


CUL DE SAC ROAD DEDICATION FOR HIGH MEADOW DRIVE ADJACENT TO LOT 3 OF CERTIFIED SURVEY MAP NO. 2844 AND LOT 1 OF CERTIFIED SURVEY MAP NO. 3049, LOCATED IN THE NORTHWEST 1/4 AND THE SOUTHWEST 1/4 OF THE NORTHEAST 1/4 OF SECTION 15, TOWN 1 NORTH, RANGE 17 EAST. TOWN OF LINN, WALWORTH COUNTY, WISCONSIN, DESCRIBED AS FOLLOWS: BEGIN AT A FOUND IRON PIPE WHICH MARKS THE SOUTHEAST CORNER OF LOT 3 OF CERTIFIED SURVEY NO. 2844; THENCE ALONG THE ARC OF A CURVE TO THE RIGHT, WHOSE CHORD BEARS S 72°21'49" E 66.03 HAVING A RADIUS OF 66.00 FEET AND A CENTRAL ANGLE OF 299°58'12", 345.54 FEET TO A FOUND IRON ROD WHICH MARKS THE SOUTHWESTERLY CORNER OF LOT 1 OF CERTIFIED SURVEY MAP NO. 3049; THENCE N 72°21'49" W 66.03 FEET TO THE POINT OF BEGINNING. SAID CUL DE SAC CONTAINS 13,290 SQUARE FEET OF LAND MORE OR LESS.

SEE C.S.M. # 3049 FOR ADDITIONAL BOUNDARY INFORMATION

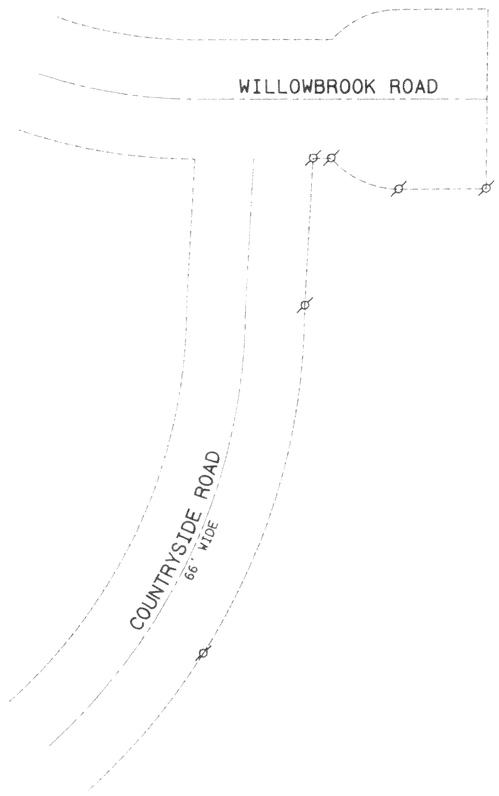


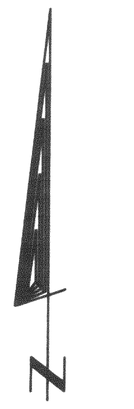

SCALE 1" = 60 FEET

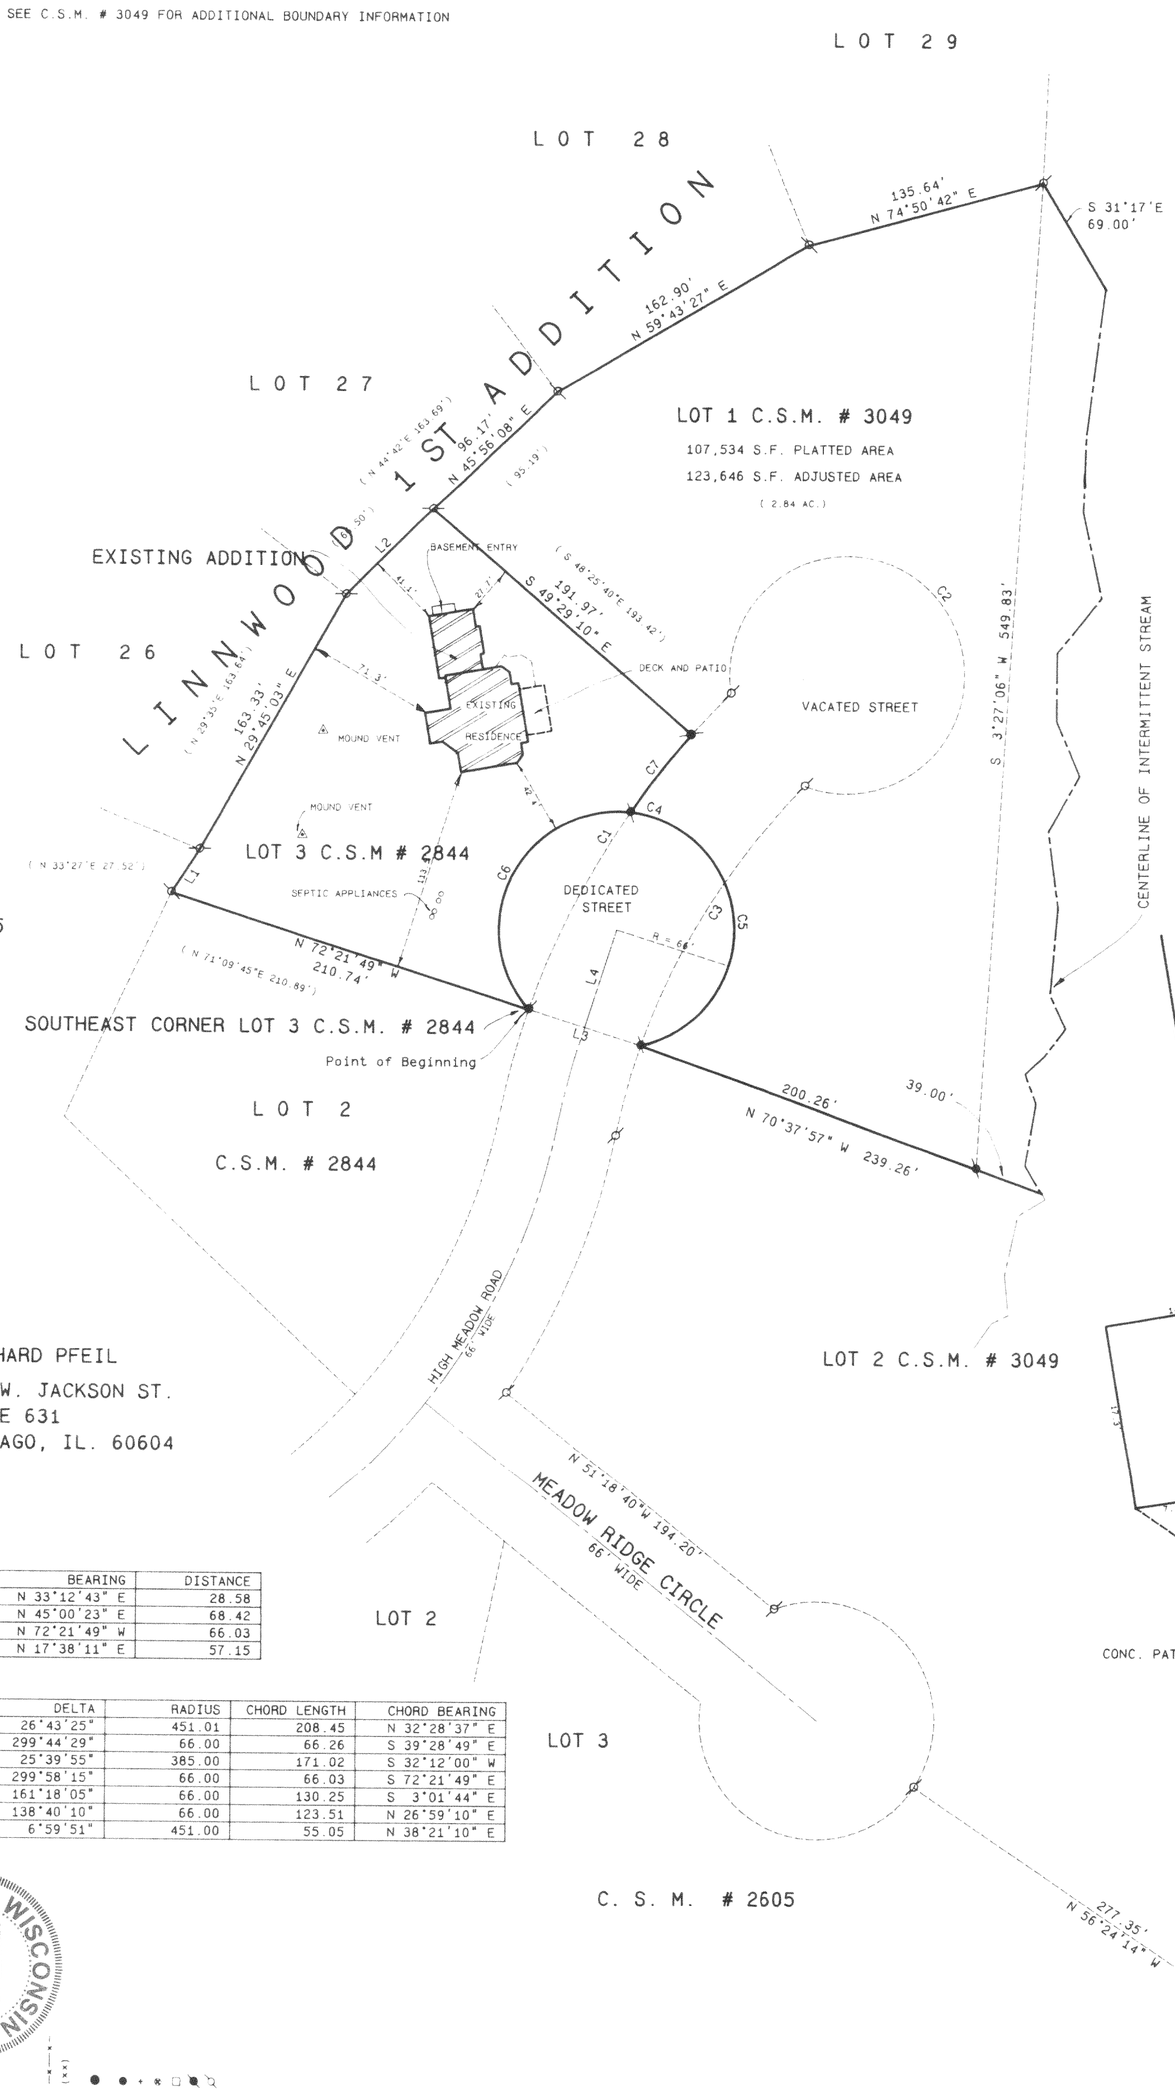


ADDITION DETAIL
SCALE 1" = 10 FEET

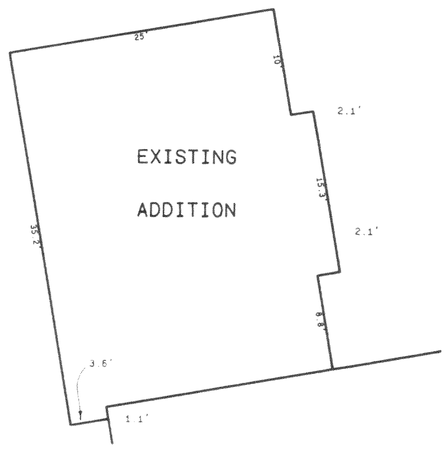


AS BUILT RESIDENCE
DETAIL SCALE 1" = 10 FEET

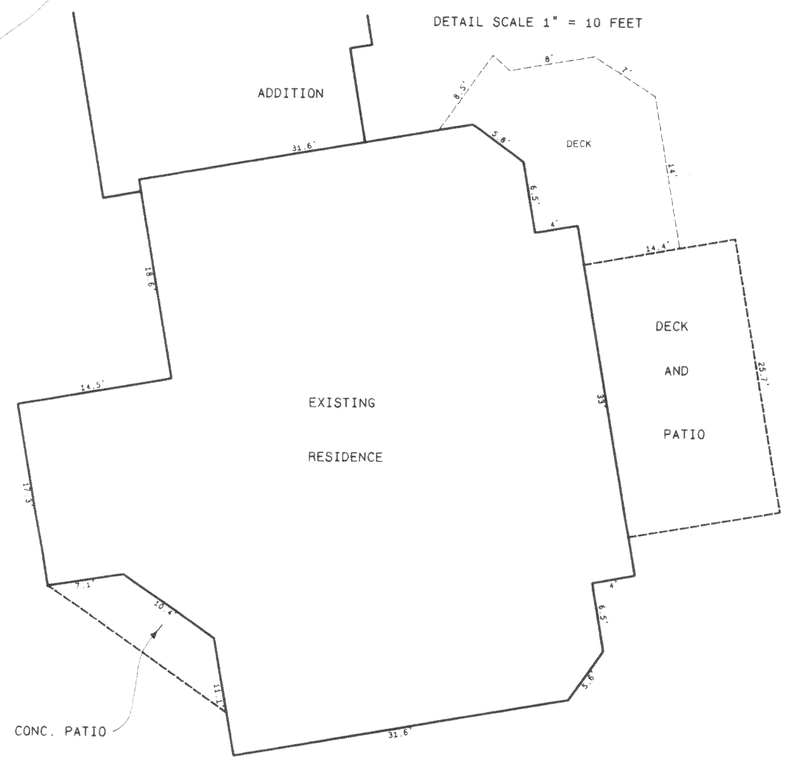


| LINE | BEARING | DISTANCE |
|---|---|---|
| L1 | N 33°12'43" E | 28.58 |
| L2 | N 45°00'23" E | 68.42 |
| L3 | N 72°21'49" W | 66.03 |
| L4 | N 17°38'11" E | 57.15 |

| CURVE | ARC | DELTA | RADIUS | CHORD LENGTH | CHORD BEARING |
|---|---|---|---|---|---|
| C1 | 210.36 | 26°43'25" | 451.01 | 208.45 | N 32°28'37" E |
| C2 | 345.28 | 299°44'29" | 66.00 | 66.26 | S 39°28'49" E |
| C3 | 172.46 | 25°39'55" | 385.00 | 171.02 | S 32°12'00" W |
| C4 | 345.55 | 299°58'15" | 66.00 | 66.03 | S 72°21'49" E |
| C5 | 185.80 | 161°18'05" | 66.00 | 130.25 | S 3°01'44" E |
| C6 | 159.74 | 138°40'10" | 66.00 | 123.51 | N 26°59'10" E |
| C7 | 55.08 | 6°59'51" | 451.00 | 55.05 | N 38°21'10" E |

REVISED 9/4/01 HOUSTON
REVISED 1/08/02 "AS BUILT"

OWNER: RICHARD PFEIL
175 W. JACKSON ST.
SUITE 631
CHICAGO, IL. 60604

KENNETH B. ABERNATHY, JR.
WISCONSIN REGISTERED LAND SURVEYOR
S-1594

Date: 1/21/99 Job No. 98209

I hereby certify that the above described property has been surveyed by me or under my direction and that the above map is a true representation thereof. It shows the size and location of the property, its exterior boundaries, the location of all visible structures and dimensions of all principal buildings thereon. It also shows all visible easements, roadways and visible encroachments, if any.
This survey is made for the use of the present owners of the property and also those who purchase, mortgage or guarantee the title thereto within one year from date hereof.

SCALE : 1"=60 FEET

Legend

- FOUND IRON PIPE
- FOUND IRON ROD
- FOUND BRASS CAPPED MONUMENT
- FOUND CONCRETE MONUMENT
- CHISEL CUT IN CONCRETE
- SET IRON ROD 24" LONG WEIGHING 1.5 LBS. LINEAL FT. 3/4" DIA.
- SET IRON ROD 30" LONG WEIGHING 4.5 LBS. LINEAL FT. 1" (1.16" DIA.
- (xx) RECORDED AS DIMENSION
- EXISTING FENCE

IA-3049-1
IA-2844-3

117-2119