
PREPARED FOR:
JERRY POLEK
N1849 LORAMOOR LN.
LAKE GENEVA, 53147

PLAT OF SURVEY

- OF -

LOT 2 CERTIFIED SURVEY MAP NO. 1211 LOCATED IN THE SOUTHEAST 1/4 OF SECTION 11, T.1.N., R.17.E, WALWORTH COUNTY, WISCONSIN.

J.K. SURVEYING INC.
N3705 WILLOWBEND LANE
LAKE GENEVA, WI, 53147
262-248-3697

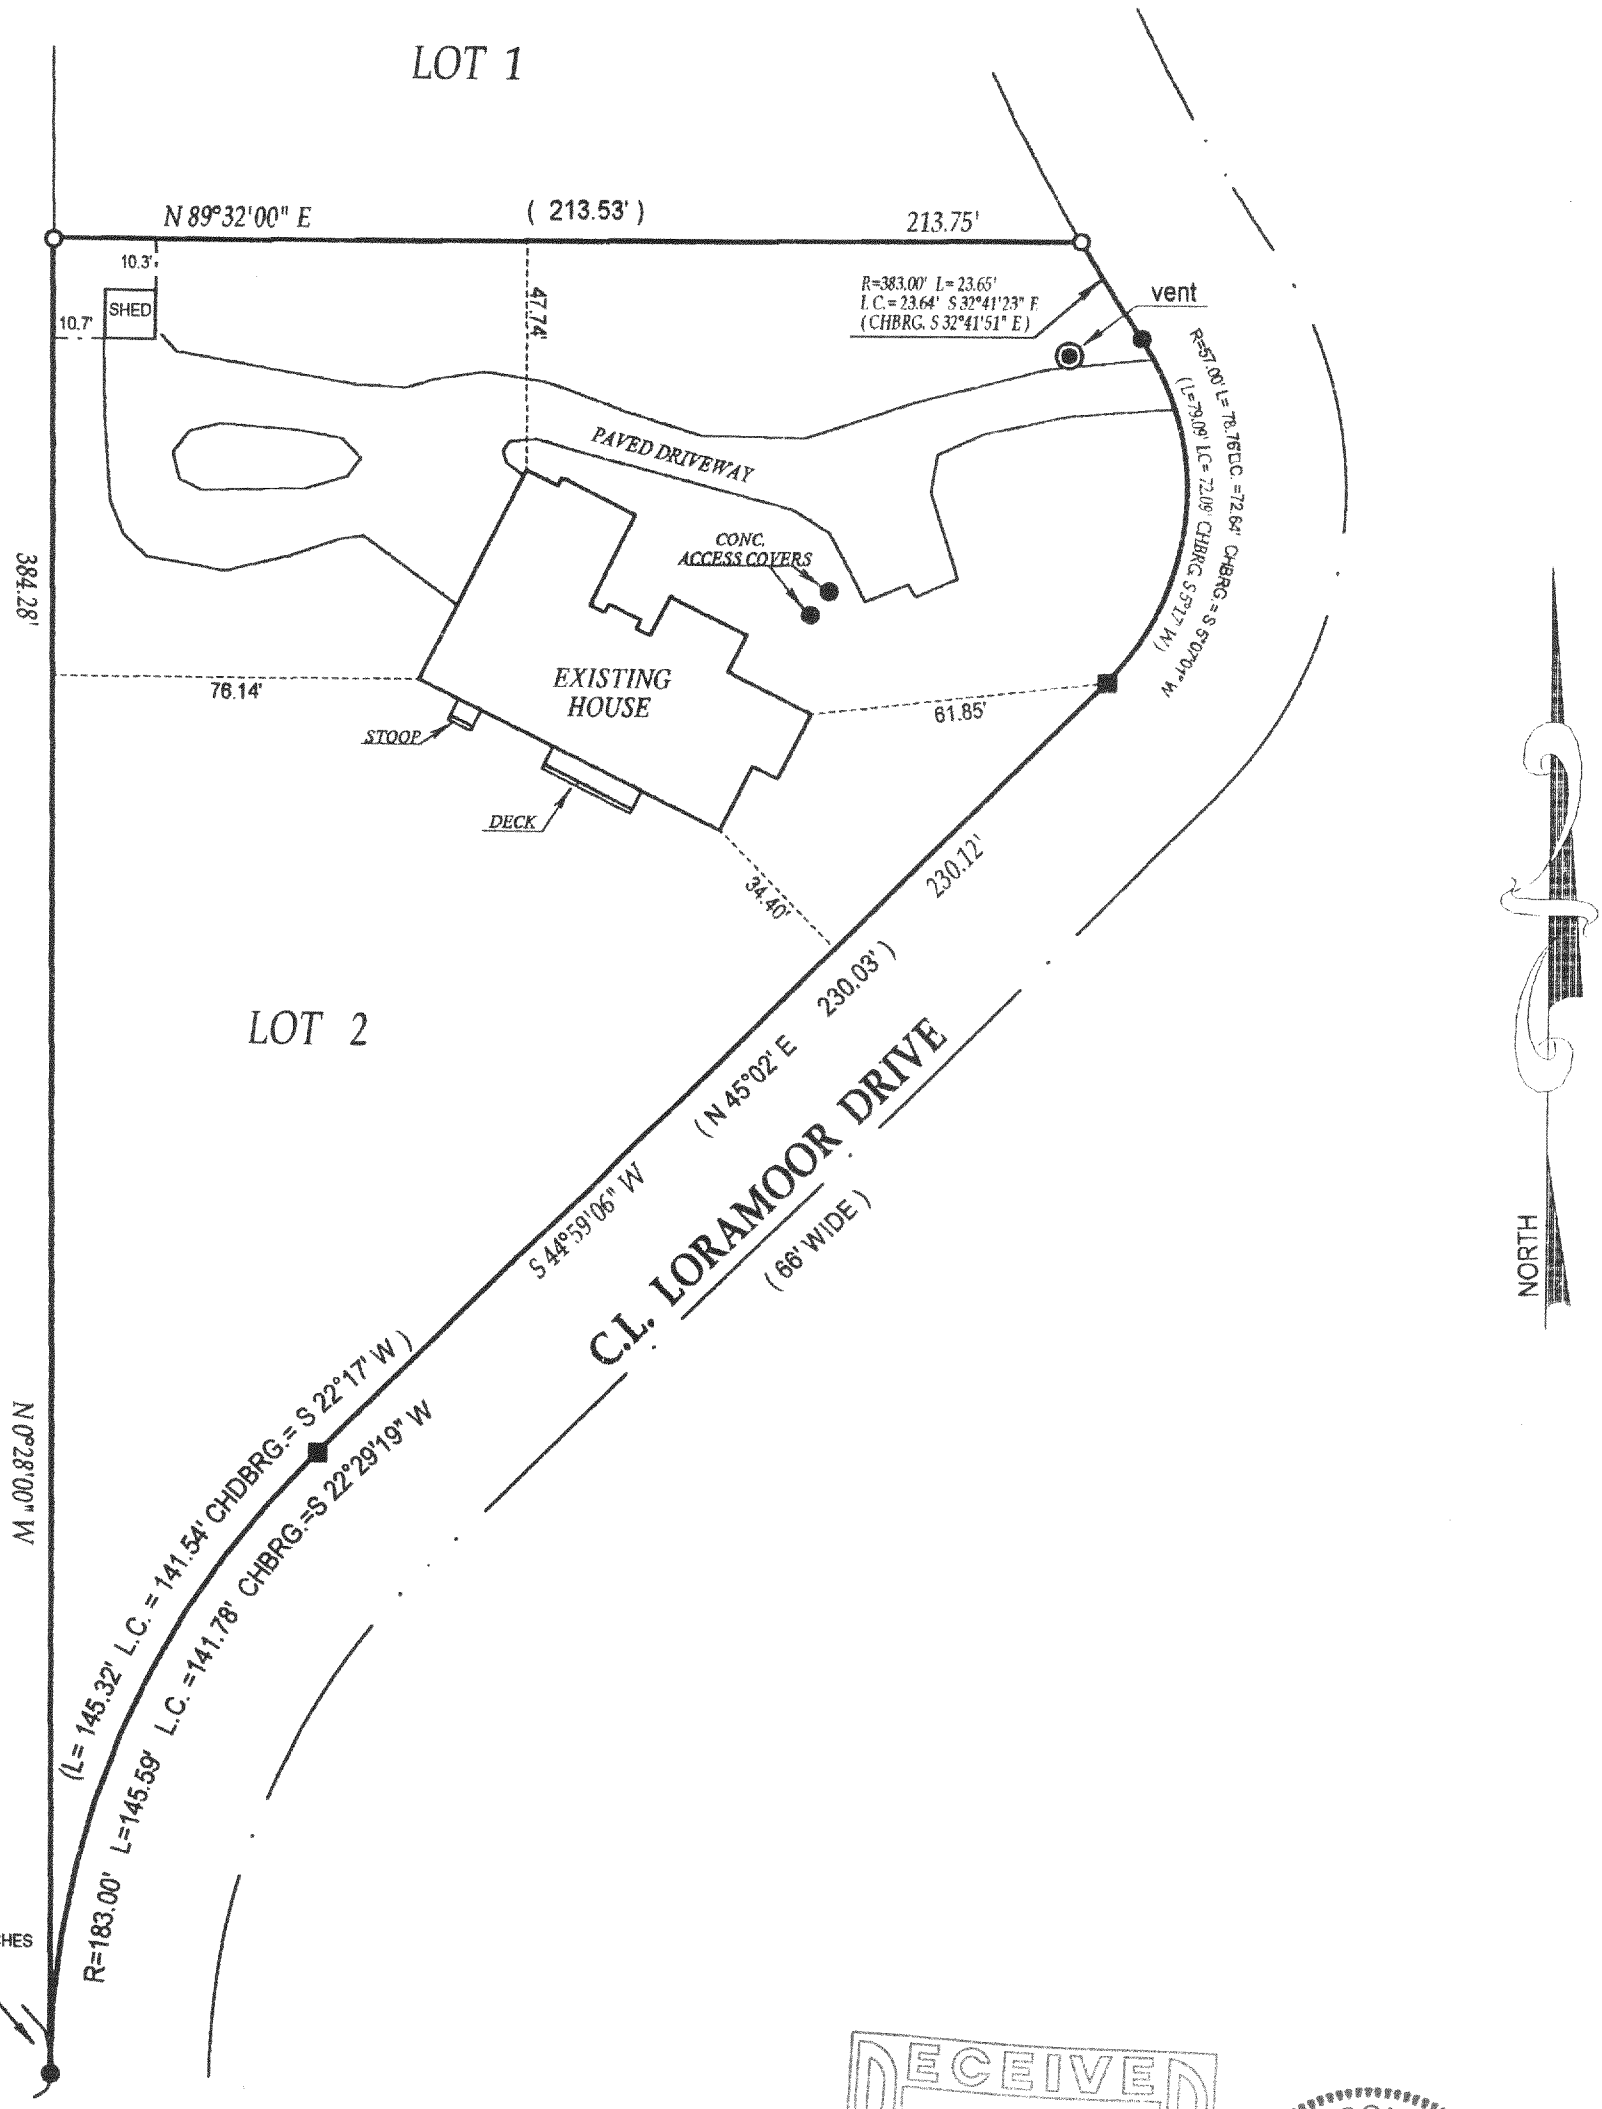

( )= recorded as

□ = found iron bar

○ = found iron pipe

● = set iron pipe

■ = set iron bar

SCALE 1" = 40'

JOB # 02-264

TAX ID # IA121100002

RECEIVED
AUG 16 2002

WISCONSIN
JOHN P. KROTT
S-2258
MUKWONAGO, WIS.
LAND SURVEYOR

DATE OF LAST REVISION 6 / 17 / 2002

COMPARE LEGAL DESCRIPTION ABOVE AND DRAWING WITH DEED. FOR BUILDING RESTRICTIONS AND EASEMENTS NOT SHOWN, REFER TO DEED, ABSTRACT SOURCES AND LOCAL MUNICIPAL CODES. NOTIFY THE SURVEYOR IMMEDIATELY OF ANY DISCREPANCY.

"I hereby certify that I have surveyed the above described property and that the above map is a true representation thereof and shows the size and location of all visible structures, apparent easements and encroachments if any."
This survey is made for the present owners of the property, and those who purchase, mortgage, or guarantee the title thereto, within one year from the date hereof.

DATED THIS 10 TH, DAY OF JUNE 20 02 .

JOHN KROTT S - 2258
Wisconsin Registered Land Surveyor
(original if signed in red)

117-2150