# Plat of Survey

ILGT-32B


of


## Lot 11 of Block 8 of Lake Geneva Terrace,

a subdivision located in the Northwest 1/4 of Section 15, Town 1 North, Range 17 East, Town of Linn, Walworth County, Wisconsin.

RECEIVED
SEP 19 2002
DH

Surveyed for: **Braden & Olson, LLP**
716 Wisconsin Street
P.O. Box 940
Lake Geneva, Wisconsin. 53147

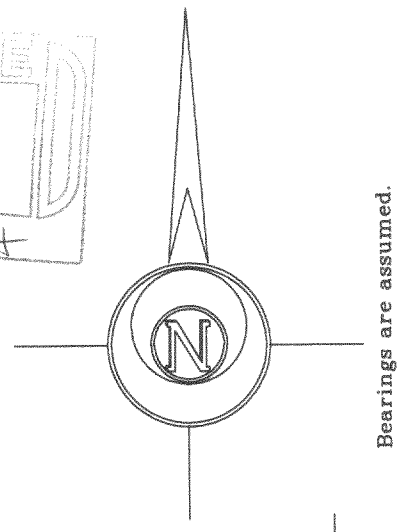

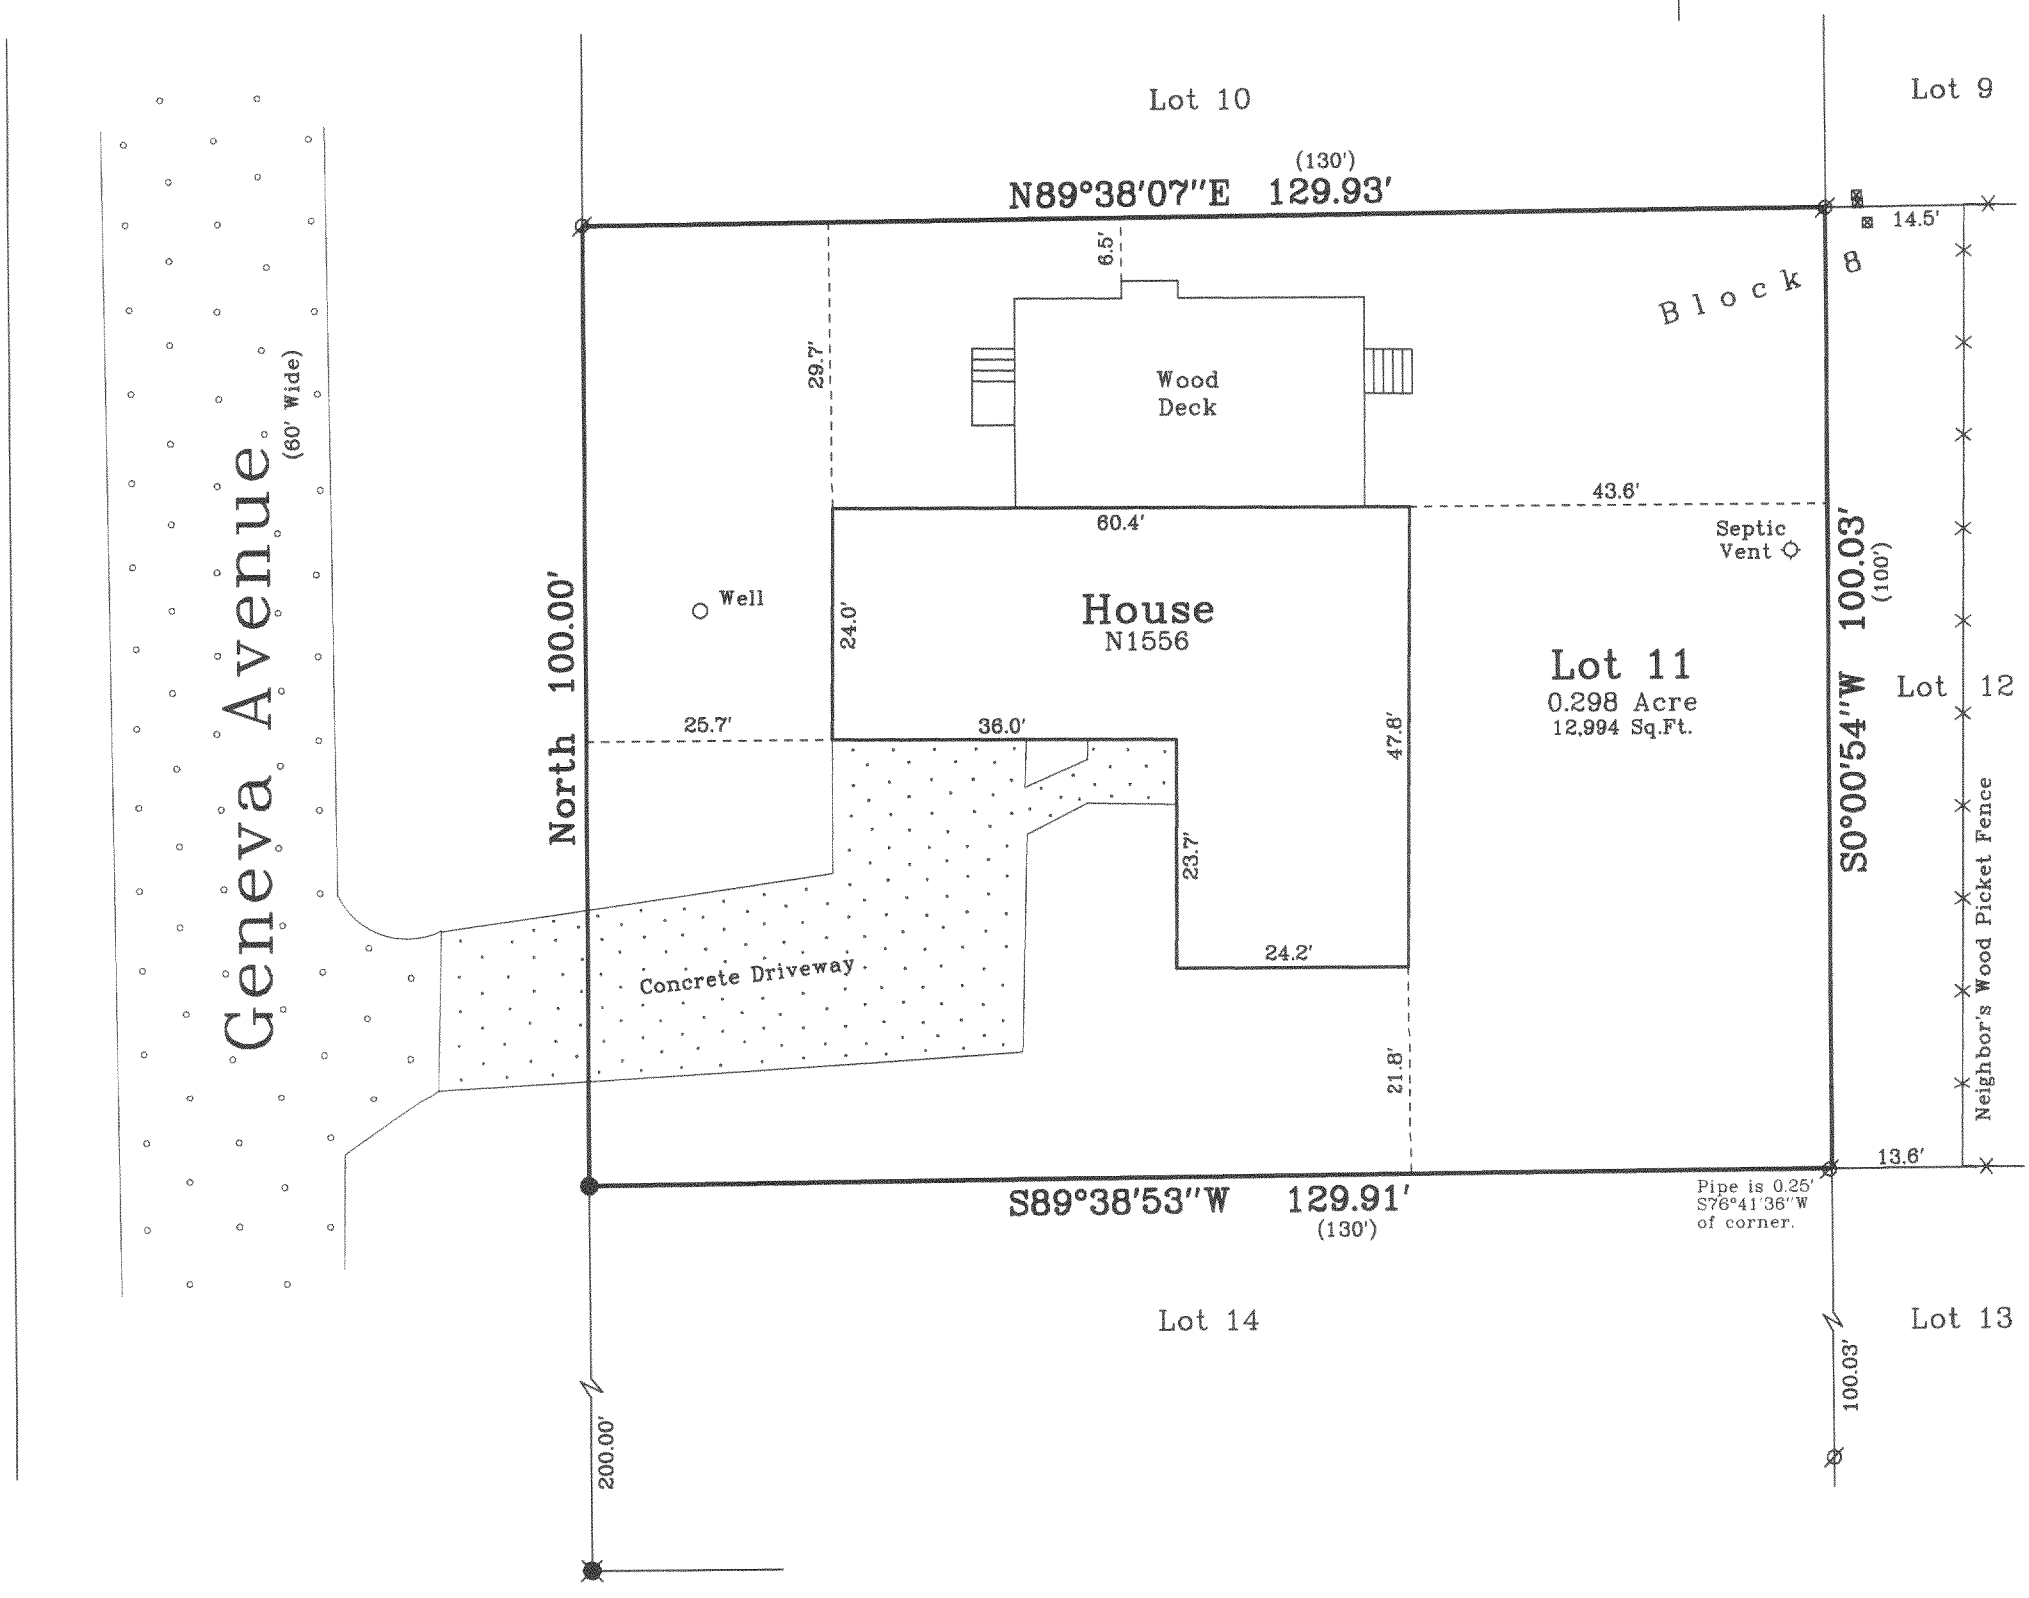
DOUGLAS G. OLSON
S-2093
ELKHORN, WI
LAND SURVEYOR
Not Certified Unless
Stamped in Red.

Copyright c 2001 by Jensen & Olson Land Surveying, LLC.

All rights reserved. No part of this survey plat may be reproduced or transmitted in any form by any means - graphic, electronic, or mechanical, including photocopying, tracing, or information storage and retrieval systems - without permission in writing from Douglas G. Olson, Jensen & Olson Land Surveying, LLC.

I hereby certify that I have surveyed the above described property and the map hereon is correct to the best of my professional knowledge and belief and shows the size and location of the property, its exterior boundaries, the location and dimensions of all visible structures thereon, boundary fences, apparent easements and roadways and visible encroachments, if any.

This survey is made for the exclusive use of the present owners of property, and also those who purchase, mortgage or guarantee title thereto, within one year from the date hereof.

Douglas G. Olson
Wisconsin Registered Land Surveyor - 2093

Notes:

1) This survey plat is not certified unless signed and sealed in red ink.

2) This survey is subject to Wisconsin lien laws. This Plat of Survey is the notice of intent to file lien. Lien waiver required.

Legend

- Ø Found Iron Pipe
- ■ Found Iron Rod
- ● Set Iron Rod
- ( ) Recorded Information
- ⊠ Utility Pedestal
- Concrete Surface
- Asphalt Surface

**Jensen & Olson Land Surveying, LLC**
45 South Wisconsin Street P.O. Box 322
Elkhorn, Wisconsin. 53121
Telephone: (262) 723-3434
Facsimile: (262) 723-8044

Scale: 1" = 20'

0' 10' 20' 40' 60'

Survey date: December 28, 2001.
Revisions:

Sheet 1 of 1 Sheets.

Job Reference Number:

2001.186 117-2168