
RECEIVED
NOV 1 2 2002
DA

ABELL
SURVEYING & MAPPING
1140 SEQUOIA STREET • DELAVAN, WISCONSIN 53115
262-728-6737

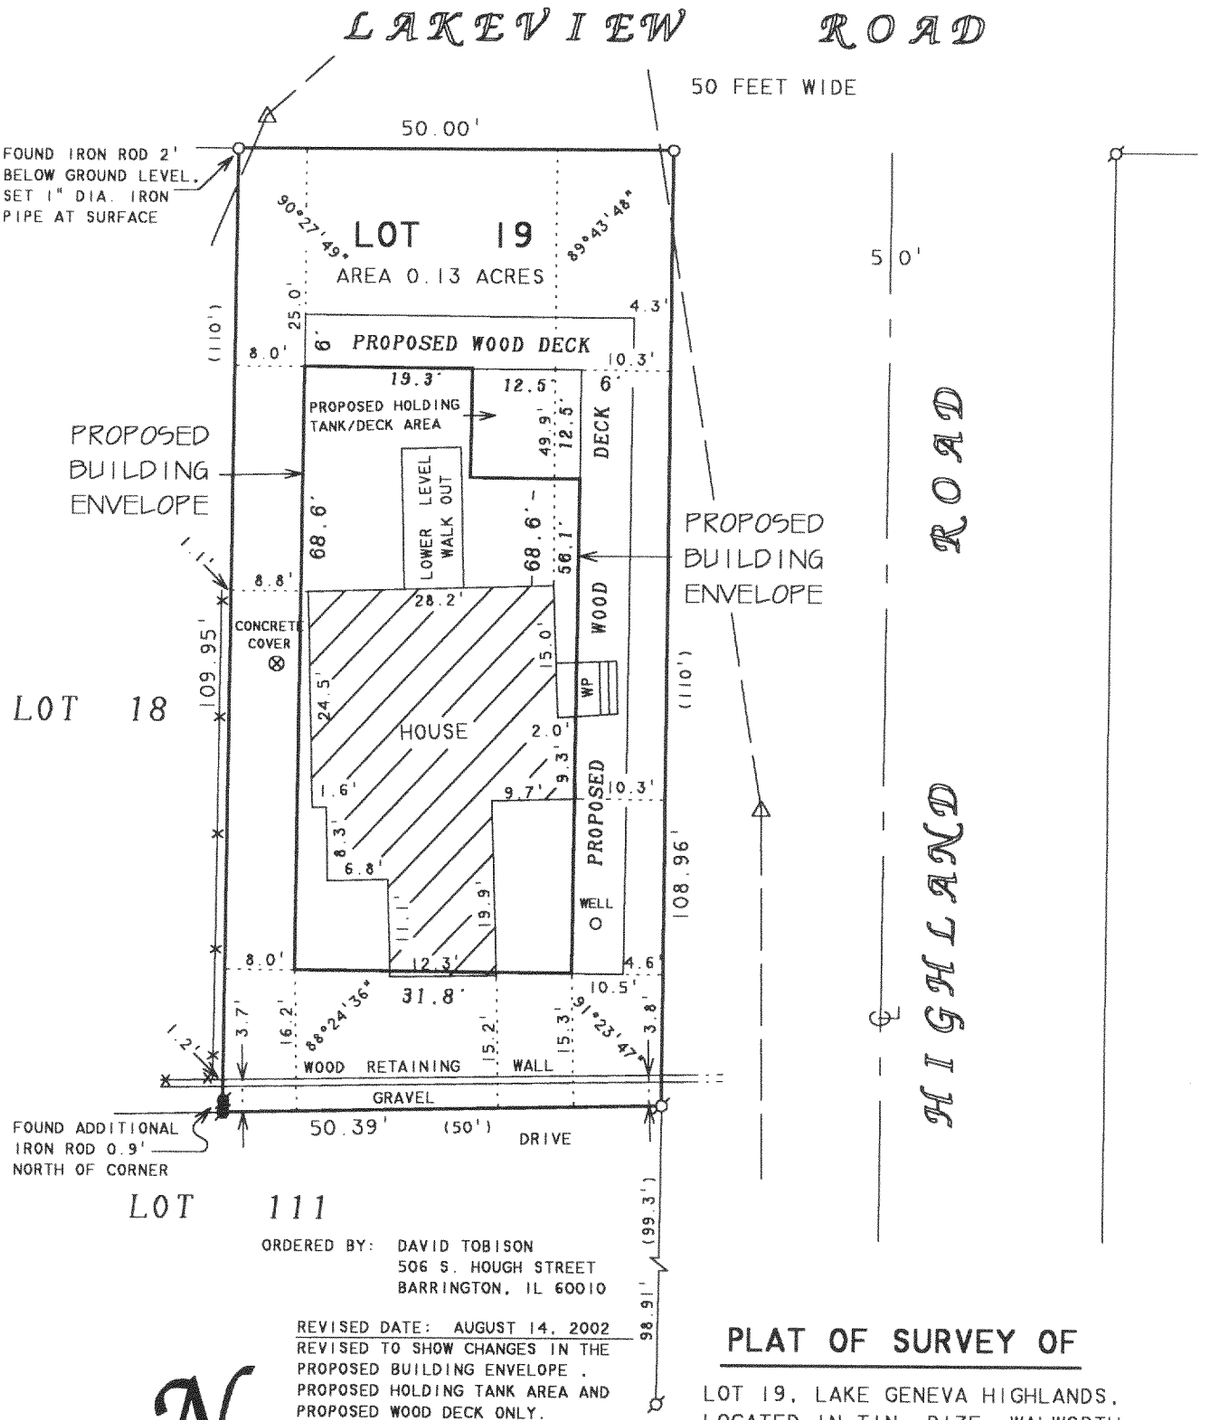

ORDERED BY: DAVID TOBISON
506 S. HOUGH STREET
BARRINGTON, IL 60010

REVISED DATE: AUGUST 14, 2002
REVISED TO SHOW CHANGES IN THE PROPOSED BUILDING ENVELOPE, PROPOSED HOLDING TANK AREA AND PROPOSED WOOD DECK ONLY.

REVISED DATE: JULY 19, 2002
REVISED TO SHOW PROPOSED BUILDING ENVELOPE AND PROPOSED HOLDING TANK AREA ONLY.

REVISED DATE: NOVEMBER 1, 2001
REVISED TO SHOW PROPOSED HOUSE ADDITION ONLY.

N

SCALE 1"=20'

PLAT OF SURVEY OF

LOT 19, LAKE GENEVA HIGHLANDS, LOCATED IN T1N, R17E, WALWORTH COUNTY, WISCONSIN.

LEGEND

- ⌀ -IRON PIPE FOUND
- ● -IRON ROD FOUND
- ○ -1" DIA. IRON PIPE SET
- -x-x- -CHAINLINK FENCE
- △ -UTILITY POLE
- WP -WOOD PORCH
- —— —— -OVERHEAD UTILITY LINES
- ( )-RECORDED AS

I, DAVID F. ABELL, DO HEREBY CERTIFY THAT I HAVE SURVEYED THE PROPERTY HEREON DESCRIBED ACCORDING TO THE OFFICAL RECORDS AND THAT THE PLAT HEREON IS A CORRECT REPRESENTATION OF THE PROPERTY LINES TO THE BEST OF MY KNOWLEDGE AND BELIEF.

David F. Abell

DAVID F. ABELL
WISCONSIN REGISTERED LAND SURVEYOR, S-1596

October 25, 2000

DATE JOB NUMBER - 00148C

NOTE: THIS IS NOT A CERTIFIED COPY UNLESS SEALED.

ILGH-18

117-2193