


DUNHAM SURVEYING, S.C.
SURVEYING & SUBDIVIDING
DELAVER, WISCONSIN 53115

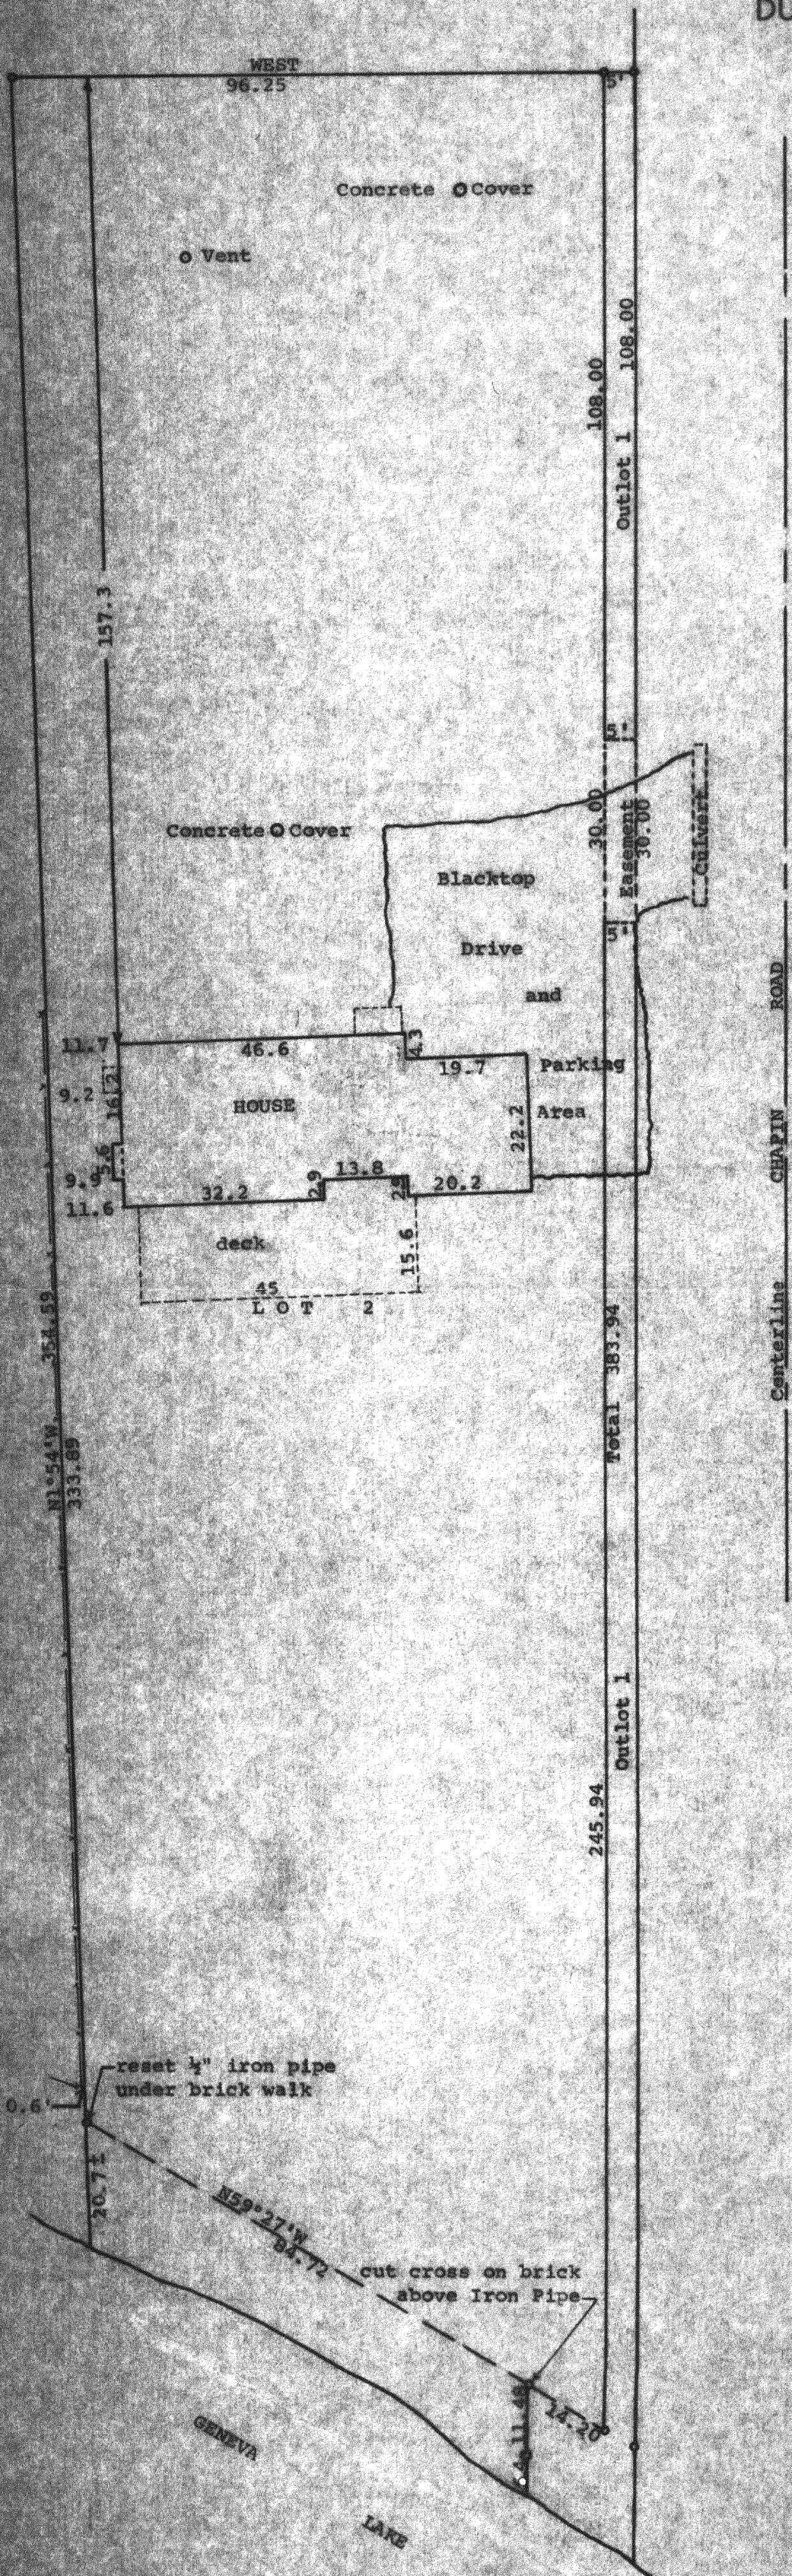

Scale - 1" = 20'

o = Iron Pipe

- - - = Fence Line

Updating and recertification ordered by:
Keefe Real Estate, Inc.
Lake Geneva, WI 53147

STATE OF WISCONSIN)
COUNTY OF WALWORTH) SS

I, George T. Dunham, Surveyor, certify that I have surveyed the property described as follows:

Lot 2 of Certified Survey No. 562, recorded in Volume 3 of Certified Surveys on Page 6, in the Office of the Register of Deeds, Elkhorn, Wisconsin, together with a perpetual easement for the purpose of ingress and egress from said lot 2 to Chapin Road over the following described portion of Outlot 1 of said Certified Survey No. 562; Commencing at the northeast corner of said Outlot 1; thence South along the east line of said Outlot 1, 108.00 feet to the place of beginning; thence continue South along said east line 30.00 feet; thence West 5.00 feet; thence North 30.00 feet; thence East 5.00 feet to the place of beginning, which perpetual easement shall be used in common with the owner or owners of said Outlot 1. Said land being located in the Northwest 1/4 of Fractional Section 4, T1N, R17E, Walworth County, Wisconsin.

and that the map shown hereon is a true representation thereof and shows the size and location of the property, its exterior boundaries, the location of all visible structures and dimensions of all principal buildings thereon, boundary fences, apparent easements, roadways and visible encroachments, if any.

This survey is made for the use of the present owners of the property, and also those who purchase, mortgage, or guarantee the title thereto within one (1) year from date hereof.

October 27, 1980

Updated and recertified to this
7th day of June, 2000

George T. Dunham
George T. Dunham, Surveyor

