
AMBIT LAND SURVEYING
P. O. Box 42
Bassett, WI 53101

PLAT OF SURVEY

PHONE 262-537-4874
FAX 262-537-4221

OF

Lot 21, Block 8 of LAKE GENEVA TERRACE, being a subdivision of the West Half of the Northwest Quarter of Section 15, Township 1 North, Range 17 East of the 4th Principal Meridian, Town of Linn, Walworth County, Wisconsin.

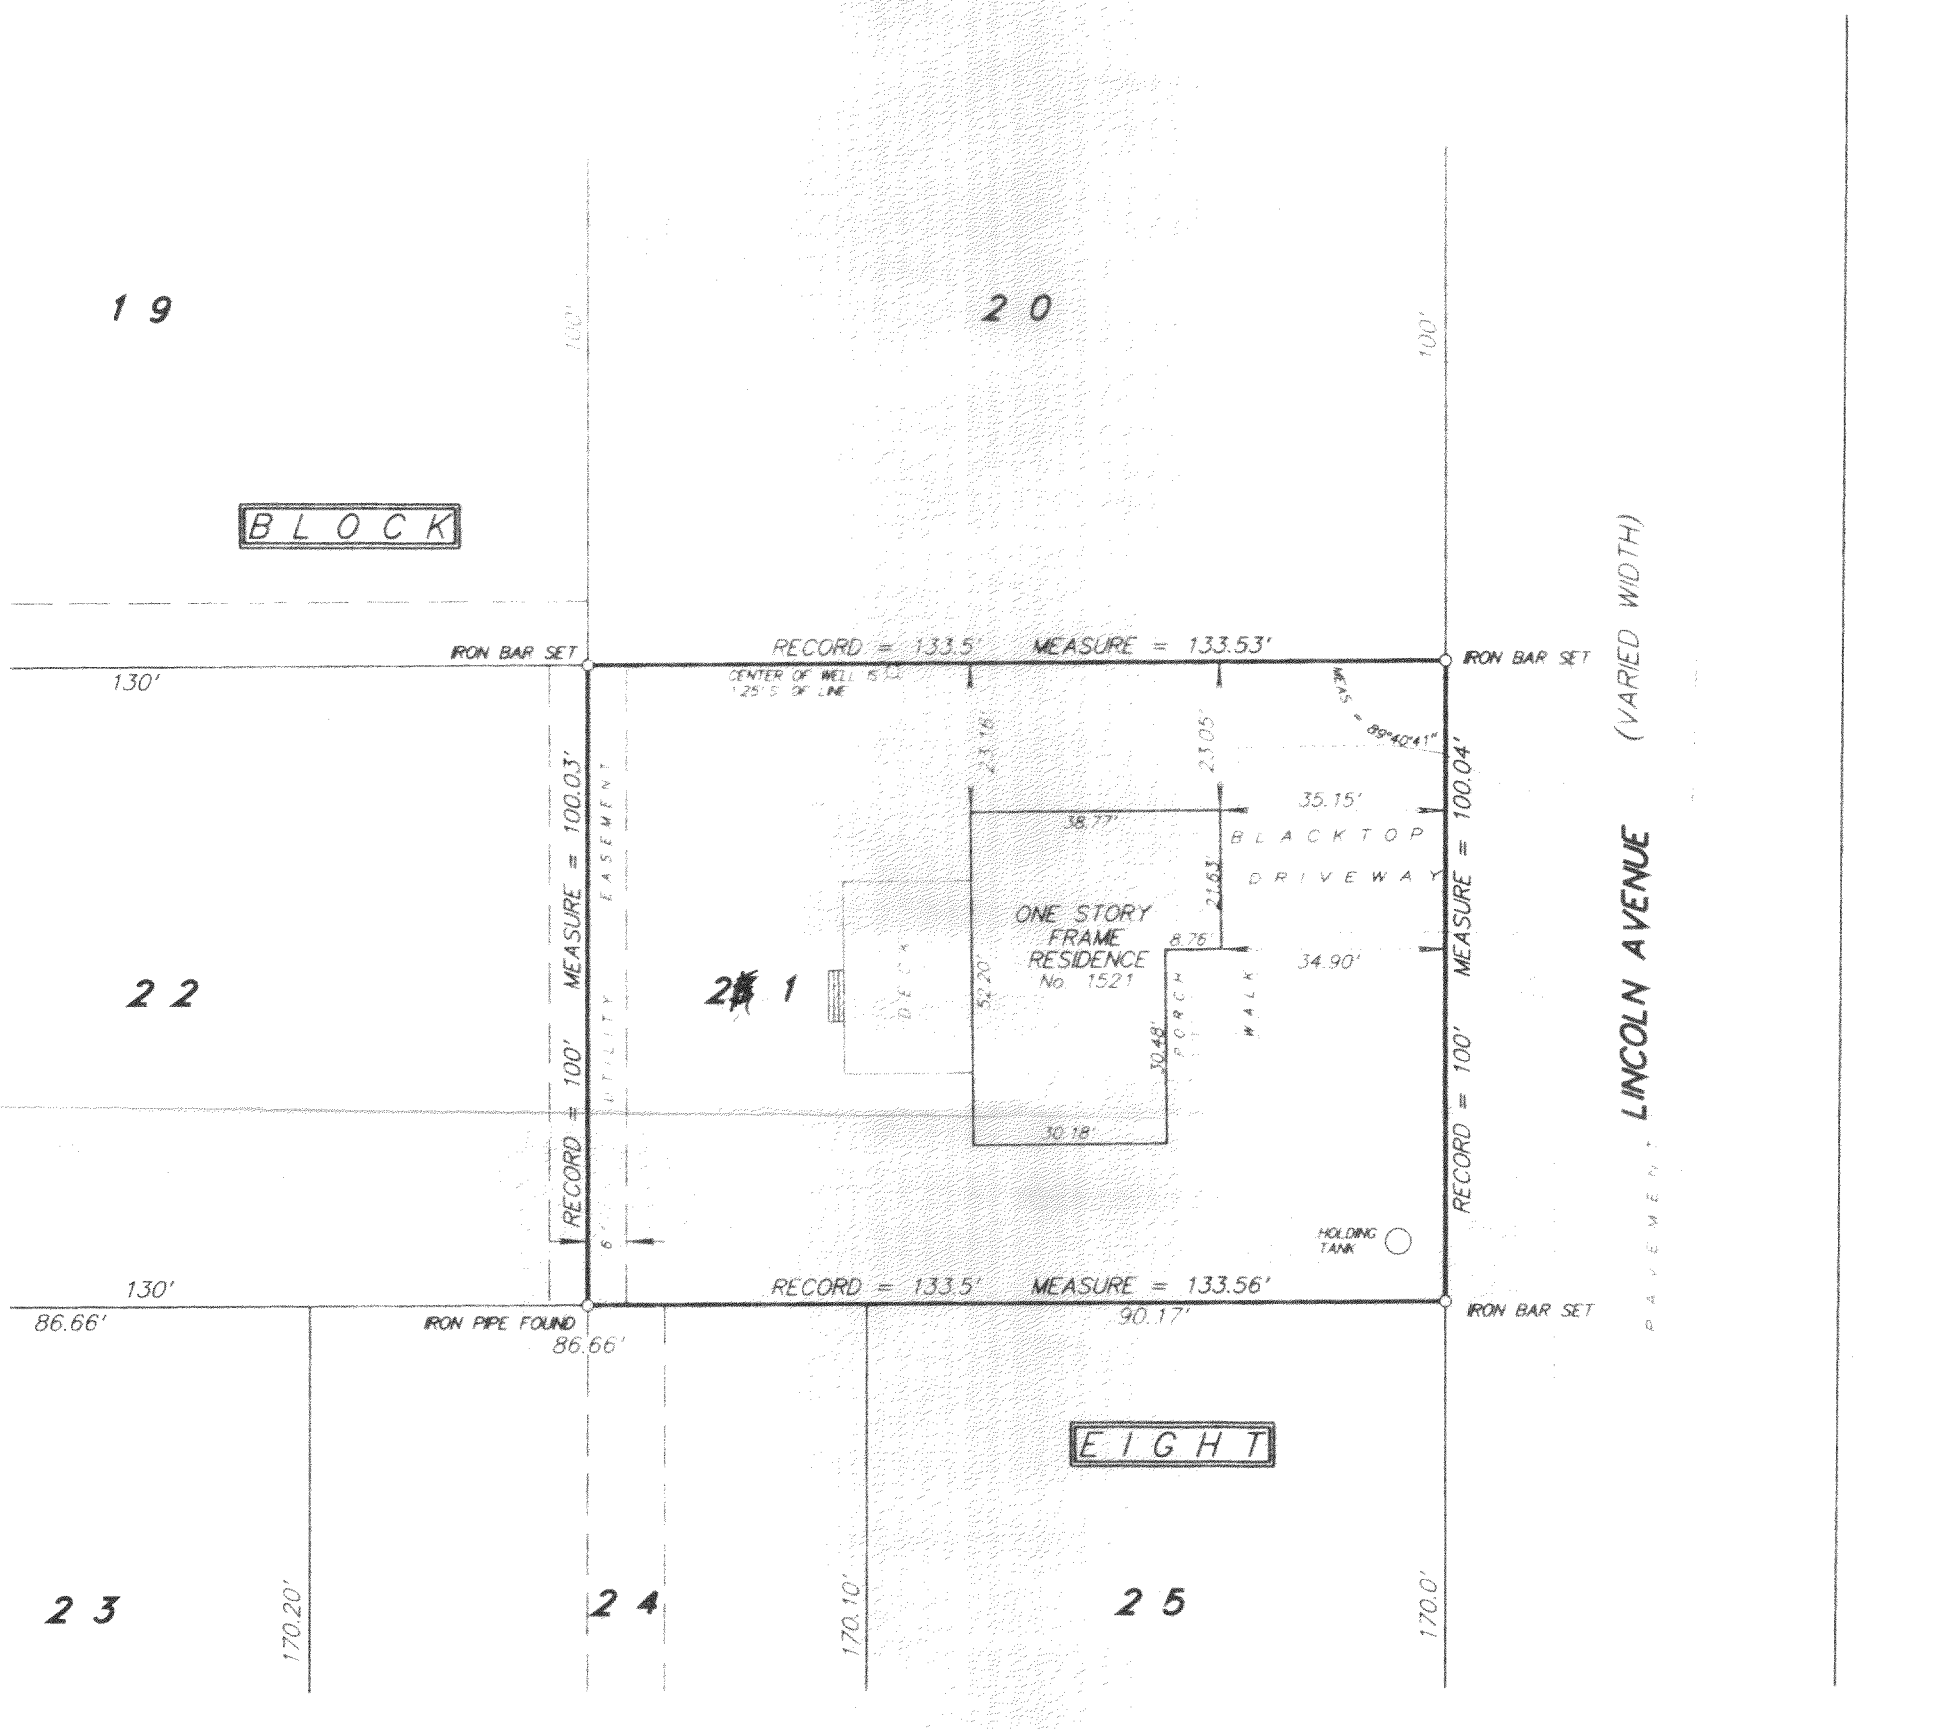

SCALE 1 inch = 30 feet

ORDERED BY T. Vanmaren / Keefe Real Estate

JOB NO. 0 3 0 9 1

RECEIVED
JUN - 5 2003
KW

I hereby certify that I have surveyed the above described property and the above plat is a true representation thereof and shows the size and location of the property, its exterior boundaries, the location and dimensions of all visible structures thereon, boundary fences, apparent easements and roadways and visible encroachments, if any.

This survey is made for the exclusive use of the present owners of the property, and also those who purchase, mortgage, or guarantee the title thereto within one year from the date hereof.

Dated at Bassett, Wisconsin this _____ day of _____ 2003.

Mark A. Bolender
Wisconsin Registered Land Surveyor S - 1784

ILGT-3204

117-2300