
ABERNATHY and ASSOCIATES
Kenneth B. Abernathy Jr.
Wisconsin Registered Land Surveyor S-1594

W4056 BRAY RD.
ELKHORN, WI. 53121
PHONE: (262) 723-4260 (OFFICE)
(262) 723-7209 (FAX)
Email: abernathy@elknet.net

PLAT OF SURVEY

Lot 72
LAKE GENEVA HIGHLANDS SUBDIVISION

LOCATED IN SECTION 8, TOWN 1 NORTH, RANGE 17 EAST,
WALWORTH COUNTY, WISCONSIN

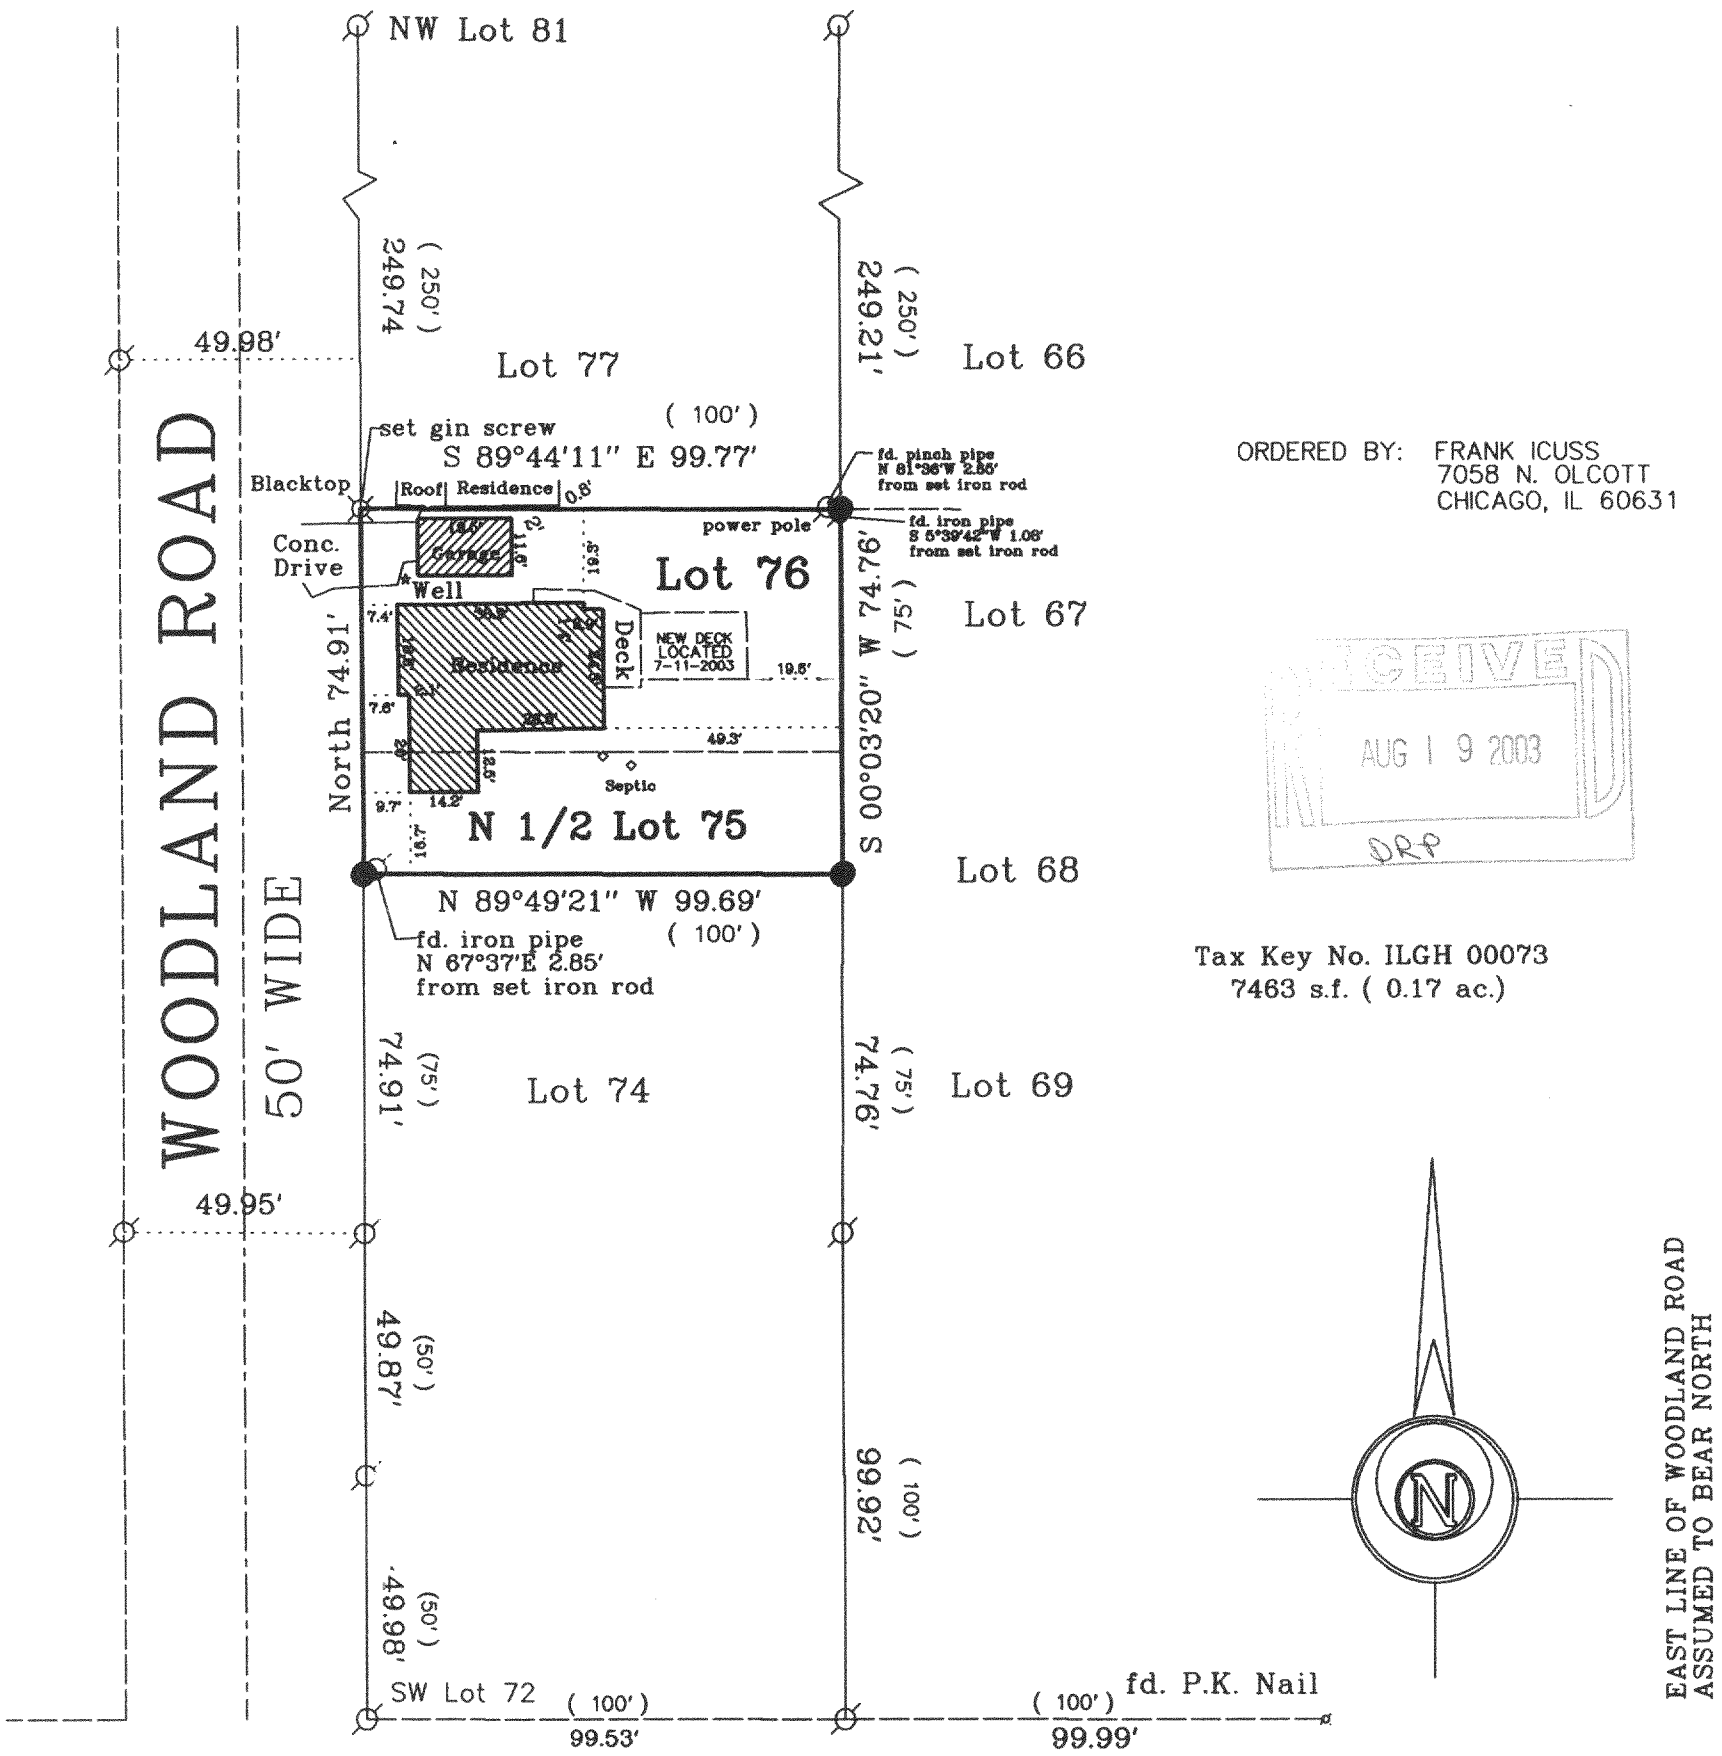

ORDERED BY: FRANK ICUSS
7058 N. OLCOTT
CHICAGO, IL 60631

RECEIVED
AUG 19 2003
DRP

Tax Key No. ILGH 00073
7463 s.f. (0.17 ac.)

SCALE: 1" = 40 **FEET**

LEGEND

- ⌀ **FOUND IRON PIPE**
- ⌀ **FOUND IRON ROD**
- ⊠ **FOUND BRASS CAPPED MONUMENT**
- ○ **FOUND CONCRETE MONUMENT**
- \+ **CHISEL CUT IN CONCRETE**
- ● **SET IRON ROD, 24" LONG, WEIGHING 1.5 LBS./LINEAL FT., 3/4" DIA.**
- ● **SET IRON ROD, 30" LONG, WEIGHING 4.5 LBS./LINEAL FT., 1-11/16" DIA.**
- (x x x) **RECORDED AS DIMENSION**
- -x-x-x-x- **EXISTING FENCE**

WISCONSIN
KENNETH B. ABERNATHY, JR.
S-1594
ELKHORN
WI
LAND SURVEYOR

REVISED JULY 11, 2003
TO SHOW DECK ADDITION

"I hereby certify that the above described property has been surveyed by me or under my direction and that the above map is a true representation thereof and shows the size and location of the property, its exterior boundaries, the location of all visible structures and dimensions of all principal buildings thereon, boundary fences, apparent easements, roadways and visible encroachments, if any."
"This survey is made for the use of the present owners of the property, and also those who purchase, mortgage, or guarantee the title thereto within one year from the date hereof."

Kenneth B. Abernathy

KENNETH B. ABERNATHY, JR. S-1594
WISCONSIN REGISTERED LAND SURVEYOR,

DATED Oct. 22, 2002 Job No. 02.1007

ILGH-73

117-2320