
HAROLD H. KOLB

REGISTERED PROFESSIONAL LAND SURVEYOR
LAKE GENEVA, WISCONSIN

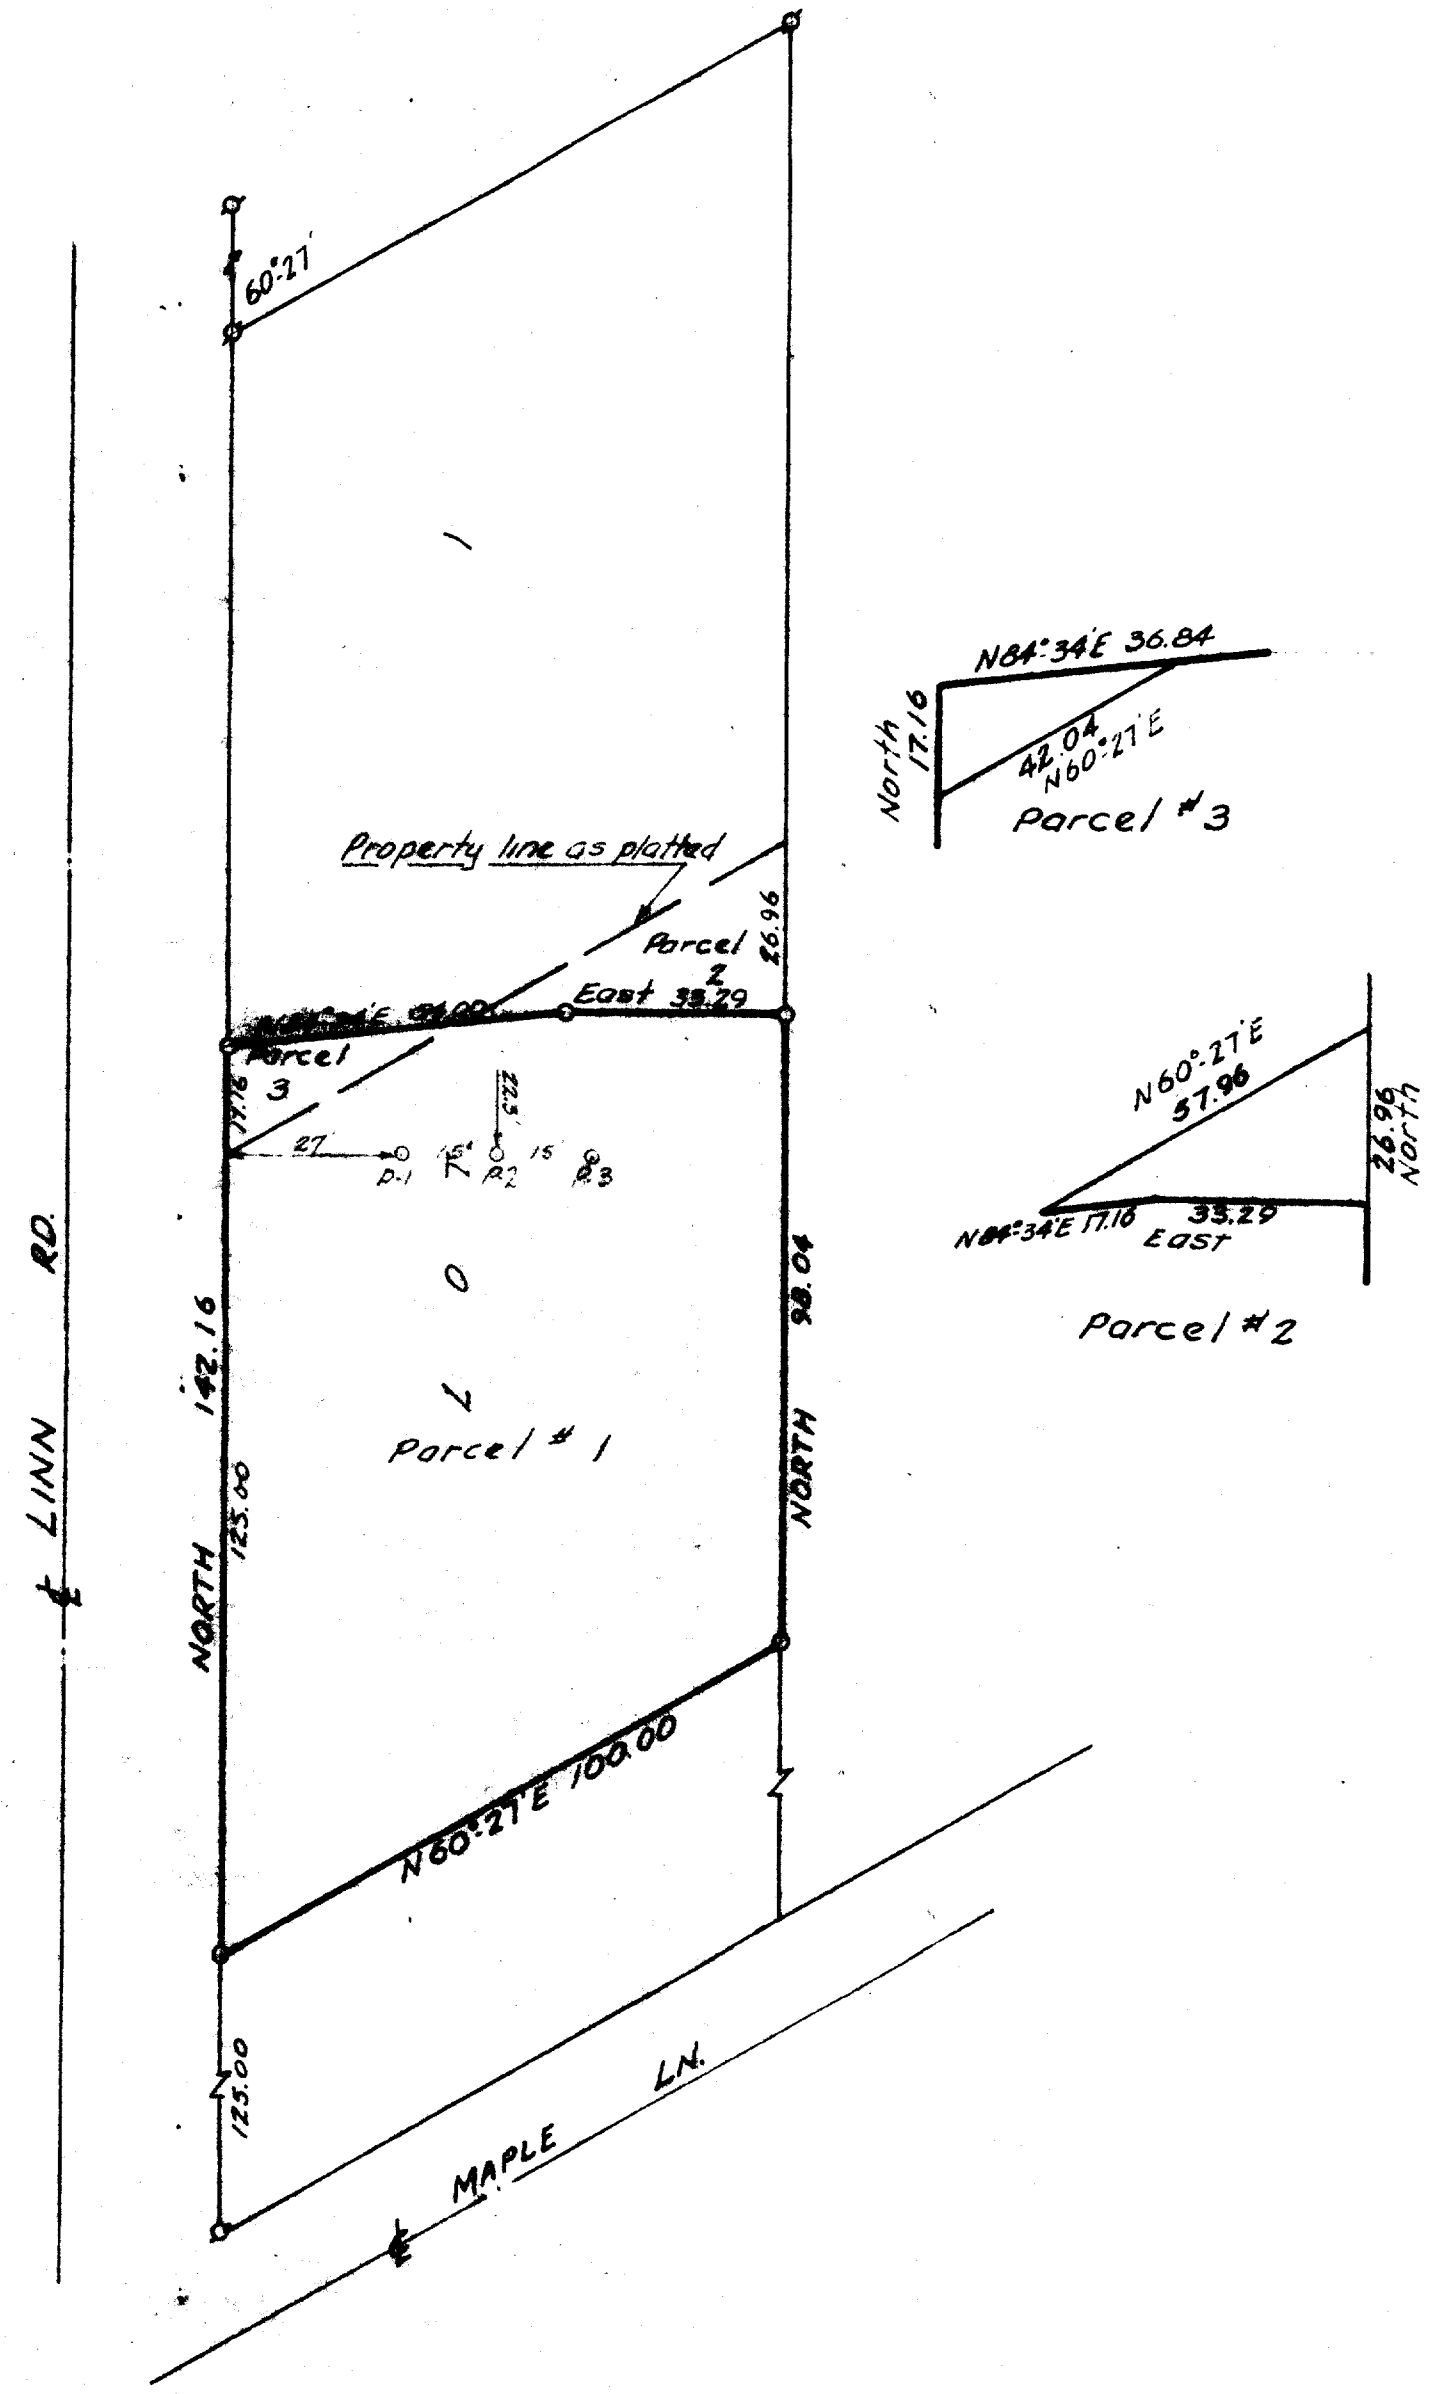

N

LEGEND

- ⌀ — IRON PIPE FOUND
- O — IRON PIPE PLACED
- ● — CONCRETE MONUMENT
- X — SPIKE

SCALE - 1" = 30'

TBA - 1, 2

WISCONSIN
HAROLD H. KOLB
S-187
LAKE GENEVA, WIS.
LAND SURVEYOR

Soil Type - Miami SiH Loam

I, HAROLD H. KOLB, DO HEREBY CERTIFY THAT I HAVE SURVEYED THE PROPERTY HEREON DESCRIBED ACCORDING TO THE OFFICIAL RECORDS, AND THAT THE PLAT HEREON IS A CORRECT REPRESENTATION OF THE LOT LINES.

Harold H. Kolb

HAROLD H. KOLB
WISCONSIN REGISTERED LAND SURVEYOR, S-187
DATE Sept. 13, 1969
Revised - Sept. 16, 1969

117-234

Sheet 2 of 2

HAROLD H. KOLB

REGISTERED PROFESSIONAL LAND SURVEYOR
LAKE GENEVA, WISCONSIN

PARCEL #1

A parcel of land being part of Lot 1, The Birches Subd., T 1 N , R 17 E, Walworth County, Wisconsin and described as follows; to-wit: Commencing at the Southwest corner of said Lot 1, thence North 1[illegible].00 feet to the place of beginning; thence continue North 142.16 feet; thence N 84°34' E 54.00 feet; thence East 35.29 feet; thence South 98.04 feet; thence S 60°27' W 100.00 feet to the place of beginning.

PARCEL #2

Commencing at the Southwest corner of said Lot 1, thence North 267.15 feet; thence N 84°34' E 36.84 feet to the place of beginning; thence N 60°27' E 57.96 feet; thence South 26.96 feet; thence West 35.29 feet; thence S 84°34' W 17.16 feet to the place of beginning.

PARCEL #3

Commencing at the Southwest corner of said Lot1, thence North 250.00 feet to the place of beginning; thence continue North 17.16 feet; thence N 84°34' E 36.84 feet; thence S 60°27' W 42.04 feet to the place of beginning.

LEGEND

- ⌀ — IRON PIPE FOUND
- ○ — IRON PIPE PLACED
- ● — CONCRETE MONUMENT
- x — SPIKE

I, HAROLD H. KOLB, DO HEREBY CERTIFY THAT I HAVE SURVEYED THE PROPERTY HEREON DESCRIBED ACCORDING TO THE OFFICIAL RECORDS, AND THAT THE PLAT HEREON IS A CORRECT REPRESENTATION OF THE LOT LINES.

Harold H. Kolb

HAROLD H. KOLB
WISCONSIN REGISTERED LAND SURVEYOR, S-187
DATE Sept. 16, 1969

117-234