
PREPARED FOR:
PEGGY BENTLY
KEEFE REAL ESTATE, INC
751 GENEVA PARKWAY
LAKE GENEVA, WI
53147

J.K. SURVEYING INC.
N3705 WILLOWBEND LANE
LAKE GENEVA, WI, 53147
262-248-3697

PLAT OF SURVEY

- OF -


LOT 16 OF LAKE GENEVA HIGHLANDS, A SUBDIVISION LOCATED IN THE SOUTHEAST FRACTIONAL 1/4 OF SECTION 8, TOWN 1 NORTH, RANGE 17 EAST , WALWORTH COUNTY , WISCONSIN.

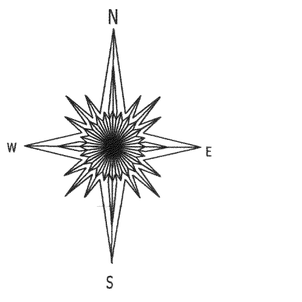

BEARINGS REFERENCED TO PREVIOUS SURVEY OF RECORD

0 10 20 30

SCALE 1" = 10'

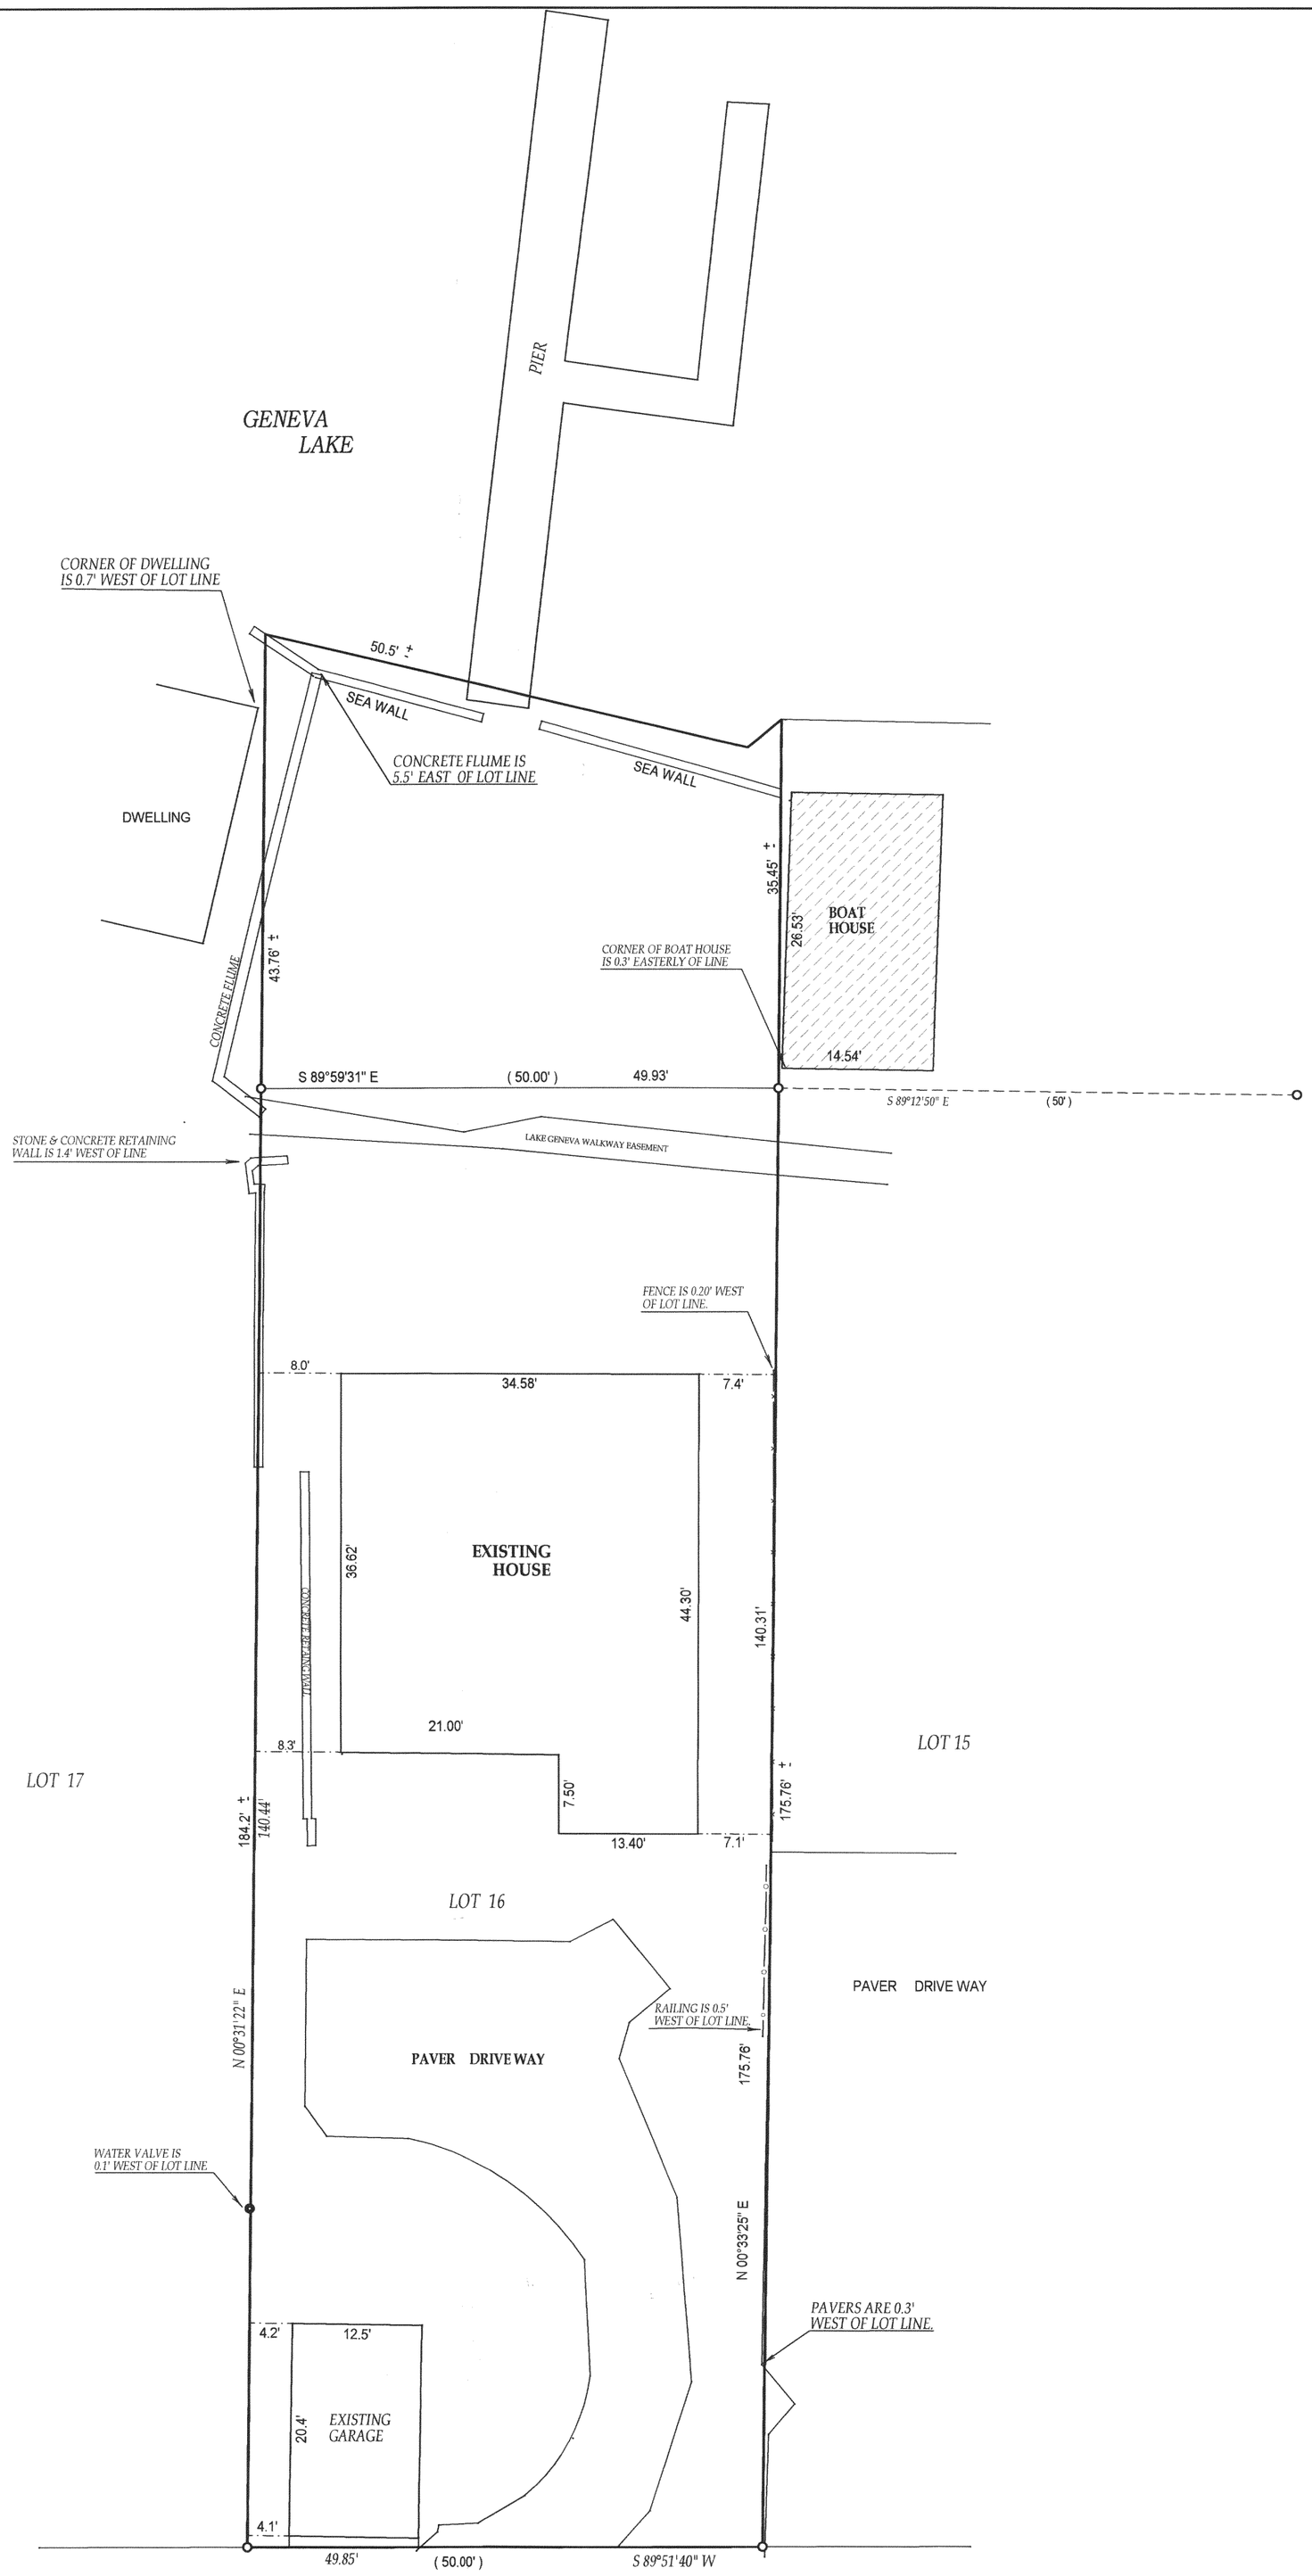

( )= recorded as

□ = found iron bar

○ = found iron pipe

● = set iron pipe

■ = set iron bar

SCALE 1" = 10'

JOB # 04-270

TAX ID # ILGH00016

COMPARE LEGAL DESCRIPTION ABOVE AND DRAWING WITH DEED. FOR BUILDING RESTRICTIONS AND EASEMENTS NOT SHOWN,REFER TO DEED, ABSTRACT SOURCES AND LOCAL MUNICIPAL CODES. NOTIFY THE SURVEYOR IMMEDIATELY OF ANY DISCREPANCY.

"I hereby certify that I have surveyed the above described property and that the above map is a true representation thereof and shows the size and location of all visible structures, apparent easements and encroachments if any."
This survey is made for the present owners of the property, and those who purchase, mortgage, or guarantee the title thereto, within one year from the date hereof.

DATED THIS 23rd , DAY OF JUNE , 2004

RECEIVED
AUG 13 2004

WISCONSIN
JOHN P. KROTT S-2258 LAKE GENEVA, WIS.
LAND SURVEYOR

JOHN KROTT S - 2258
Wisconsin Registered Land Surveyor
(original if signed in red)

117-2444