PLAT OF SURVEY
SITE, GRADING, DRAINAGE, & EROSION CONTROL PLAN

LOT 2 OF CERTIFIED SURVEY MAP NO. 2582

LOCATED IN THE NE 1/4 OF SECTION 4,
TOWN 1 NORTH, RANGE 17 EAST,
WALWORTH COUNTY, WISCONSIN

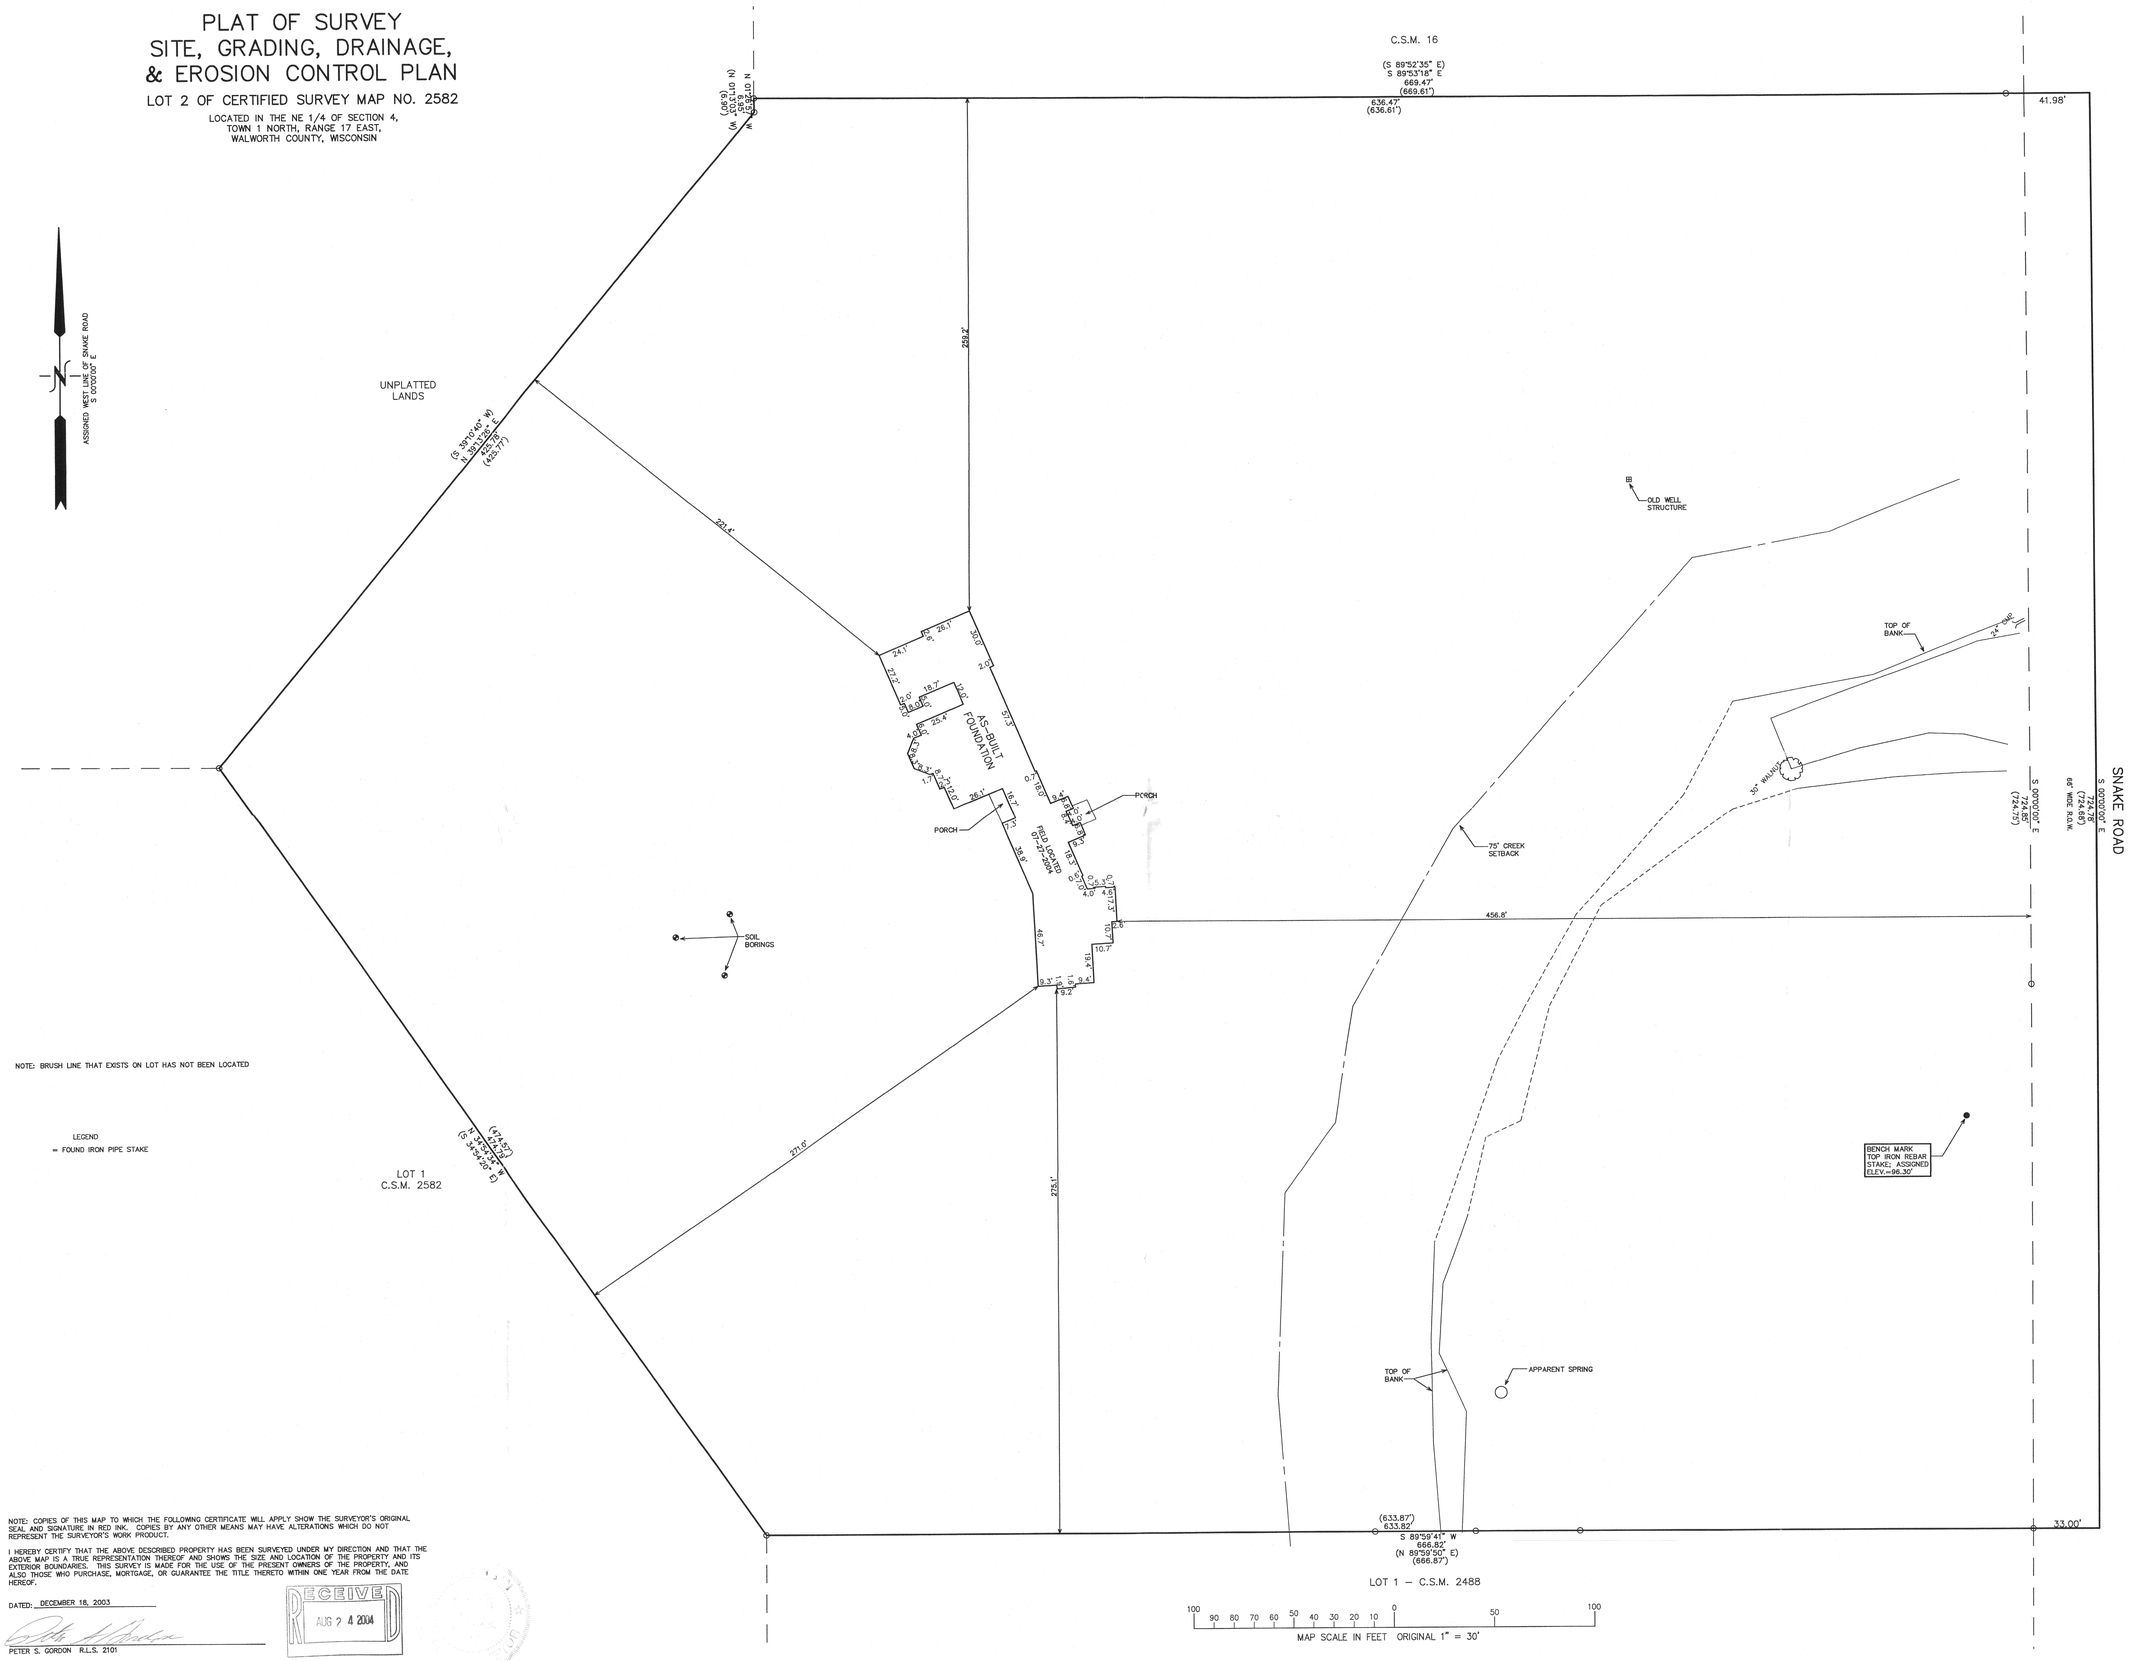

NOTE: COPIES OF THIS MAP TO WHICH THE FOLLOWING CERTIFICATE WILL APPLY SHOW THE SURVEYOR'S ORIGINAL SEAL AND SIGNATURE IN RED INK. COPIES BY ANY OTHER MEANS MAY HAVE ALTERATIONS WHICH DO NOT REPRESENT THE SURVEYOR'S WORK PRODUCT.

I HEREBY CERTIFY THAT THE ABOVE DESCRIBED PROPERTY HAS BEEN SURVEYED UNDER MY DIRECTION AND THAT THE ABOVE MAP IS A TRUE REPRESENTATION THEREOF AND SHOWS THE SIZE AND LOCATION OF THE PROPERTY AND ITS EXTERIOR BOUNDARIES. THIS SURVEY IS MADE FOR THE USE OF THE PRESENT OWNERS OF THE PROPERTY, AND ALSO THOSE WHO PURCHASE, MORTGAGE, OR GUARANTEE THE TITLE THERETO WITHIN ONE YEAR FROM THE DATE HEREOF.

DATED: DECEMBER 18, 2003

PETER S. GORDON R.L.S. 2101

RECEIVED AUG 2 4 2004

7/29/2004 N:\Projects\6434\Dwg\6434.dwg

IA2582000002

117-2466

– WORK ORDERED BY –
TOM STELLING
STELLING ARCHITECTS
181 WEST CHEASTNUT STREET
BURLINGTON, WI 53105

FARRIS, HANSEN & ASSOCIATES, INC.
ENGINEERING – ARCHITECTURE – SURVEYING
7 RIDGWAY COURT P.O. BOX 437
ELKHORN, WISCONSIN 53121
OFFICE: (262) 723-2098 FAX: (262) 723-5886

REVISIONS

03/12/2004
MISC. REVISIONS KJD

07/29/2004
SHOW SIZE & LOCATION OF AS-BUILT FOUNDATION KJD

PROJECT NO.
6434
DATE
12/18/2003
SHEET NO.
1 OF 1