Plat of Survey

of

Lot 2 of Certified Survey Map No. 795,


recorded in Vol. 3 of Certified Survey Maps of Walworth County on Page 335 and located in the Northwest 1/4 of Section 4, Town 1 North, Range 17 East, Town of Linn, Walworth County, Wisconsin.

Surveyed for: **Don & Sandy Roberts**
W4029 Glen Fern Lane
Lake Geneva, Wisconsin. 53147

Note:

The proposed house addition is shown as instructed by the owner.

All setbacks must be approved by the building inspector PRIOR to construction.

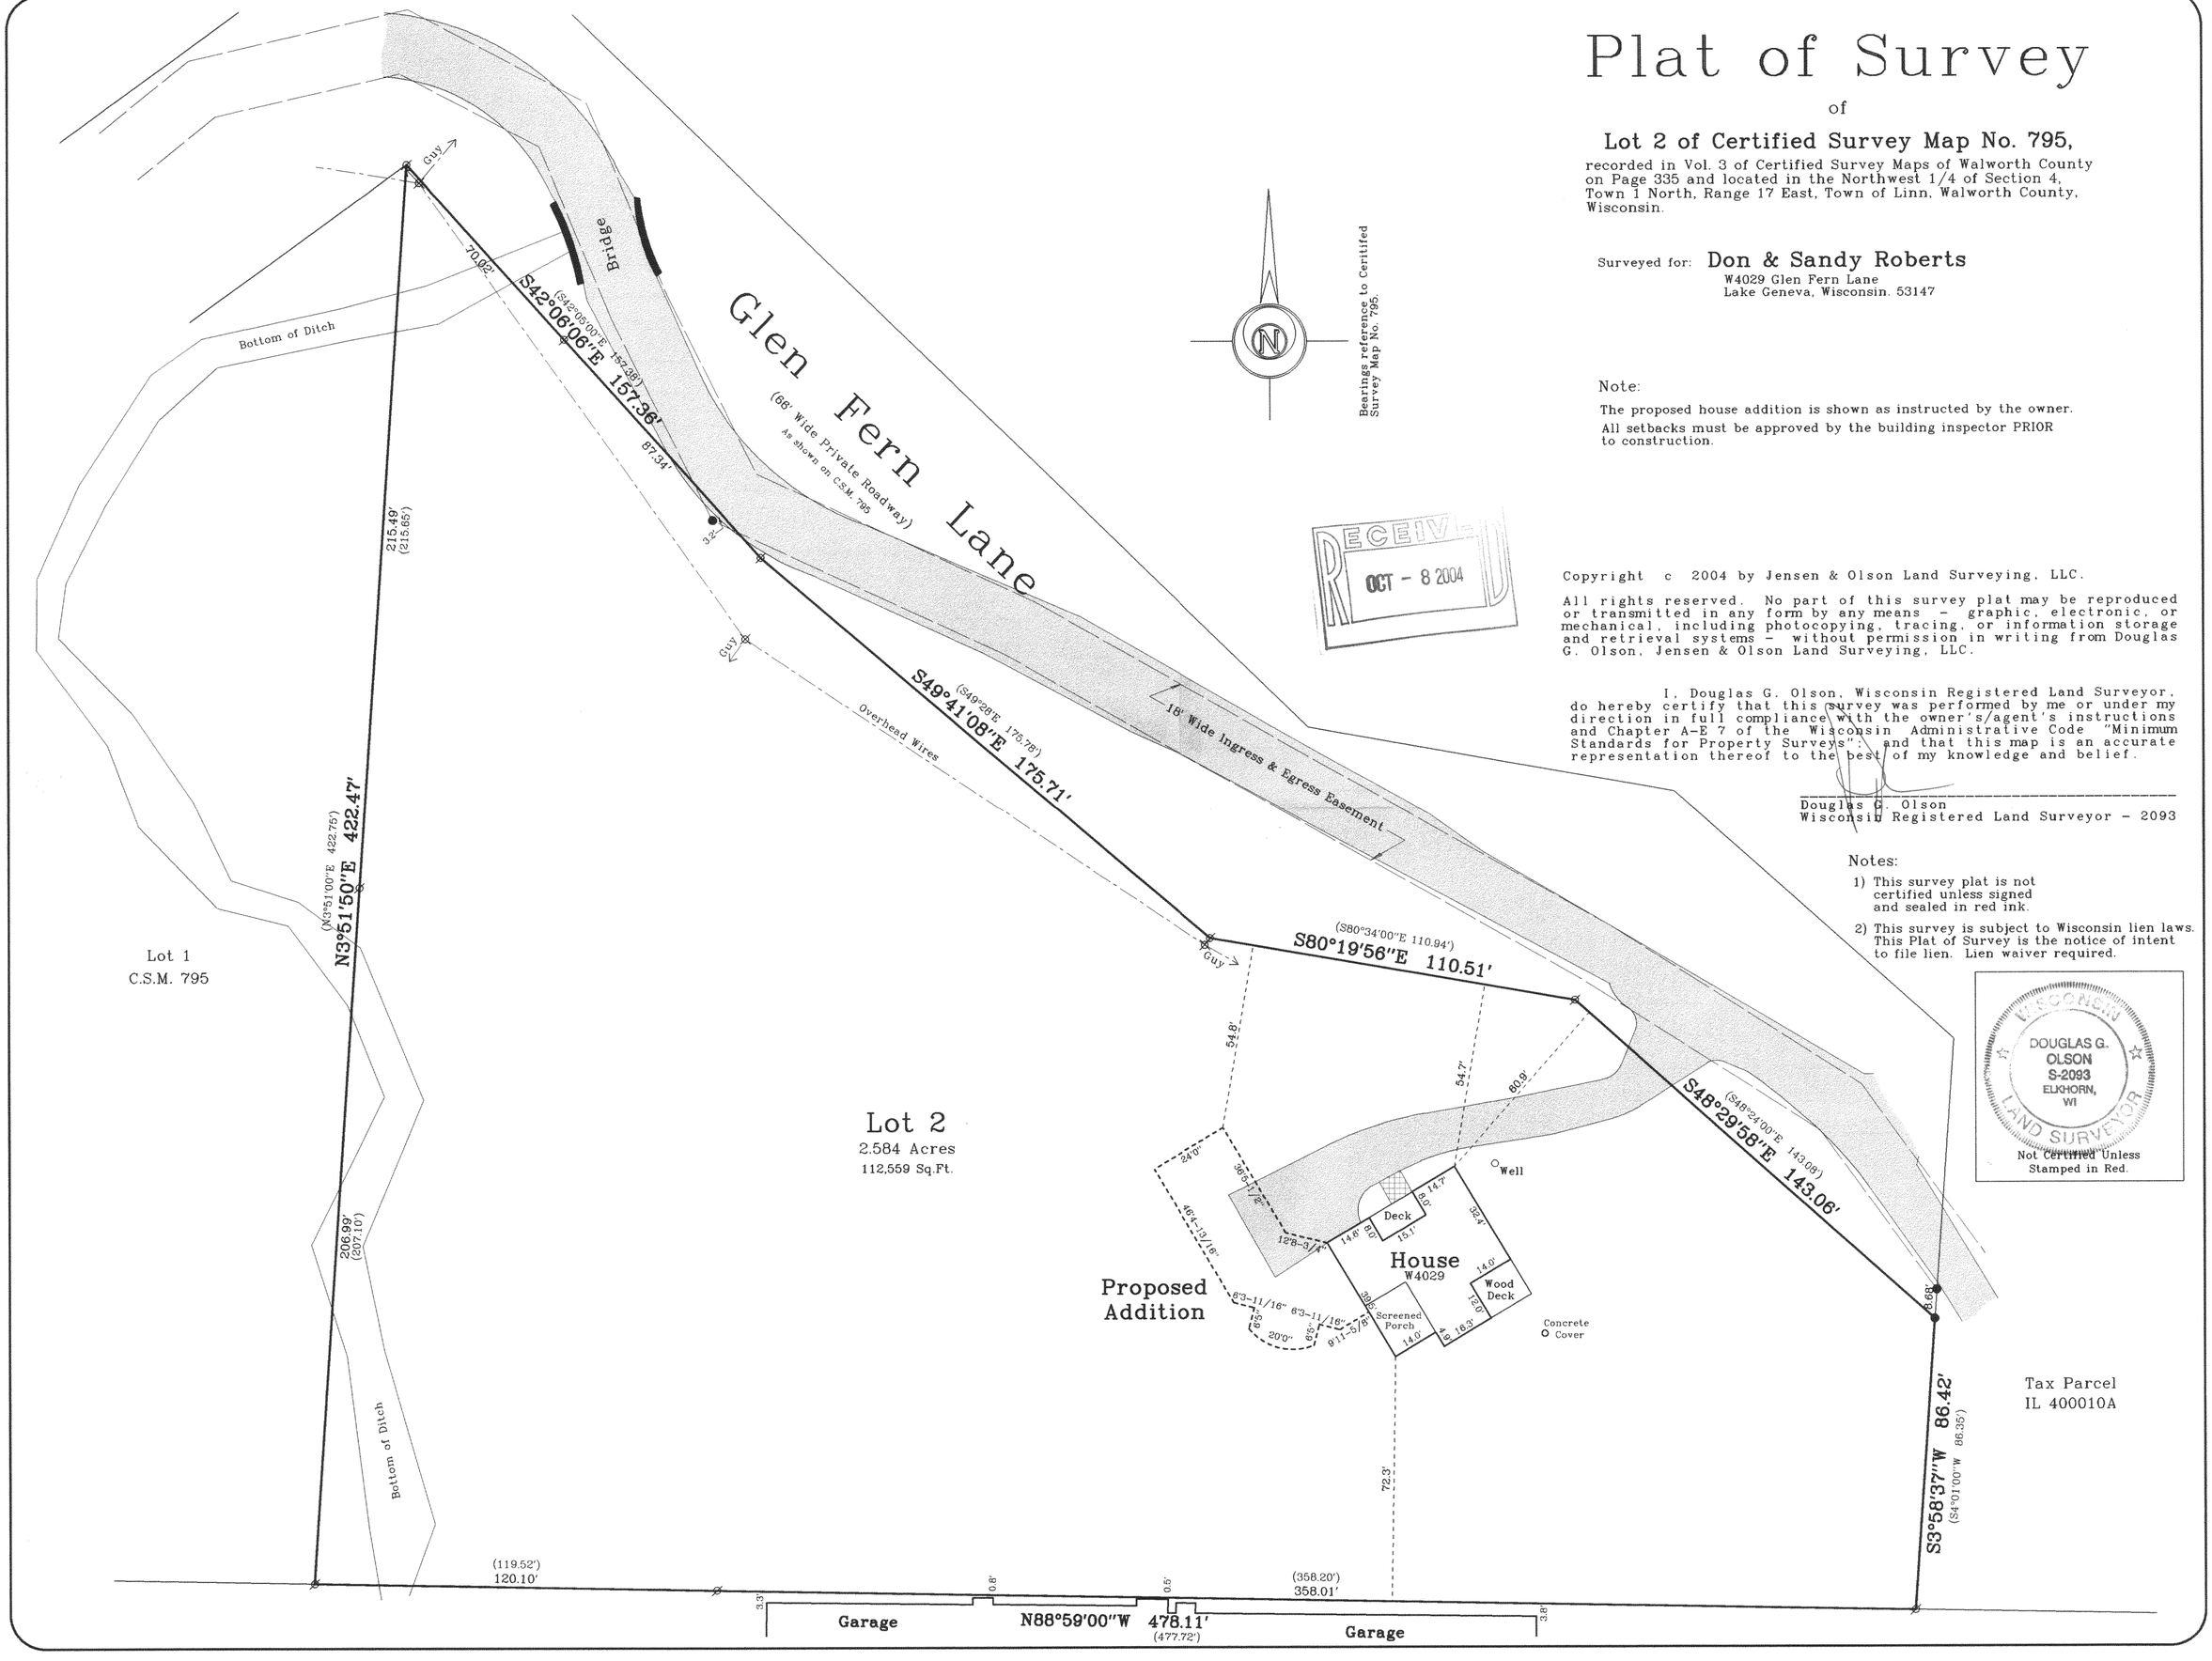

Bearings reference to Certified Survey Map No. 795.

RECEIVED
OCT - 8 2004

Copyright c 2004 by Jensen & Olson Land Surveying, LLC.

All rights reserved. No part of this survey plat may be reproduced or transmitted in any form by any means - graphic, electronic, or mechanical, including photocopying, tracing, or information storage and retrieval systems - without permission in writing from Douglas G. Olson, Jensen & Olson Land Surveying, LLC.

I, Douglas G. Olson, Wisconsin Registered Land Surveyor, do hereby certify that this survey was performed by me or under my direction in full compliance with the owner's/agent's instructions and Chapter A-E 7 of the Wisconsin Administrative Code "Minimum Standards for Property Surveys"; and that this map is an accurate representation thereof to the best of my knowledge and belief.

Douglas G. Olson
Wisconsin Registered Land Surveyor - 2093

Notes:

1) This survey plat is not certified unless signed and sealed in red ink.
2) This survey is subject to Wisconsin lien laws. This Plat of Survey is the notice of intent to file lien. Lien waiver required.

WISCONSIN
DOUGLAS G. OLSON
S-2093
ELKHORN, WI
LAND SURVEYOR
Not Certified Unless Stamped in Red.

Survey Date: August 18, 2004
Revisions:

Scale in Feet
1" = 30'
0' 15' 30' 60'

Jensen & Olson Land Surveying, LLC
45 South Wisconsin Street P.O. Box 322
Elkhorn, Wisconsin. 53121
Telephone (262) 723-3434
Facsimile (262) 723-8044

Legend
Found Iron Pipe
Found Iron Rod
() Recorded Information
Utility Pole
Asphalt Surface
Brick Surface

Sheet 1 of 1 Sheets

Job Reference Number
2004.111

2004.111

IA 795 00002

117-2476