
Plat of Survey


of

Lot 2 of Block 2 of the Plat of Zenda,

located in the Southeast 1/4 of Section 28, Town 1 North, Range 17 East, Town of Linn, Walworth County, Wisconsin.

Surveyed for: **Schiltz Law Office, S.C.**
P.O. Box 158
Lake Geneva, Wisconsin. 53147

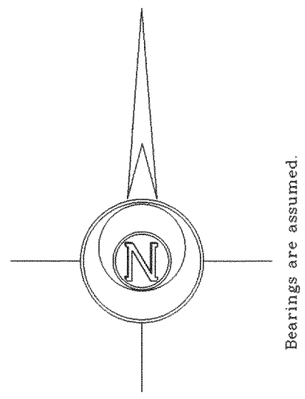

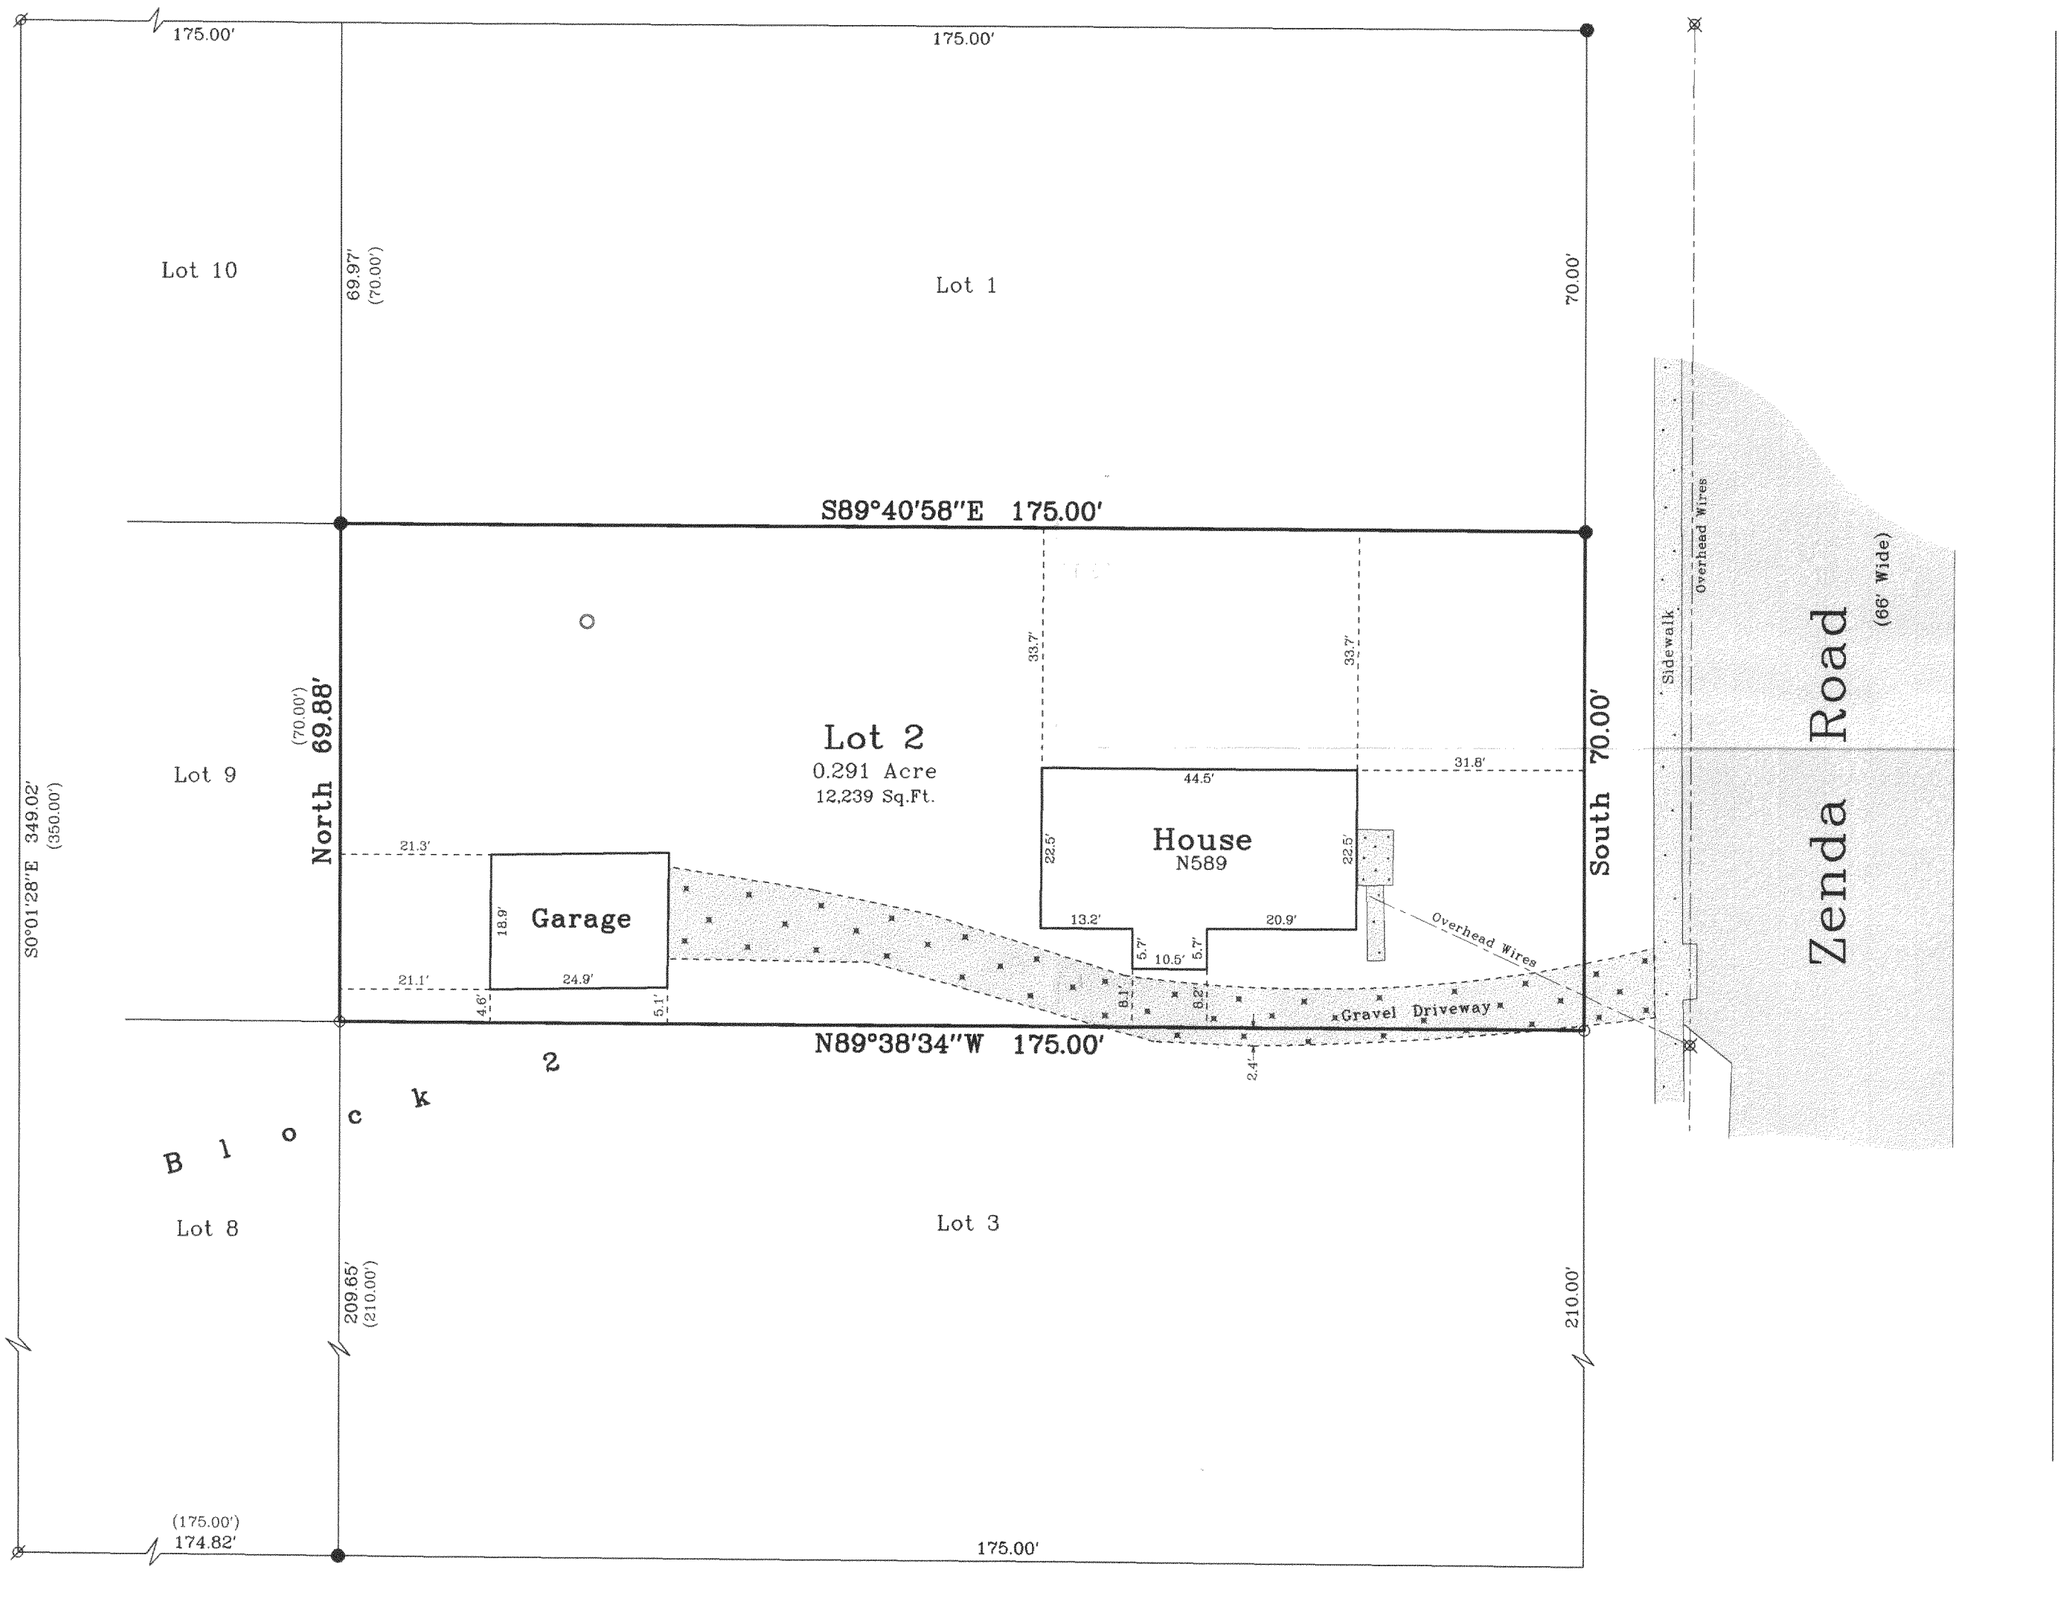

DOUGLAS G OLSON S-2093 ELKHORN, WI
LAND SURVEYOR
Not Certified Unless Stamped in Red.

Copyright c 2004 by Jensen & Olson Land Surveying, LLC.

All rights reserved. No part of this survey plat may be reproduced or transmitted in any form by any means - graphic, electronic, or mechanical, including photocopying, tracing, or information storage and retrieval systems - without permission in writing from Douglas G. Olson, Jensen & Olson Land Surveying, LLC.

RECEIVED
OCT - 8 2004

I hereby certify that I have surveyed the above described property and the map hereon is correct to the best of my professional knowledge and belief and shows the size and location of the property, its exterior boundaries, the location and dimensions of all visible structures thereon, boundary fences, apparent easements and roadways and visible encroachments, if any.

This survey is made for the exclusive use of the present owners of property, and also those who purchase, mortgage or guarantee title thereto, within one year from the date hereof.

Douglas G. Olson
Wisconsin Registered Land Surveyor - 2093

Notes: 1) This survey plat is not certified unless signed and sealed in red ink.

2) This survey is subject to Wisconsin lien laws. This Plat of Survey is the notice of intent to file lien. Lien waiver required.

IZ 00007A

2004.021

Sheet 1 of 1 Sheets

Job Reference Number
2004.021

Legend
- Ø Found Iron Pipe
- ● Found Iron Rod
- ○ Set Iron Rod, 3/4" dia.
- ( ) Recorded Information
- ⊠ Utility Pole
- ○ Concrete Cover
- Asphalt Surface
- Concrete Surface
- Gravel

Jensen & Olson Land Surveying, LLC
45 South Wisconsin Street P.O. Box 322
Elkhorn, Wisconsin. 53121
Telephone (262) 723-3434
Facsimile (262) 723-8044

Scale in Feet
1" = 20'
0' 10' 20' 40'

Survey Date: May 26, 2004.
Revisions:

117-2480