
#195-65

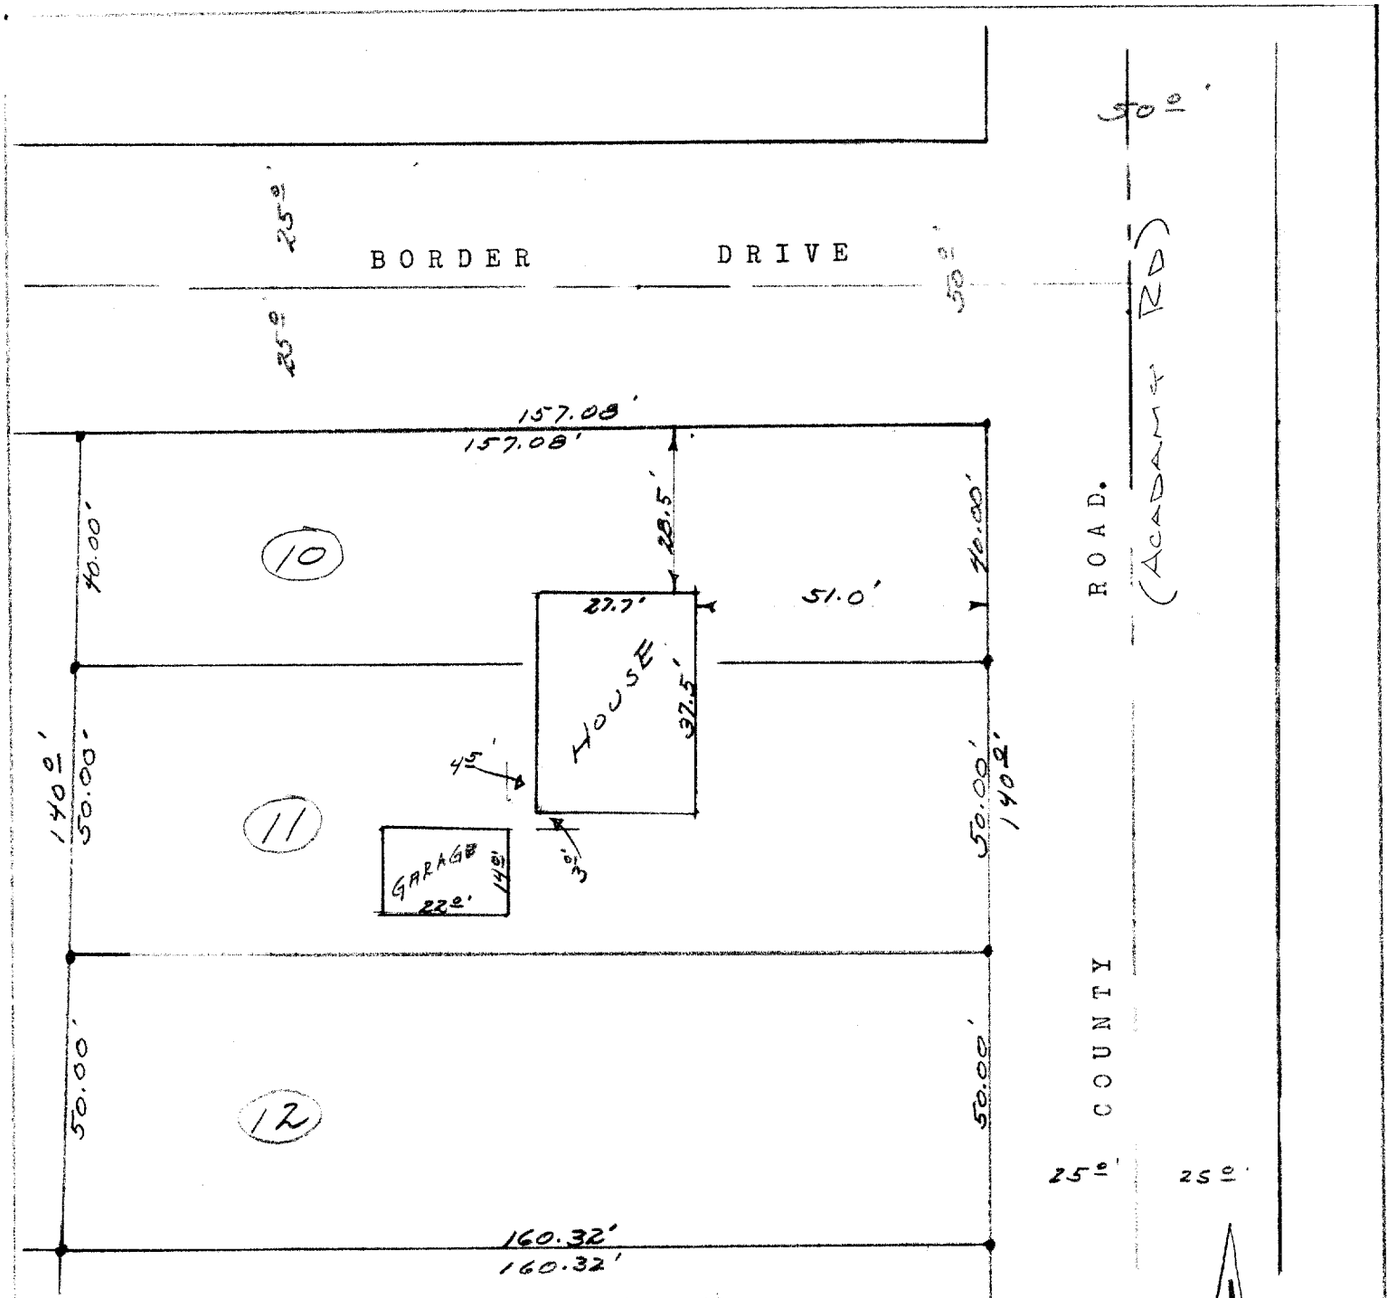

DESCRIPTION:

Lots 10, 11, and 12, Maple Hills "A" Subdivision a subdivision of a portion of Section 18, Town 1, north, Range 17 east, Walworth County, Wisconsin.

CERTIFICATE: I, James F. Biagi, Surveyor, do hereby certify that I have on this the 27th day of July 1965, surveyed the above described property.

James F. Biagi
Elkhorn, Wisconsin.

Dated: July 28th 1965.

JAMES F. BIAGI MILWAUKEE, WIS. REGISTERED LAND SURVEYOR

NORTH

● Iron Stake

IMH-280

117-24B