
ABELL
SURVEYING & MAPPING

1140 SEQUOIA STREET · DELAVAN, WISCONSIN 53115
262-728-6737

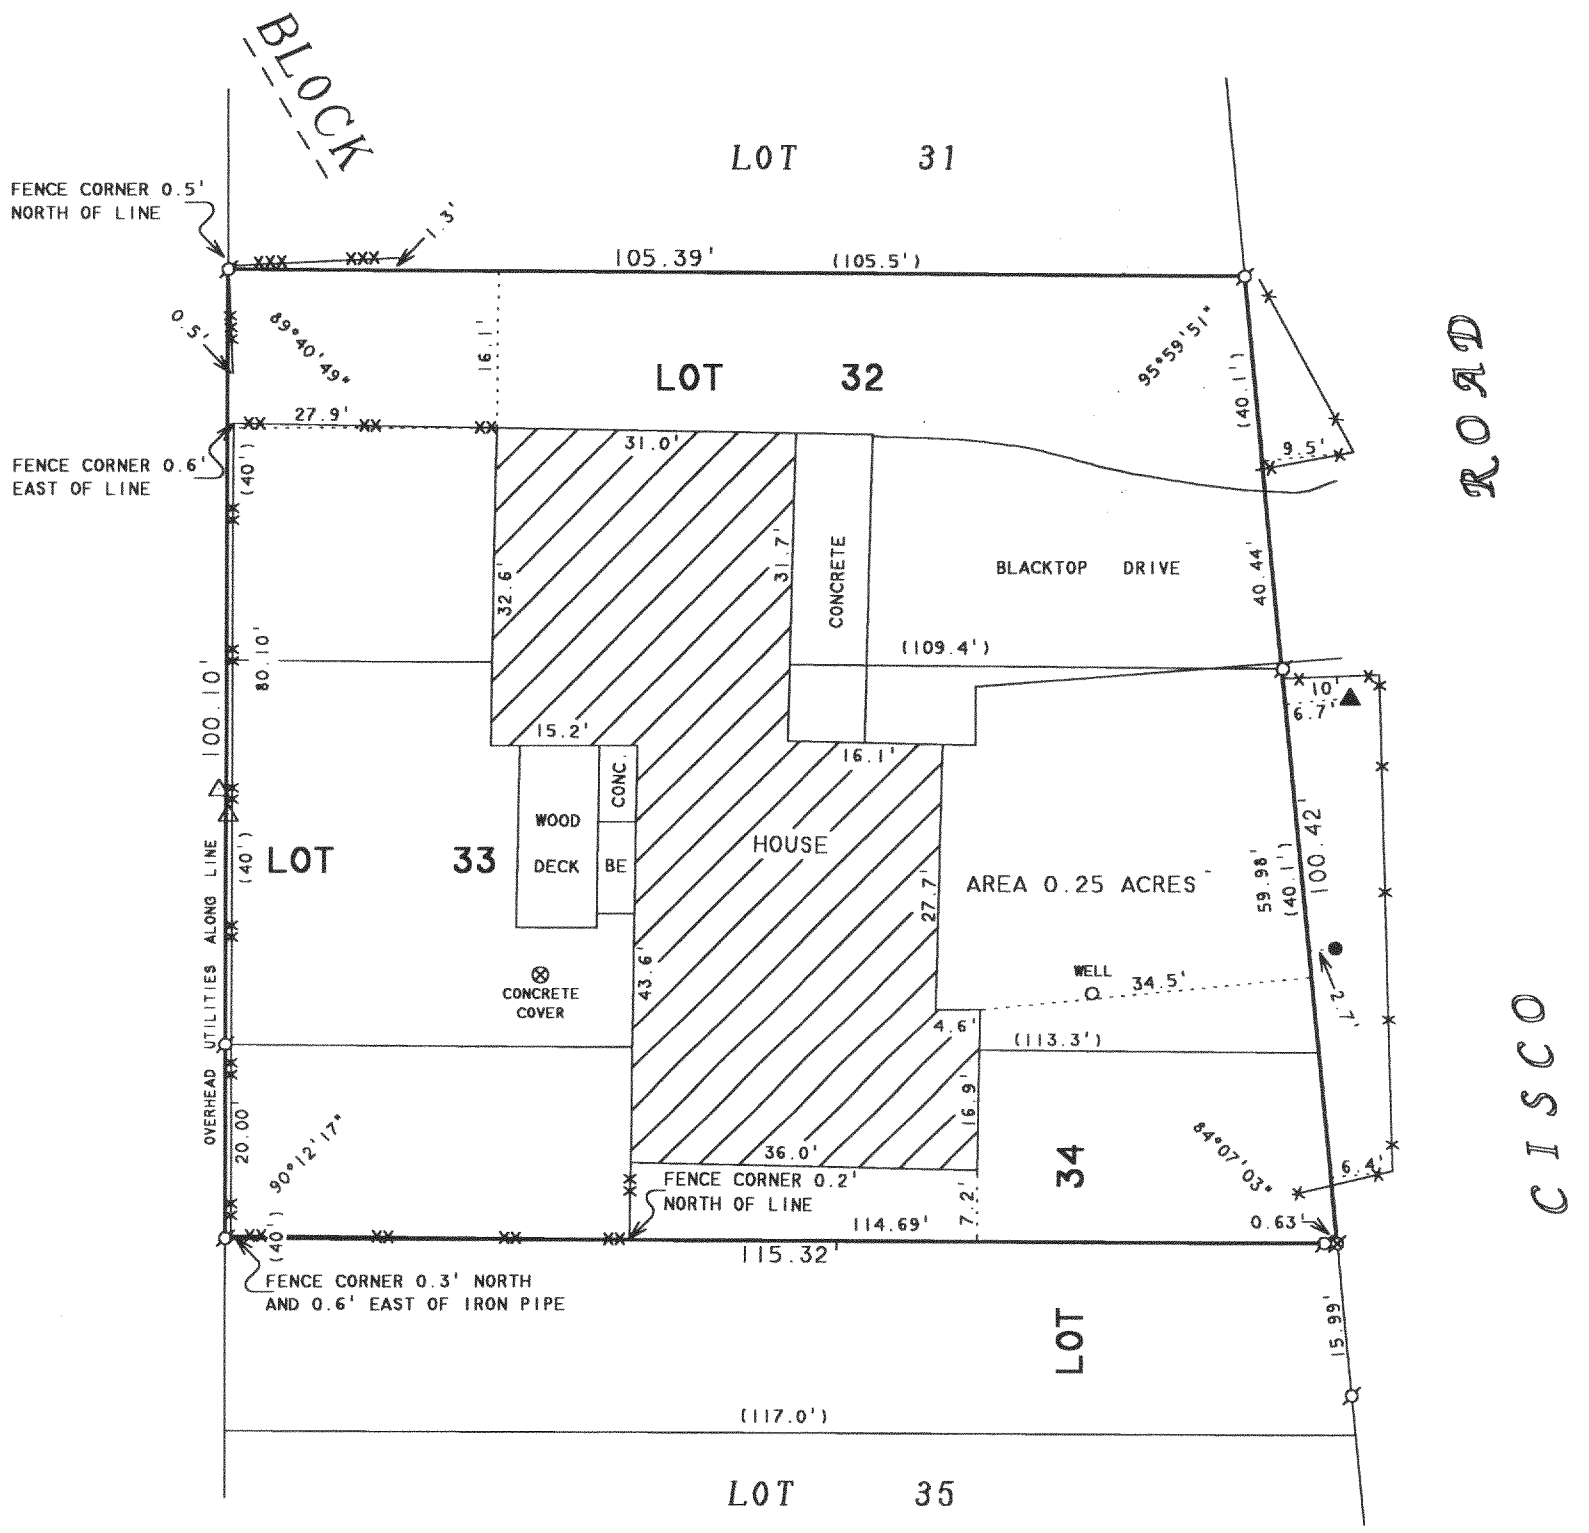

PLAT OF SURVEY OF

LOTS 32, 33 AND THE NORTH 20 FEET OF LOT 34, BLOCK "J", OF CISCO BEACH, LOCATED IN T1N, R17E, WALWORTH COUNTY, WISCONSIN.

N

SCALE 1"=20'

LEGEND

- ∅ -IRON PIPE FOUND
- ⊘ -RAILROAD SPIKE FOUND
- ▲ -YARD LIGHT
- ● -WATER VALVE
- XX——XX -CHAINLINK FENCE
- X——X -WOOD RAIL FENCE
- XXX——XXX -WOOD/WIRE FENCE
- △ -UTILITY POLE
- BE -BASEMENT ENTRY
- ( )-RECORDED AS

ORDERED BY: SHOREWEST REALTORS
830 E. GENEVA STREET
DELAVAN, WI 53115

RECEIVED
AUG 26 2005

I HEREBY CERTIFY THAT I HAVE SURVEYED THE ABOVE DESCRIBED PROPERTY AND THAT THE ABOVE MAP IS A TRUE REPRESENTATION THEREOF AND SHOWS THE SIZE AND LOCATION OF THE PROPERTY, ITS EXTERIOR BOUNDARIES, THE LOCATION OF ALL VISIBLE STRUCTURES AND DIMENSIONS OF ALL PRINCIPAL BUILDINGS THEREON, BOUNDARY FENCES, APPARENT EASEMENTS, ROADWAYS AND VISIBLE ENCROACHMENTS, IF ANY, TO THE BEST OF MY KNOWLEDGE AND BELIEF.

THIS SURVEY IS MADE FOR THE USE OF THE PRESENT OWNERS OF THE PROPERTY, AND ALSO THOSE WHO PURCHASE, MORTGAGE, OR GUARANTEE THE TITLE THERETO WITHIN ONE (1) YEAR FROM DATE HEREON.

David F. Abell

DAVID F. ABELL
WISCONSIN REGISTERED LAND SURVEYOR, S-1596

August 1, 2005

DATE JOB NUMBER - 05093

NOTE: THIS IS NOT A CERTIFIED COPY UNLESS SEALED.

ICI 00239

117-2599