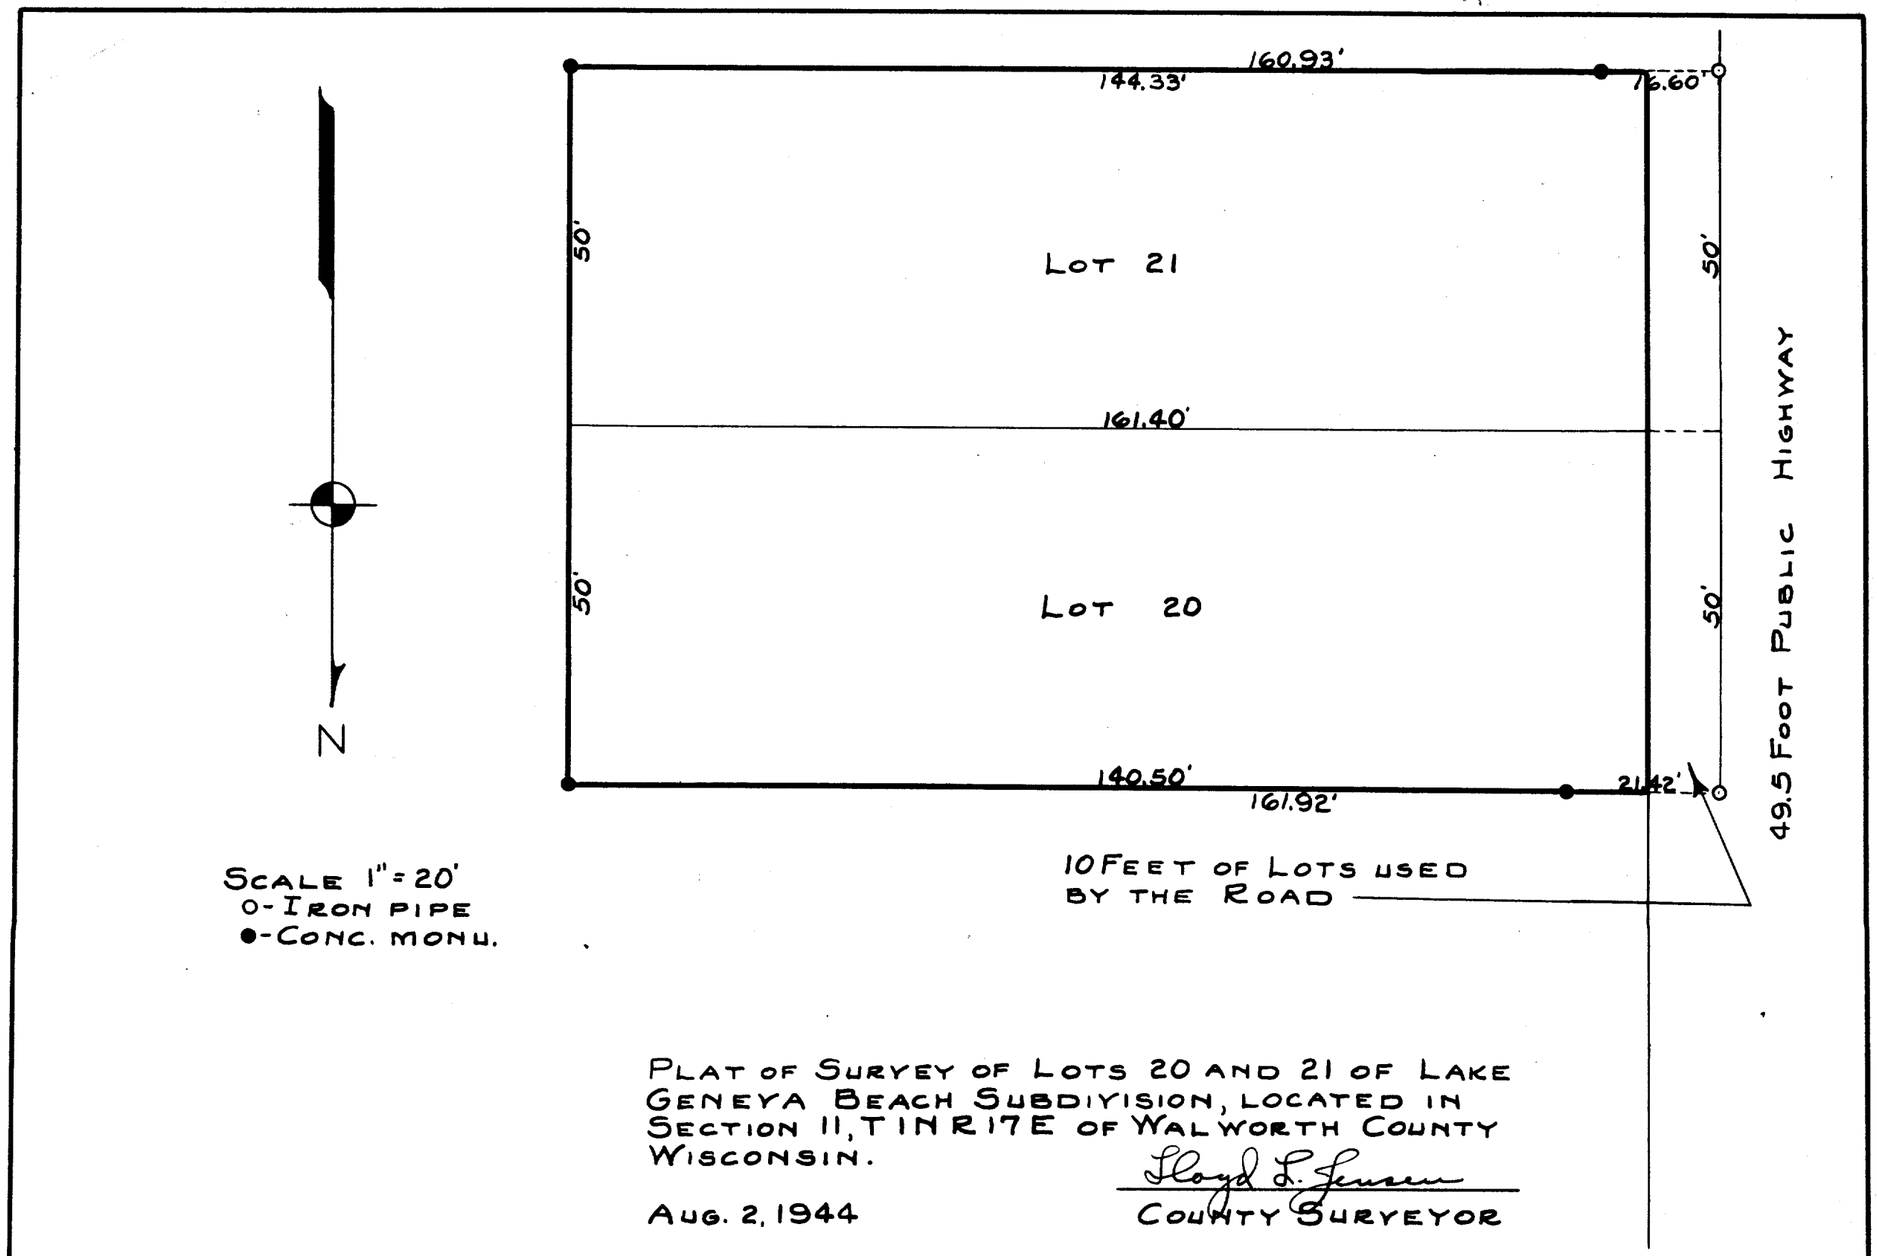


SCALE 1" = 20'
O-IRON PIPE
●-CONC. MONU.

10 FEET OF LOTS USED BY THE ROAD

PLAT OF SURVEY OF LOTS 20 AND 21 OF LAKE GENEVA BEACH SUBDIVISION, LOCATED IN SECTION 11, T1N R17E OF WALWORTH COUNTY WISCONSIN.

AUG. 2, 1944

Lloyd L. Jensen
COUNTY SURVEYOR

LGB-15,16