
Plat of Survey

of

Lot 1 of Certified Survey Map No. 493,

recorded in Vol. 2 of Certified Survey Maps of Walworth County on Page 319 and located in the Northeast 1/4 of Section 11, Town 1 North, Range 17 East, Town of Linn, Walworth County, Wisconsin.

Surveyed for: **Robert Cooney**
W2990 County Road BB
Lake Geneva, Wisconsin. 53147

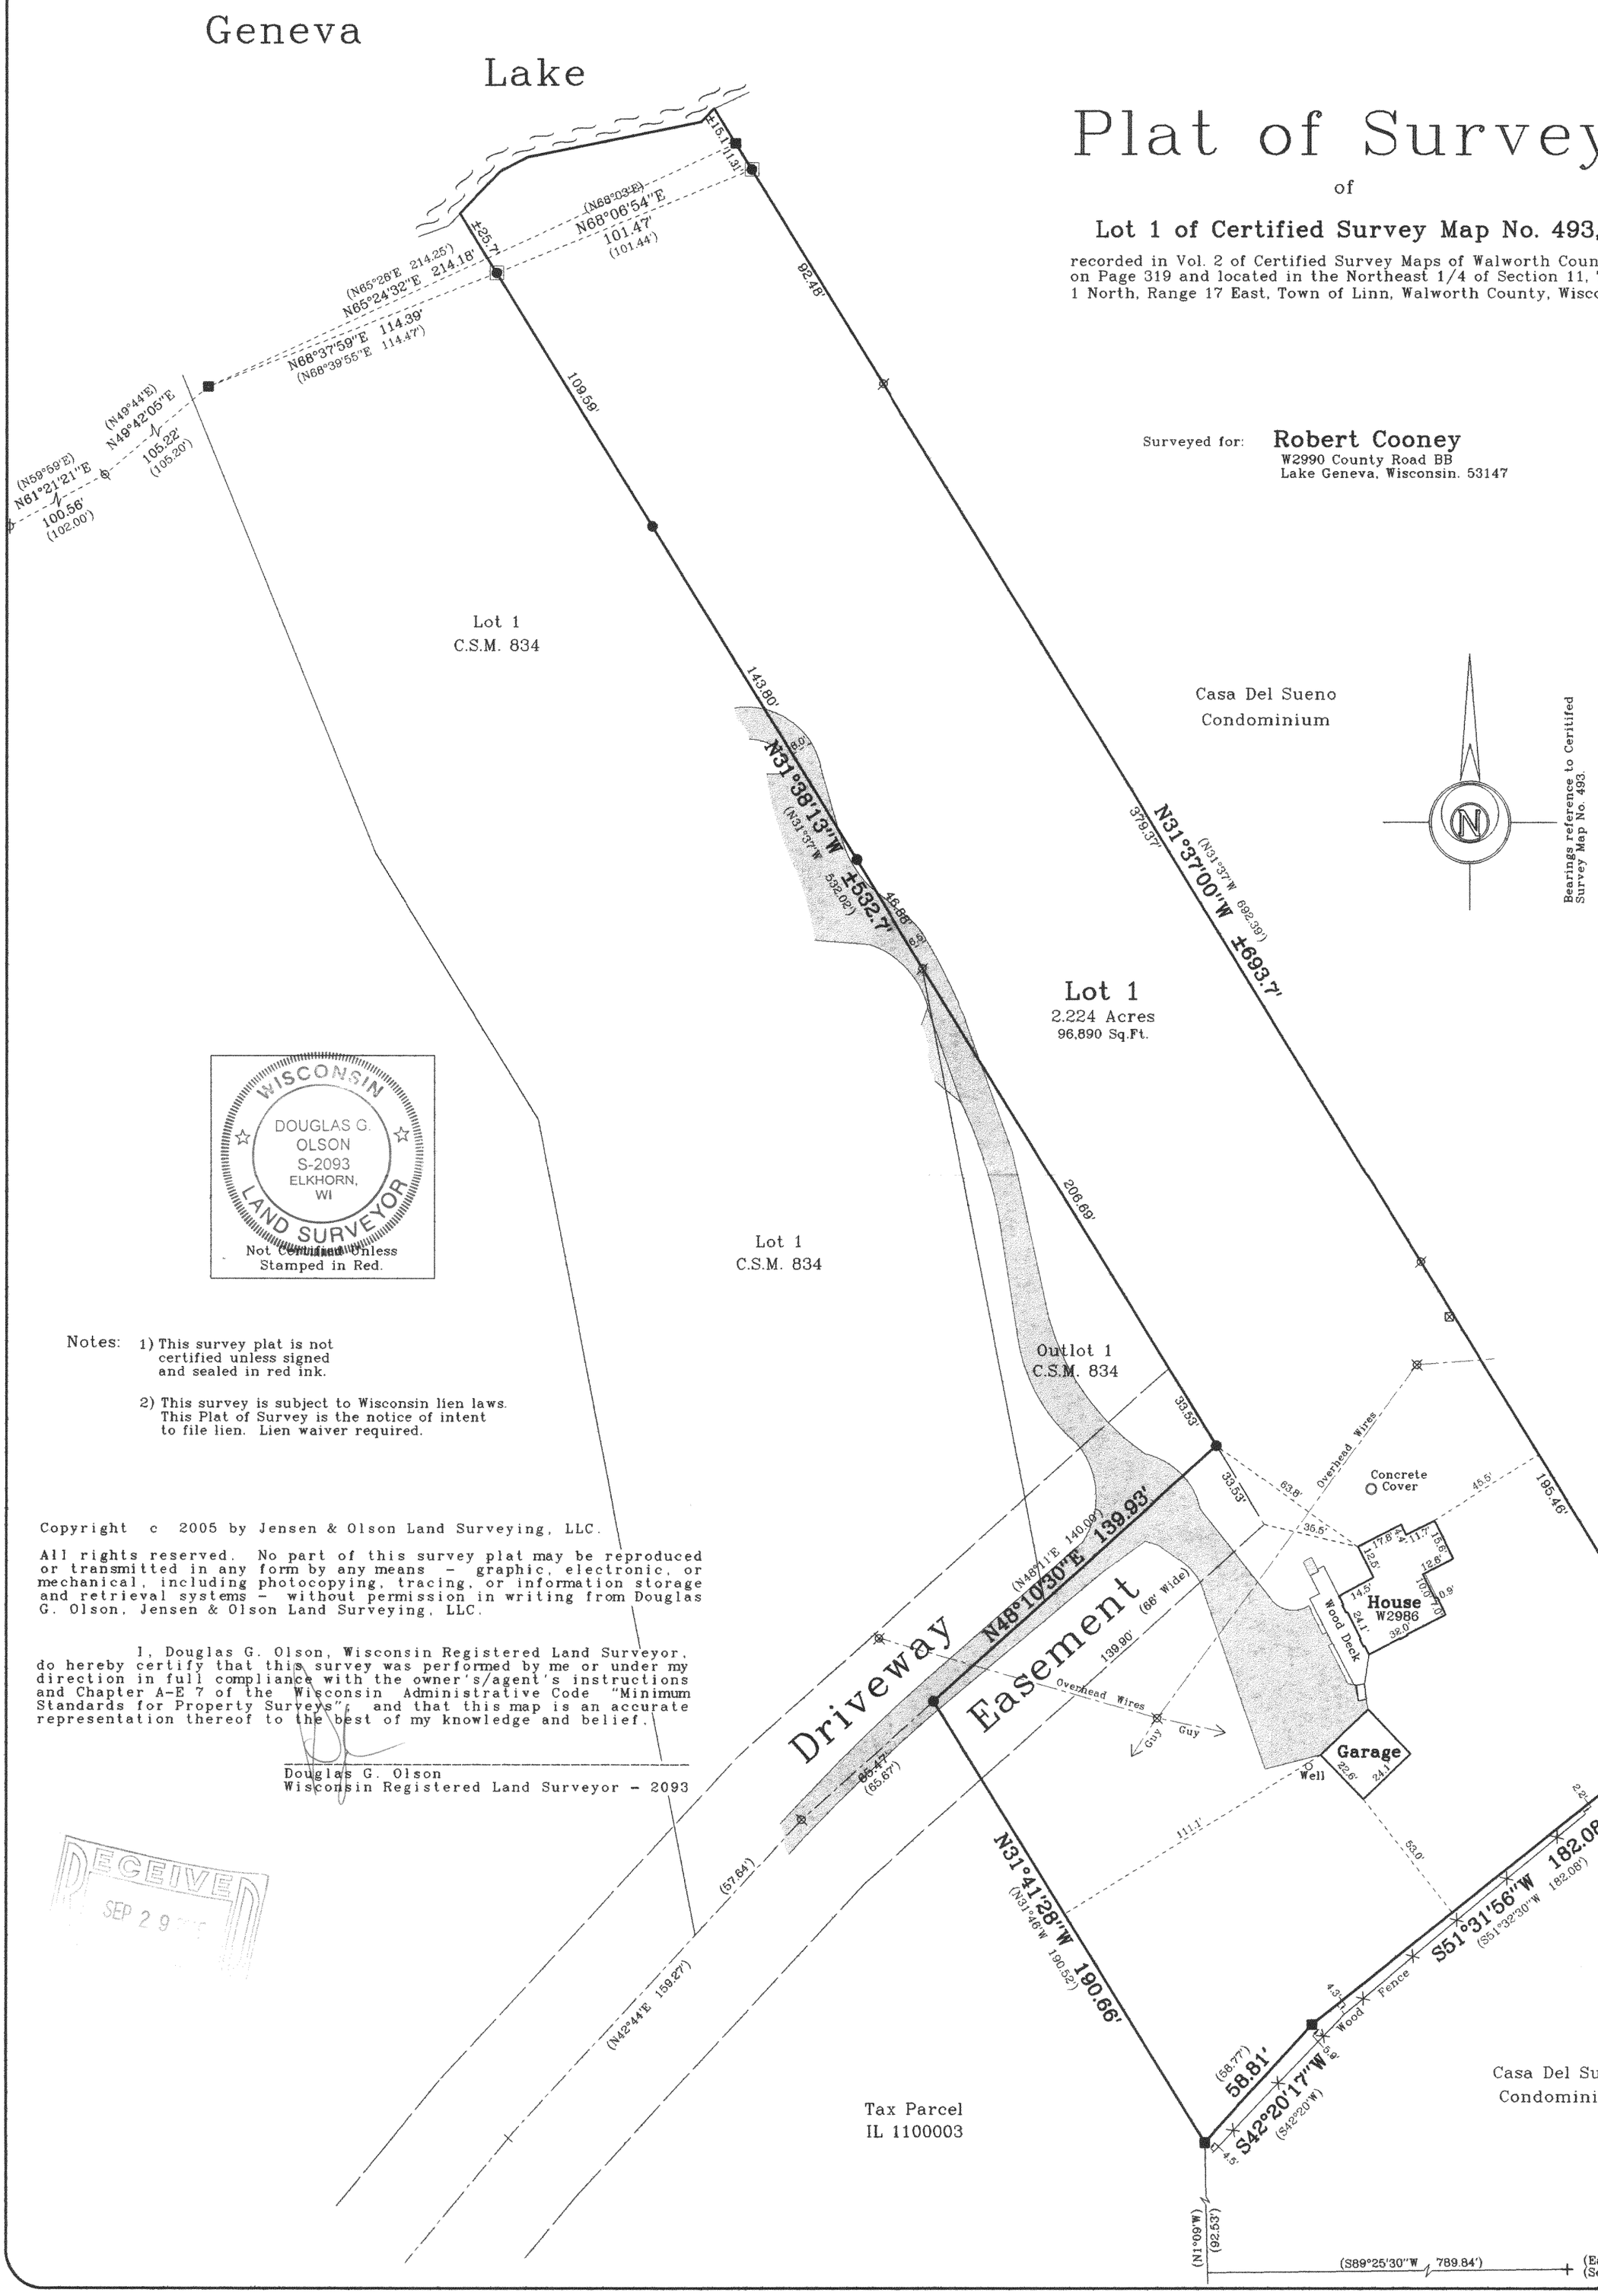

WISCONSIN
DOUGLAS G. OLSON
S-2093
ELKHORN, WI
LAND SURVEYOR
Not Certified Unless Stamped in Red.

Notes:
1) This survey plat is not certified unless signed and sealed in red ink.
2) This survey is subject to Wisconsin lien laws. This Plat of Survey is the notice of intent to file lien. Lien waiver required.

Copyright c 2005 by Jensen & Olson Land Surveying, LLC.

All rights reserved. No part of this survey plat may be reproduced or transmitted in any form by any means - graphic, electronic, or mechanical, including photocopying, tracing, or information storage and retrieval systems - without permission in writing from Douglas G. Olson, Jensen & Olson Land Surveying, LLC.

I, Douglas G. Olson, Wisconsin Registered Land Surveyor, do hereby certify that this survey was performed by me or under my direction in full compliance with the owner's/agent's instructions and Chapter A-E 7 of the Wisconsin Administrative Code "Minimum Standards for Property Surveys"; and that this map is an accurate representation thereof to the best of my knowledge and belief.

Douglas G. Olson
Wisconsin Registered Land Surveyor - 2093

RECEIVED SEP 29 [illegible]

2005.042

Sheet 1 of 1 Sheets

Job Reference Number
2005.042

Legend
- Found Concrete Monument
- Found Iron Pipe
- Found Iron Rod, 1-3/16" dia.
- Found Iron Rod, 3/4" dia.
- Set P.K. Nail
- ( ) Recorded Information
- Utility Pole ⊠ Utility Pedestal
- Asphalt Surface ═══ Concrete

Jensen & Olson Land Surveying, LLC
45 South Wisconsin Street P.O. Box 322
Elkhorn, Wisconsin. 53121
Telephone (262) 723-3434
Facsimile (262) 723-8044

Scale in Feet
1" = 40'
0' 20' 40' 80'

Survey Date: April 18, 2005.
Revisions:

IA 4930001

17-2607