
PREPARED FOR:
JOHN LAW
RE/MAX GENEVA REALTY , LTD.
101 BROAD STREET , SUITE 102
LAKE GENEVA , WISCONSIN 53147

PLAT OF SURVEY

- OF -

LOT 1 CERTIFIED SURVEY MAP NO. 739 LOCATED IN SECTION 17 , TOWN 1 NORTH , RANGE 17 EAST , WALWORTH COUNTY , WISCONSIN.

PATHFINDER SURVEYING INC.
N3705 WILLOWBEND LANE
LAKE GENEVA, WI, 53147
262-248-3697

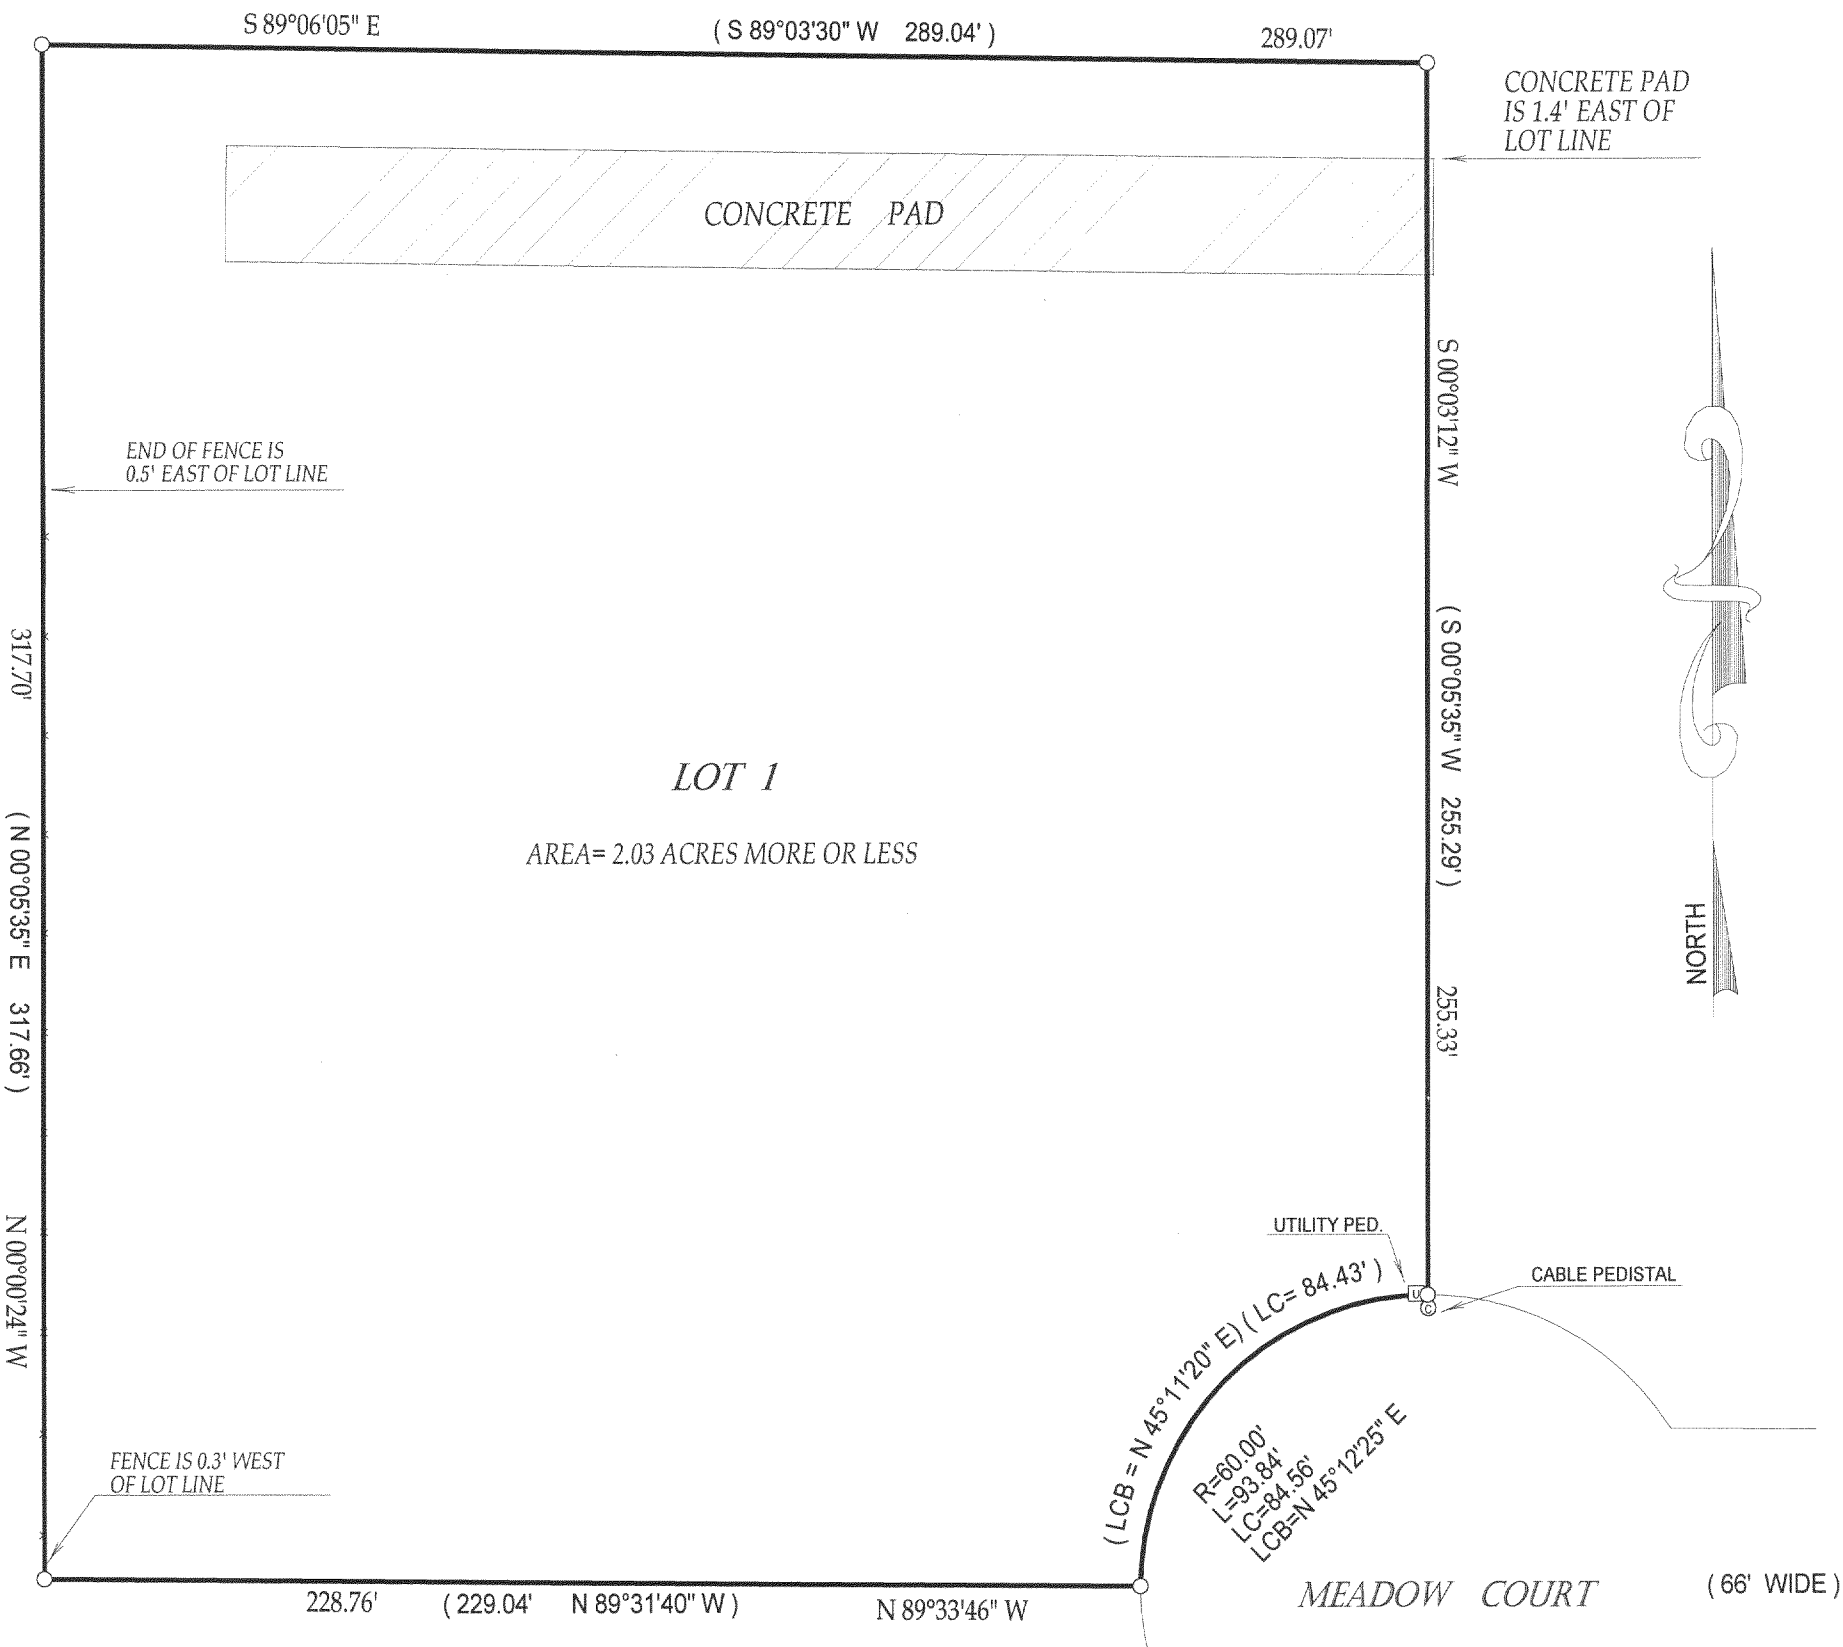

RECEIVED
DEC 14 2005
SMF

( )= recorded as
□ = found iron bar
○ = found iron pipe
● = set iron pipe
■ = set iron bar

SCALE 1" = 40'

JOB # 05-516

TAX ID # IA73900001

COMPARE LEGAL DESCRIPTION ABOVE AND DRAWING WITH DEED. FOR BUILDING RESTRICTIONS AND EASEMENTS NOT SHOWN,REFER TO DEED, ABSTRACT SOURCES AND LOCAL MUNICIPAL CODES. NOTIFY THE SURVEYOR IMMEDIATELY OF ANY DISCREPANCY.

"I hereby certify that I have surveyed the above described property and that the above map is a true representation thereof and shows the size and location of all visible structures, apparent easements and encroachments if any."
This survey is made for the present owners of the property, and those who purchase, mortgage, or guarantee the title thereto, within one year from the date hereof.

DATED THIS 29th, DAY OF SEPTEMBER , 2005

WISCONSIN
JOHN P. KROTT
S-2258
LAKE GENEVA WIS.
LAND SURVEYOR

JOHN KROTT S - 2258
Wisconsin Registered Land Surveyor
(original if signed in red)

IA739-1

117-2630