


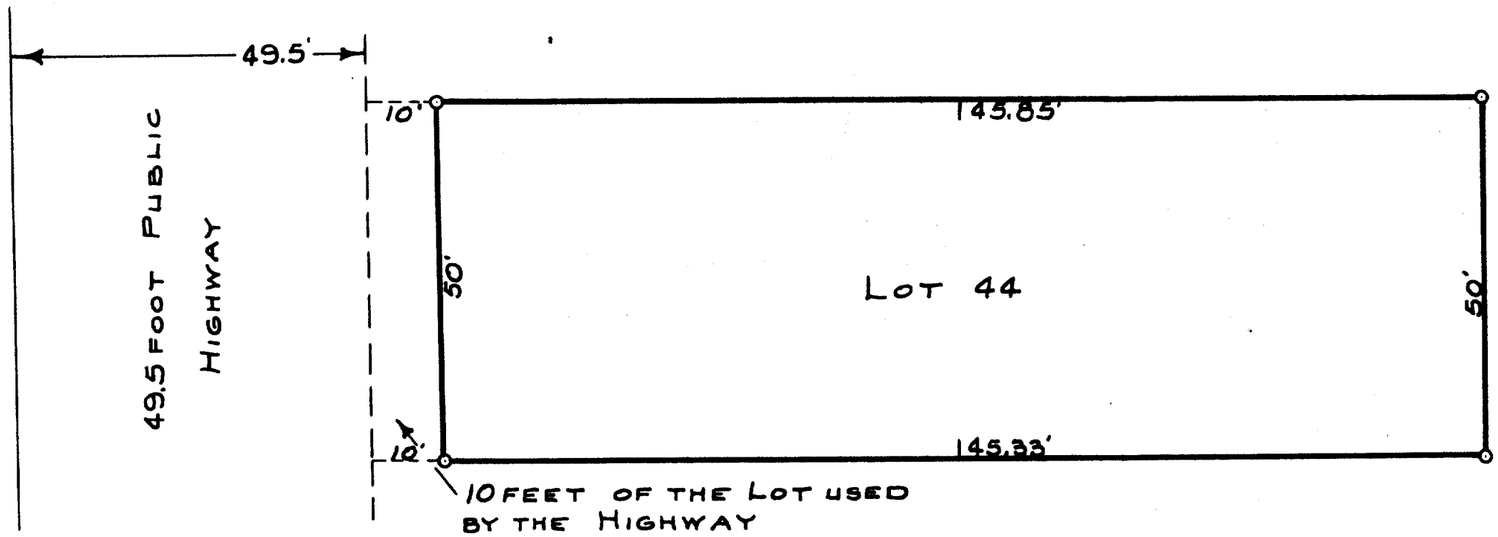

PLAT OF SURVEY OF LOT 44 OF LAKE GENEVA BEACH SUBDIVISION, LOCATED IN SECTION 11, T1N R17E OF WALWORTH COUNTY WISCONSIN.

AUG. 1944

Floyd L. Jensen
COUNTY SURVEYOR

SCALE 1" = 20'
O-IRON PIPE

1L6B-39