
HAROLD H. KOLB

REGISTERED PROFESSIONAL LAND SURVEYOR
LAKE GENEVA, WISCONSIN

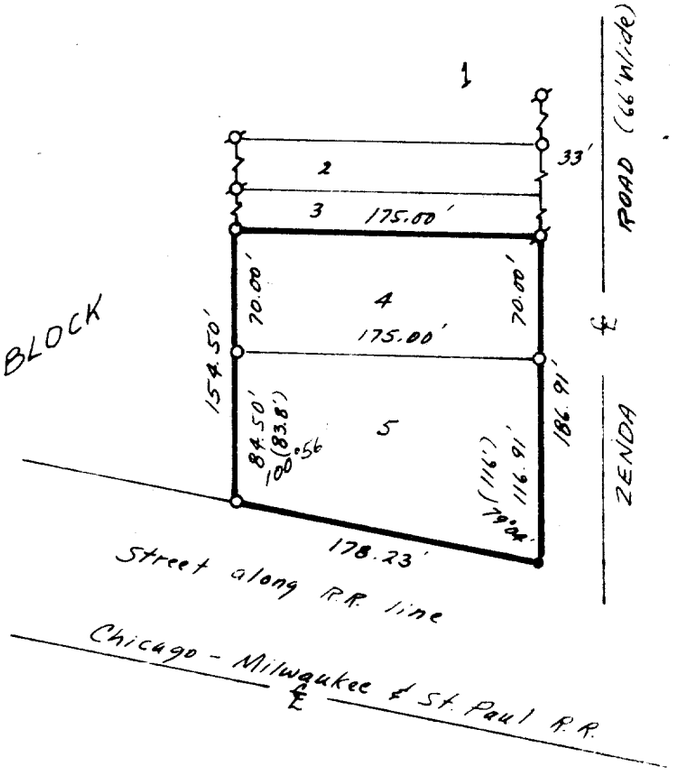

PLAT OF SURVEY OF
Lots 4 and 5, Block 4, Village of Zenda subdivision, located in the Southeast ¼ of Section 2, T 1 N, R 17 E, Walworth County, Wisconsin.

N

SCALE: 1" = 100'

LEGEND

- ⌀ — IRON PIPE FOUND
- o — IRON PIPE PLACED
- ● — CONCRETE MONUMENT
- x — SPIKE
- ● — 3/4 inch iron bar
- ( )- As platted

WISCONSIN
HAROLD H. KOLB
S 187
LAKE GENEVA, WIS.
LAND SURVEYOR

I, HAROLD H. KOLB, DO HEREBY CERTIFY THAT I HAVE SURVEYED THE PROPERTY HEREON DESCRIBED ACCORDING TO THE OFFICIAL RECORDS, AND THAT THE PLAT HEREON IS A CORRECT REPRESENTATION OF THE LOT LINES.

Harold H. Kolb
HAROLD H. KOLB
WISCONSIN REGISTERED LAND SURVEYOR, S—187
DATE April 28, 1971

IZ-3,3A,2A

117-271