PREPARED FOR
RASMUSSEN LAW OFFICES
113 KENOSH ST.
WALWORTH WI. 53184


PATHFINDER SURVEYING INC.
W2888 KRUEGER RD. UNIT "D"
LAKE GENEVA WI. 53147
(262) 248-3697


PLAT OF SURVEY


-OF-

LOT 2 OF CERTIFIED SURVEY MAP NO. 223 LOCATED IN THE SOUTHEAST 1/4 OF SECTION 11, TOWN 1 NORTH , RANGE 17 EAST , WALWORTH COUNTY , WISCONSIN.

RECEIVED
NOV - 7 2006
SMF

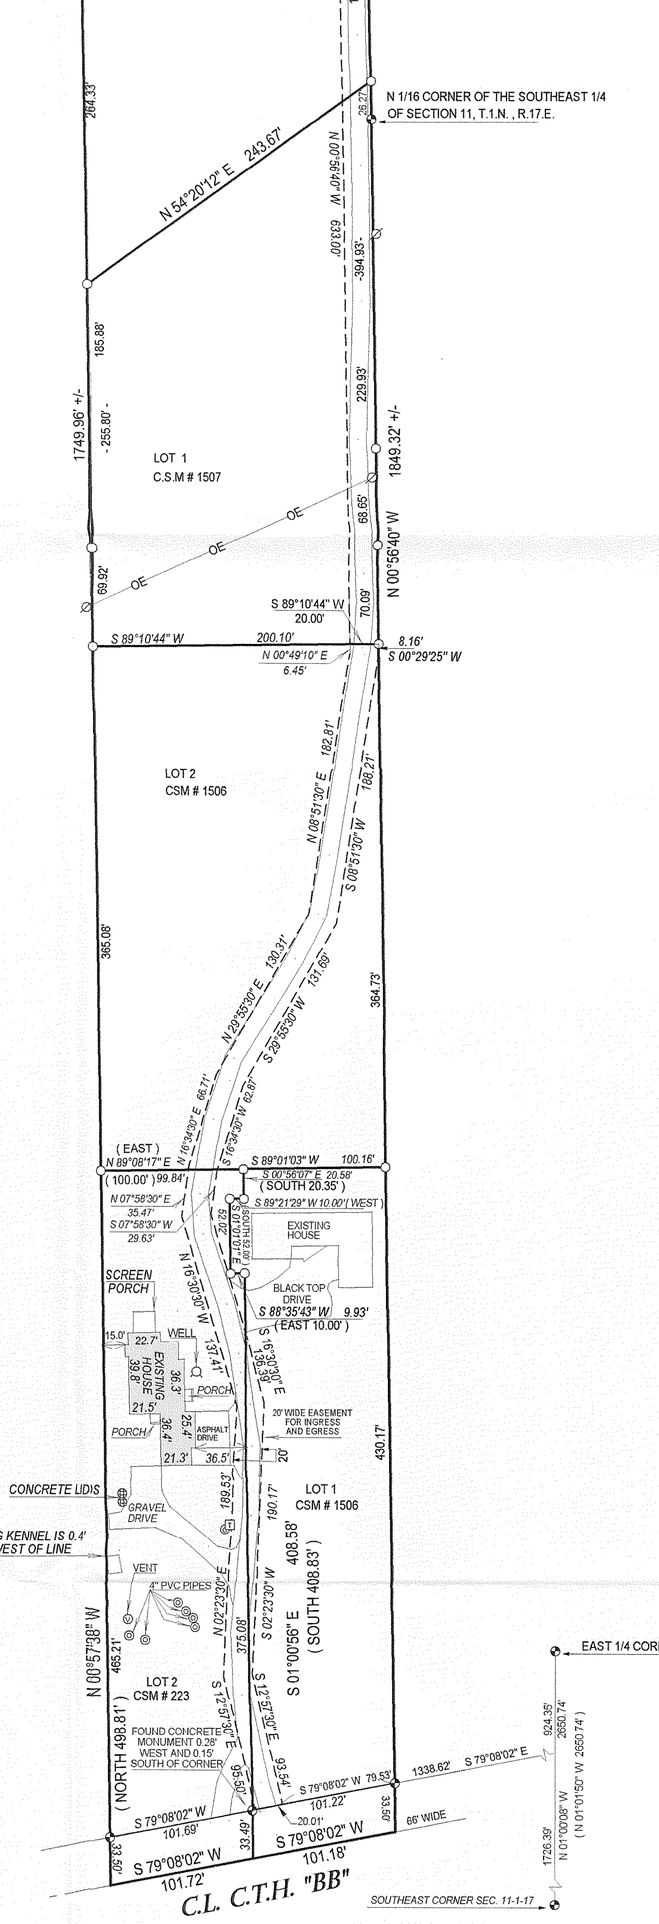

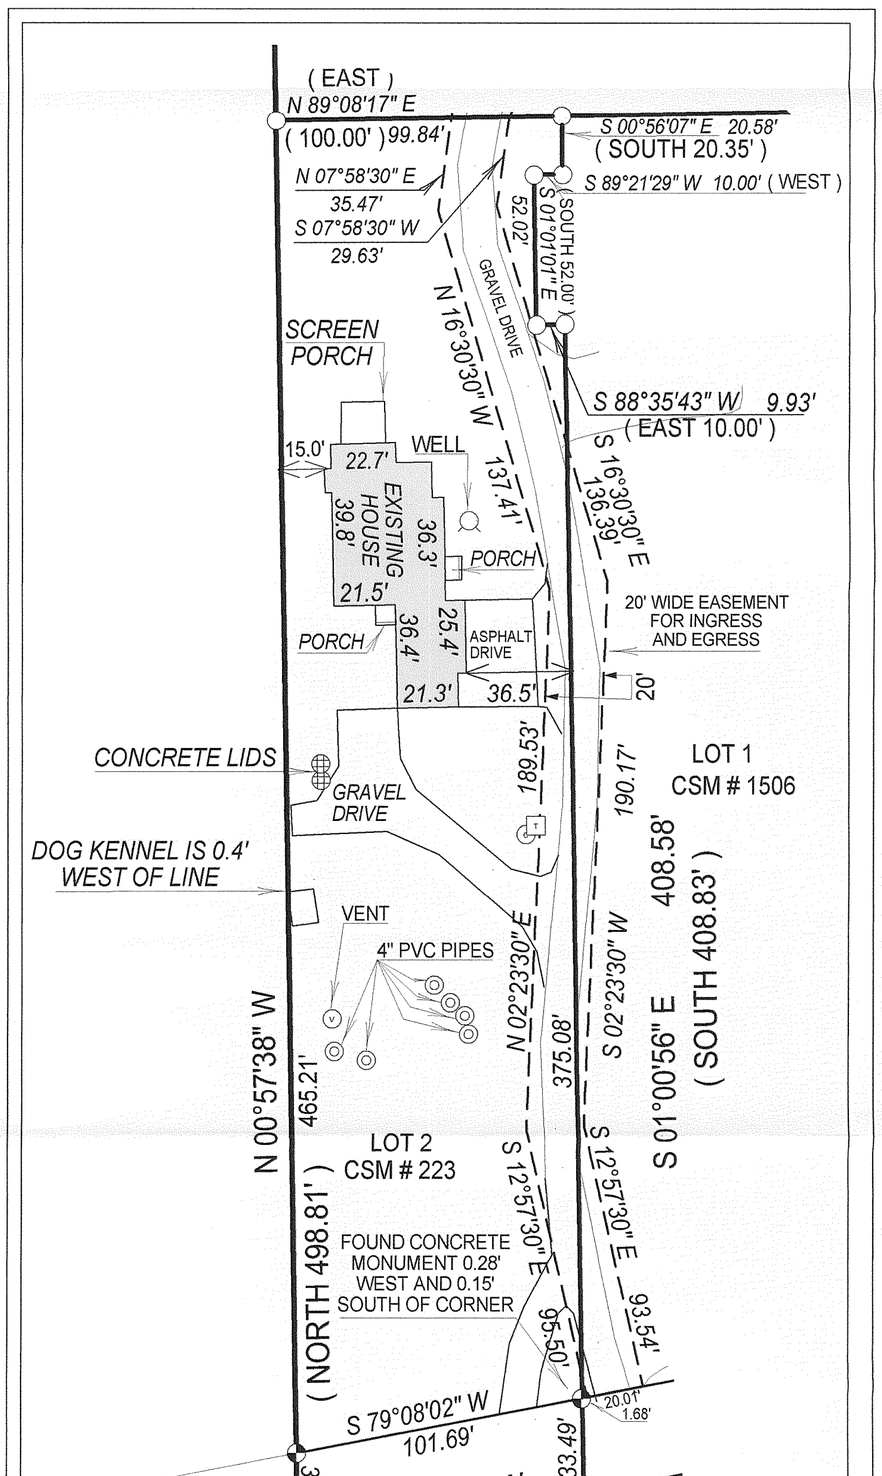

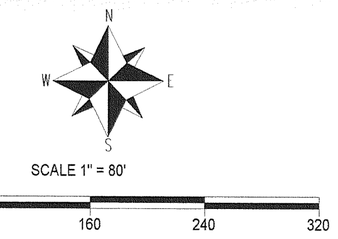

SCALE 1" = 80'

0 80 160 240 320

BEARINGS REFERENCED TO CERTIFIED SURVEY MAP NO. 1506

- = 5" concrete monument w / iron pin
- ( ) = recorded as
- □ = found iron bar
- ○ = found iron pipe
- ● = set iron pipe
- ■ = set iron bar
- ∅ = power pole
- T = TRANSFORMER
- Ⓒ = CABLE PEDISTAL

0 40 80 120 160 200

SCALE 1" = 40'

WISCONSIN
JOHN P.
KROTT
S-2258
LAKE GENEVA
WIS.
LAND SURVEYOR

COMPARE LEGAL DESCRIPTION ABOVE AND DRAWING WITH DEED. FOR BUILDING RESTRICTIONS AND EASEMENTS NOT SHOWN,REFER TO DEED, ABSTRACT SOURCES AND LOCAL MUNICIPAL CODES. NOTIFY THE SURVEYOR IMMEDIATELY OF ANY DISCREPANCY.

"I hereby certify that I have surveyed the above described property and that the above map, to the best of my knowledge and belief, is a true representation thereof and shows the size and location of all visible structures, apparent easements and encroachmentsif any."
This survey is made for the present owners of the property, and those who purchase, mortgage, or guarentee the title thereto, within one year from the date hereof.

JOHN KROTT S - 2258
Wisconsin Registered Land Surveyor
(original if signed in red)

DATE OF LAST REVISION 8-29-06

DATE: 6-29-1998

JOB NUMBER: 98099 1-17-IA22300002

IA 223-2

117-2730