
PREPARED FOR
JOHN LAW
RE/MAX GENEVA REALTY, LTD
101 BROAD ST. SUITE 102
LAKE GENEVA WI. 53147

PLAT OF SURVEY


- OF -

LOT 58 OF LAKE GENEVA HIGHLANDS, A SUBDIVISION LOCATED IN
TOWN 1 NORTH, RANGE 17 EAST, WALWORTH COUNTY, WISCONSIN

PATHFINDER SURVEYING INC.
W2888 KRUEGER ROAD, UNIT "D"
LAKE GENEVA, WI, 53147
262-248-3697

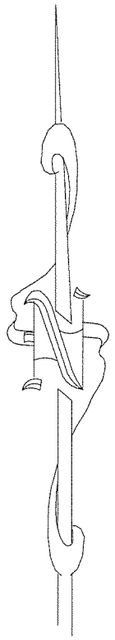

GREENLAND ROAD
(50' WIDE)

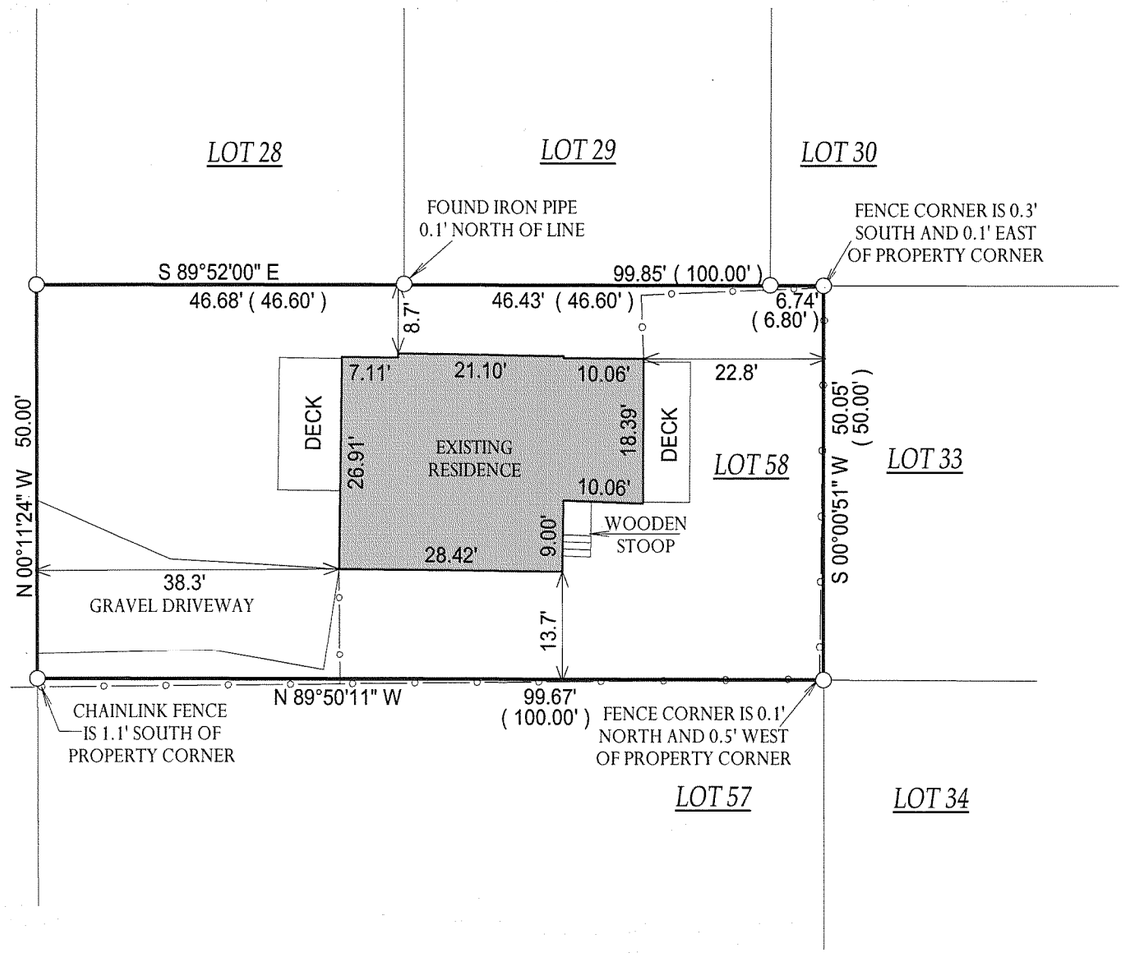

RECEIVED
OCT - 9 2007
BMF

( ) = recorded as
□ = found iron bar
○ = found iron pipe
● = set iron pipe
■ = set iron bar
SCALE: 1" = 20'

JOB #: 06-389UD

TAX ID #: ILGH 00057

COMPARE LEGAL DESCRIPTION ABOVE AND DRAWING WITH DEED. FOR BUILDING RESTRICTIONS AND EASEMENTS NOT SHOWN,REFER TO DEED, ABSTRACT SOURCES AND LOCAL MUNICIPAL CODES. NOTIFY THE SURVEYOR IMMEDIATELY OF ANY DISCREPANCY.

"I hereby certify that I have surveyed the above described property and that the above map, to the best of my knowledge and belief, is a true representation thereof and shows the size and location of all visible structures, apparent easements and encroachmentsif any." This survey is made for the present owners of the property, and those who purchase, mortgage, or guarentee the title thereto, within one year from the date hereof.

NOTE: BASIS OF BEARING IS
PREVIOUS SURVEY OF RECORD.
DATE OF LAST REVISION 9-28-07
DATED THIS 4th DAY OF AUGUST, 2006.

WISCONSIN
JOHN P.
KROTT
S-2258
LAKE GENEVA
WIS.
LAND SURVEYOR

JOHN KROTT S - 2258
Wisconsin Registered Land Surveyor
(original if signed in red)

117-2854