
Plat of Survey

of

Lot 84 of Robinson's Second Subdivision,

located in the Northwest 1/4 of Section 14, Town 1 North, Range 17 East, Town of Linn, Walworth County, Wisconsin.

Surveyed for: **Sam DeSimone**
184 South Street
Elmhurst, Illinois. 60126

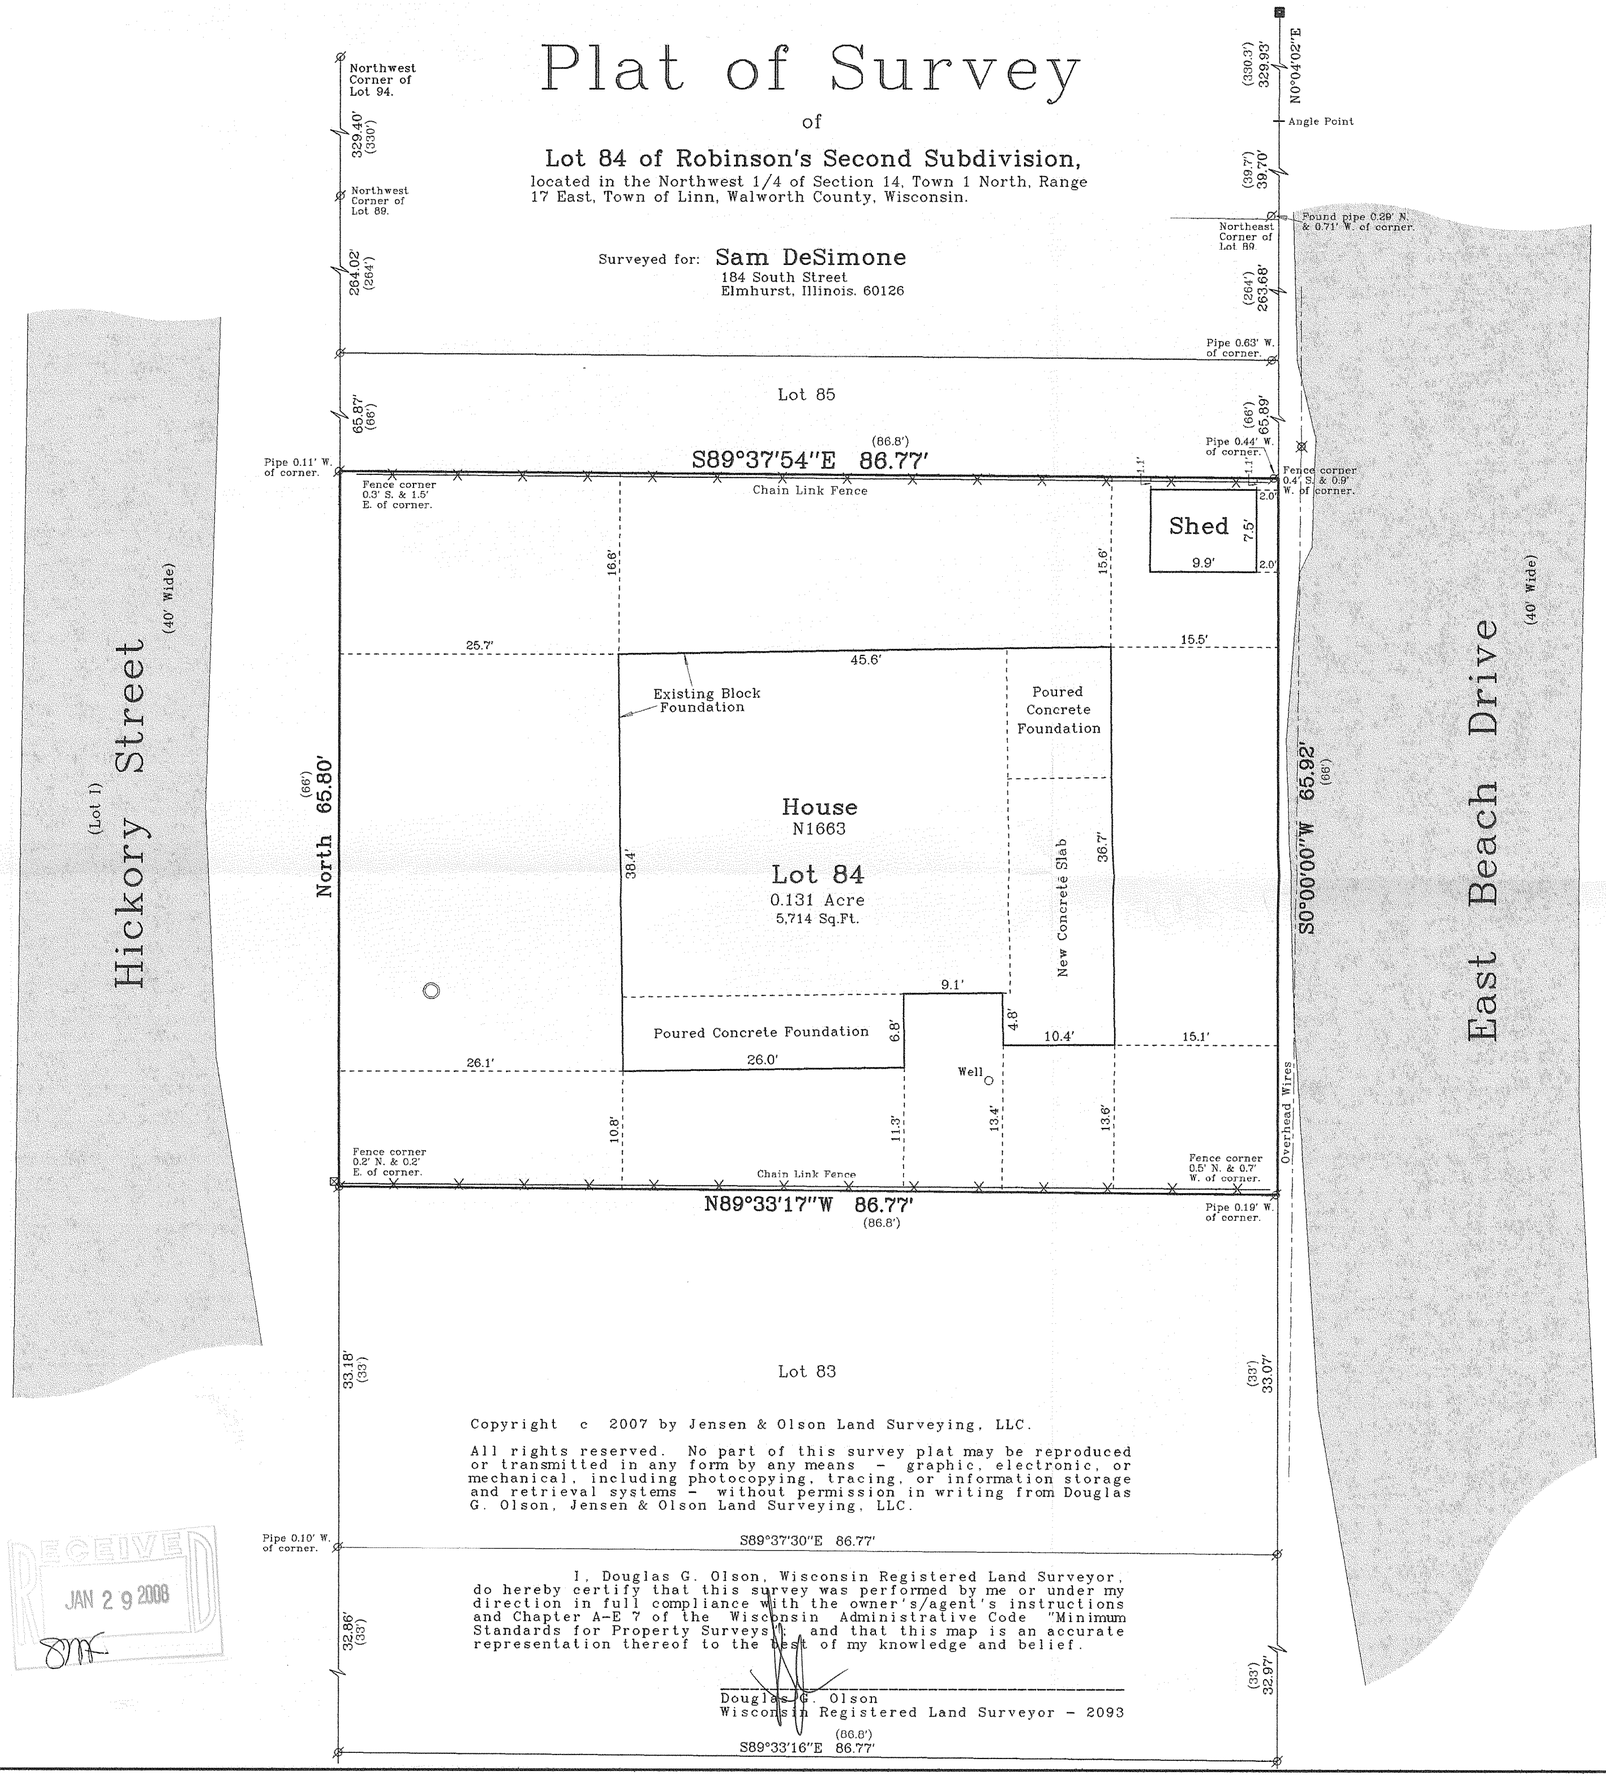

Copyright c 2007 by Jensen & Olson Land Surveying, LLC.

All rights reserved. No part of this survey plat may be reproduced or transmitted in any form by any means - graphic, electronic, or mechanical, including photocopying, tracing, or information storage and retrieval systems - without permission in writing from Douglas G. Olson, Jensen & Olson Land Surveying, LLC.

I, Douglas G. Olson, Wisconsin Registered Land Surveyor, do hereby certify that this survey was performed by me or under my direction in full compliance with the owner's/agent's instructions and Chapter A-E 7 of the Wisconsin Administrative Code "Minimum Standards for Property Surveys", and that this map is an accurate representation thereof to the best of my knowledge and belief.

Douglas G. Olson
Wisconsin Registered Land Surveyor - 2093

RECEIVED
JAN 29 2008

Bearings are assumed.

WISCONSIN
DOUGLAS G. OLSON
S-2093
ELKHORN, WI
LAND SURVEYOR
Not Official Unless Stamped

Notes:

1) This survey plat is not certified unless signed and sealed in red ink.

2) This survey is subject to Wisconsin lien laws. This Plat of Survey is the notice of intent to file lien. Lien waiver required.

Survey Date: May 25, 2007.
Revisions: No. 1 - More pipe
No. 2 - Proposed
No. 3 - Foundation

Scale in Feet
1" = 10'
0' 5' 10' 20'

Jensen & Olson Land Surveying, LLC
45 South Wisconsin Street P.O. Box 322
Elkhorn, Wisconsin. 53121
Telephone (262) 723-3434
Facsimile (262) 723-8044

Legend
Found Stone Monument
Found Iron Pipe
Recorded Information
Utility Pedestal ⊠ Utility Pole
Concrete Cover ◇ Septic Vent
Concrete Surface
Asphalt Surface

Sheet 1 of 1 Sheets
Job Reference Number 2007.066

2007.066

IRB2-68

117-2905