
PREPARED FOR
MARIANE WEIGLEY
C/O BEAA SHEEHAN
KEEFE REAL ESTATE
751 GENEVA PARKWAY
LAKE GENEVA WI. 53147

PLAT OF SURVEY

-OF-

LOTS 25 THRU 32 BLOCK 15 OF WOODDALE ADDITION
LOCATED IN TOWN 1 NORTH, RANGE 17 EAST,
WALWORTH COUNTY, WISCONSIN.

KROTT SURVEYING INC.
N3705 WILLOW BEND LANE
LAKE GENEVA WI. 53147
PHONE # (262)248-3697
FAX # (262)249-0639

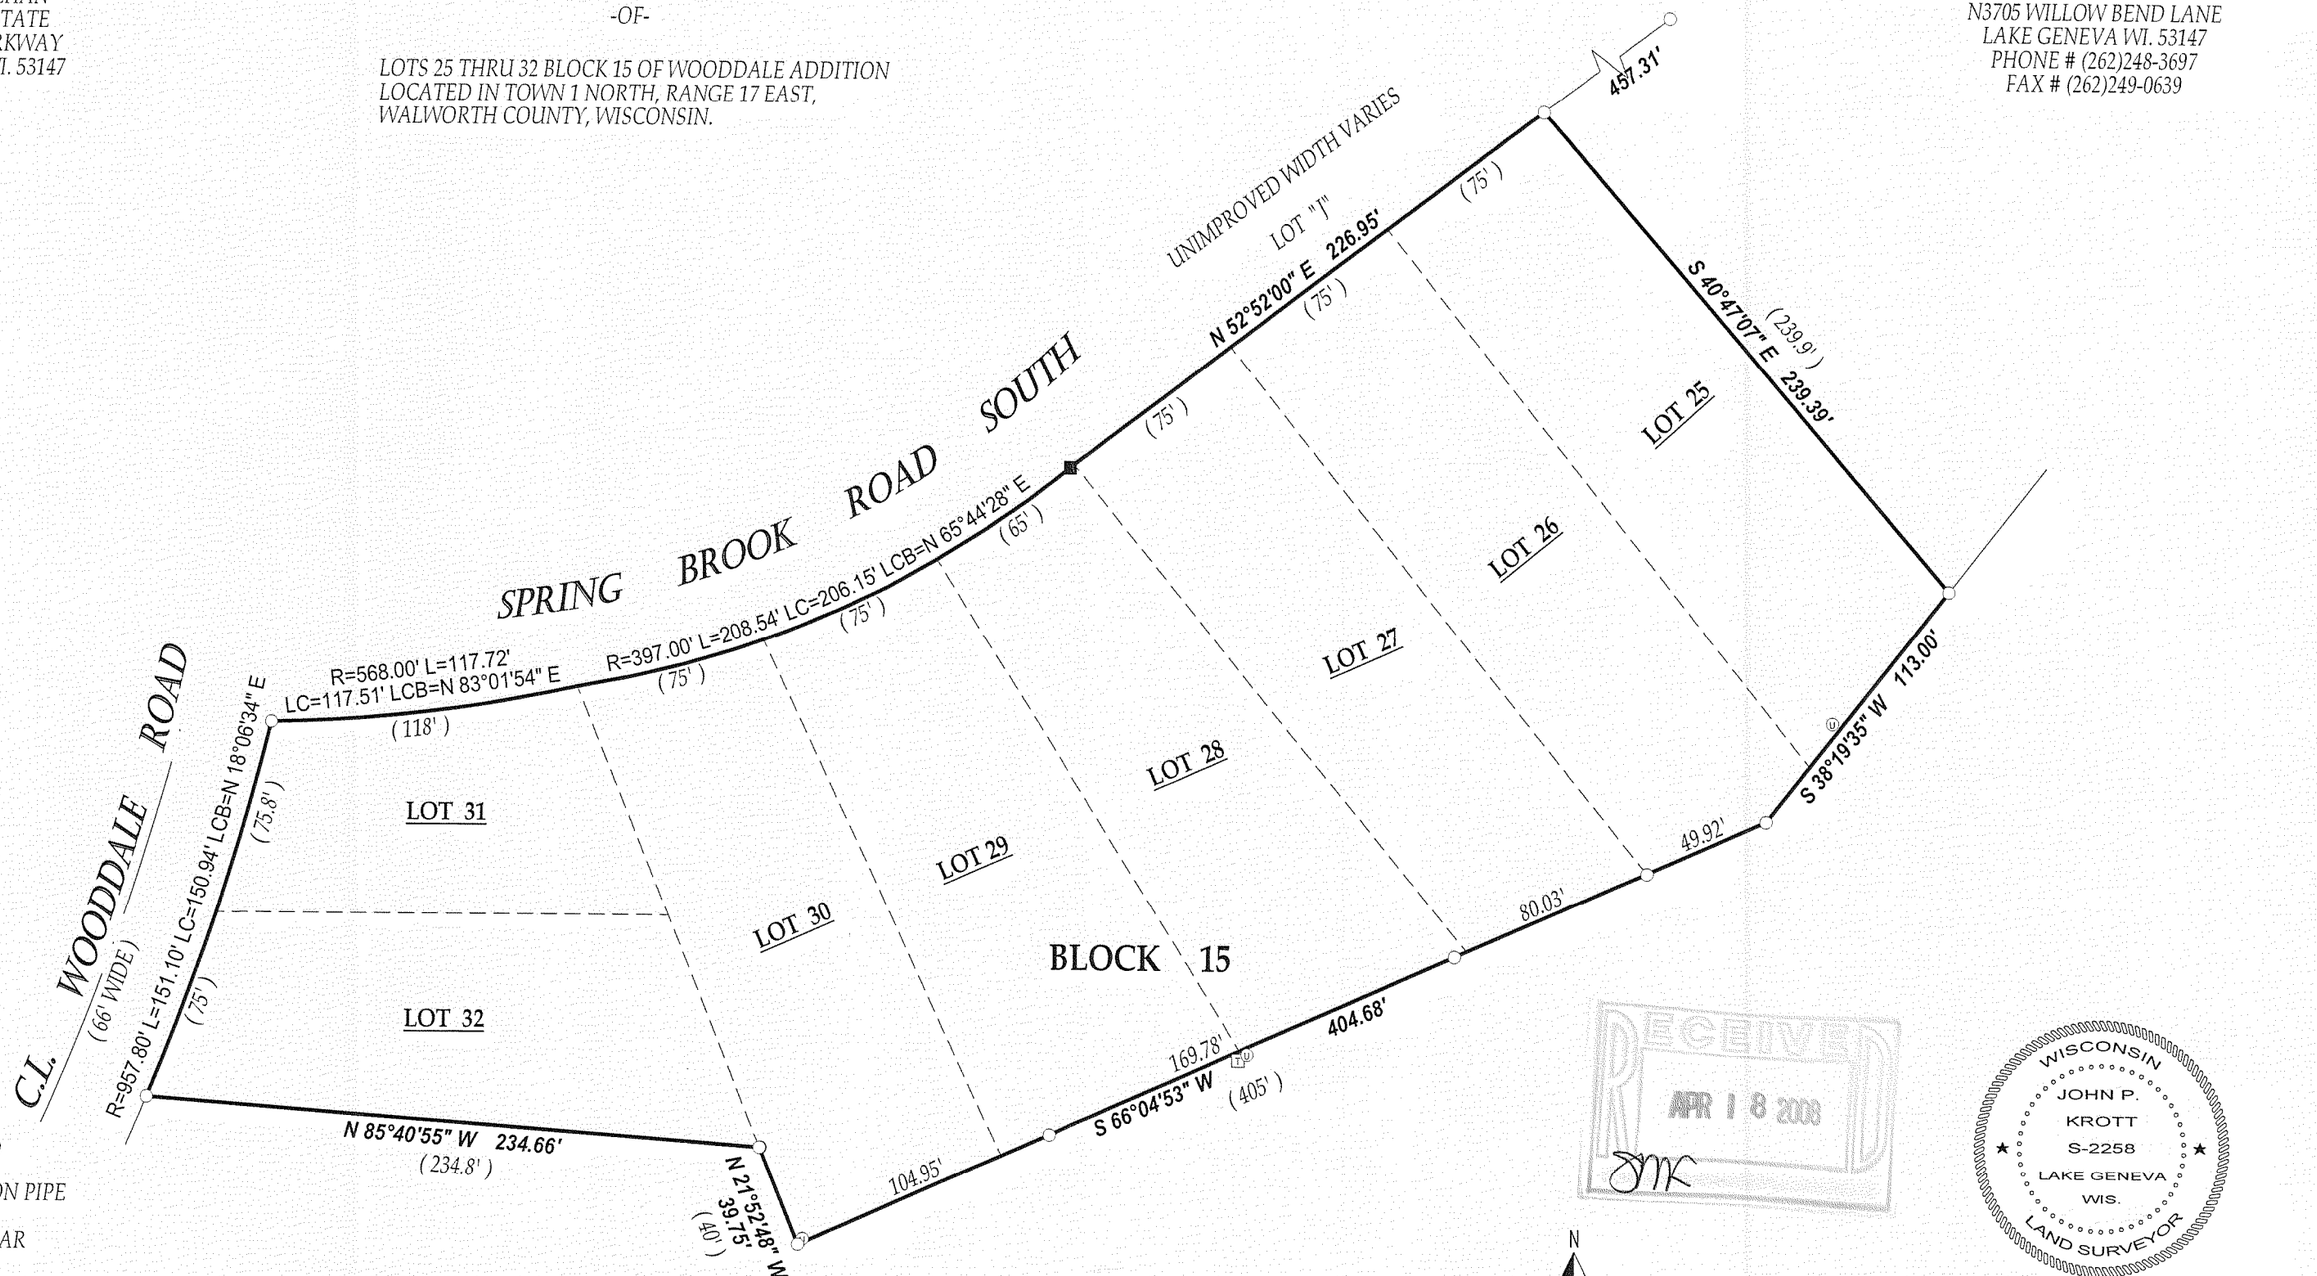

LEGEND


- ○ FOUND IRON PIPE
- ■ SET IRON BAR
- Ⓤ UTILITY PEDISTAL
- T TRANSFORMER
- (XX) RECORDED AS

JOB # 08-056 TAX ID # IW00077E & 78

DATED THIS THE 8th DAY OF APRIL 2008.

COMPARE LEGAL DESCRIPTION ABOVE AND DRAWING WITH DEED. FOR BUILDING RESTRICTIONS AND EASEMENTS NOT SHOWN,REFER TO DEED, ABSTRACT SOURCES AND LOCAL MUNICIPAL CODES. NOTIFY THE SURVEYOR IMMEDIATELY OF ANY DISCREPANCY.

"I hereby certify that I have surveyed the above described property and that the above map is a true representation thereof and shows the size and location of all visible structures, apparent easements and encroachments if any."
This survey is made for the present owners of the property, and those who purchase, mortgage, or guarentee the title thereto, within one year from the date hereof.

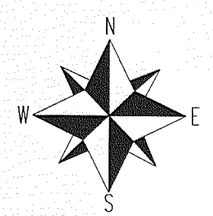

SCALE 1"=60'

0 60 120 180

RECEIVED
APR 18 2008
BMK

JOHN KROTT S - 2258
Wisconsin Registered Land Surveyor
(original if signed in red)

IW-77E IW-78

117-2927