
Plat of Survey

of

Lot 4 of Block 1 of Wooddale Addition,

located in the Southwest 1/4 of Section 9, Town 1 North, Range 17 East, Town of Linn, Walworth County, Wisconsin.

Surveyed for: **Paul Kelly**
14191 Spring Creek Court
Libertyville, Illinois. 60048

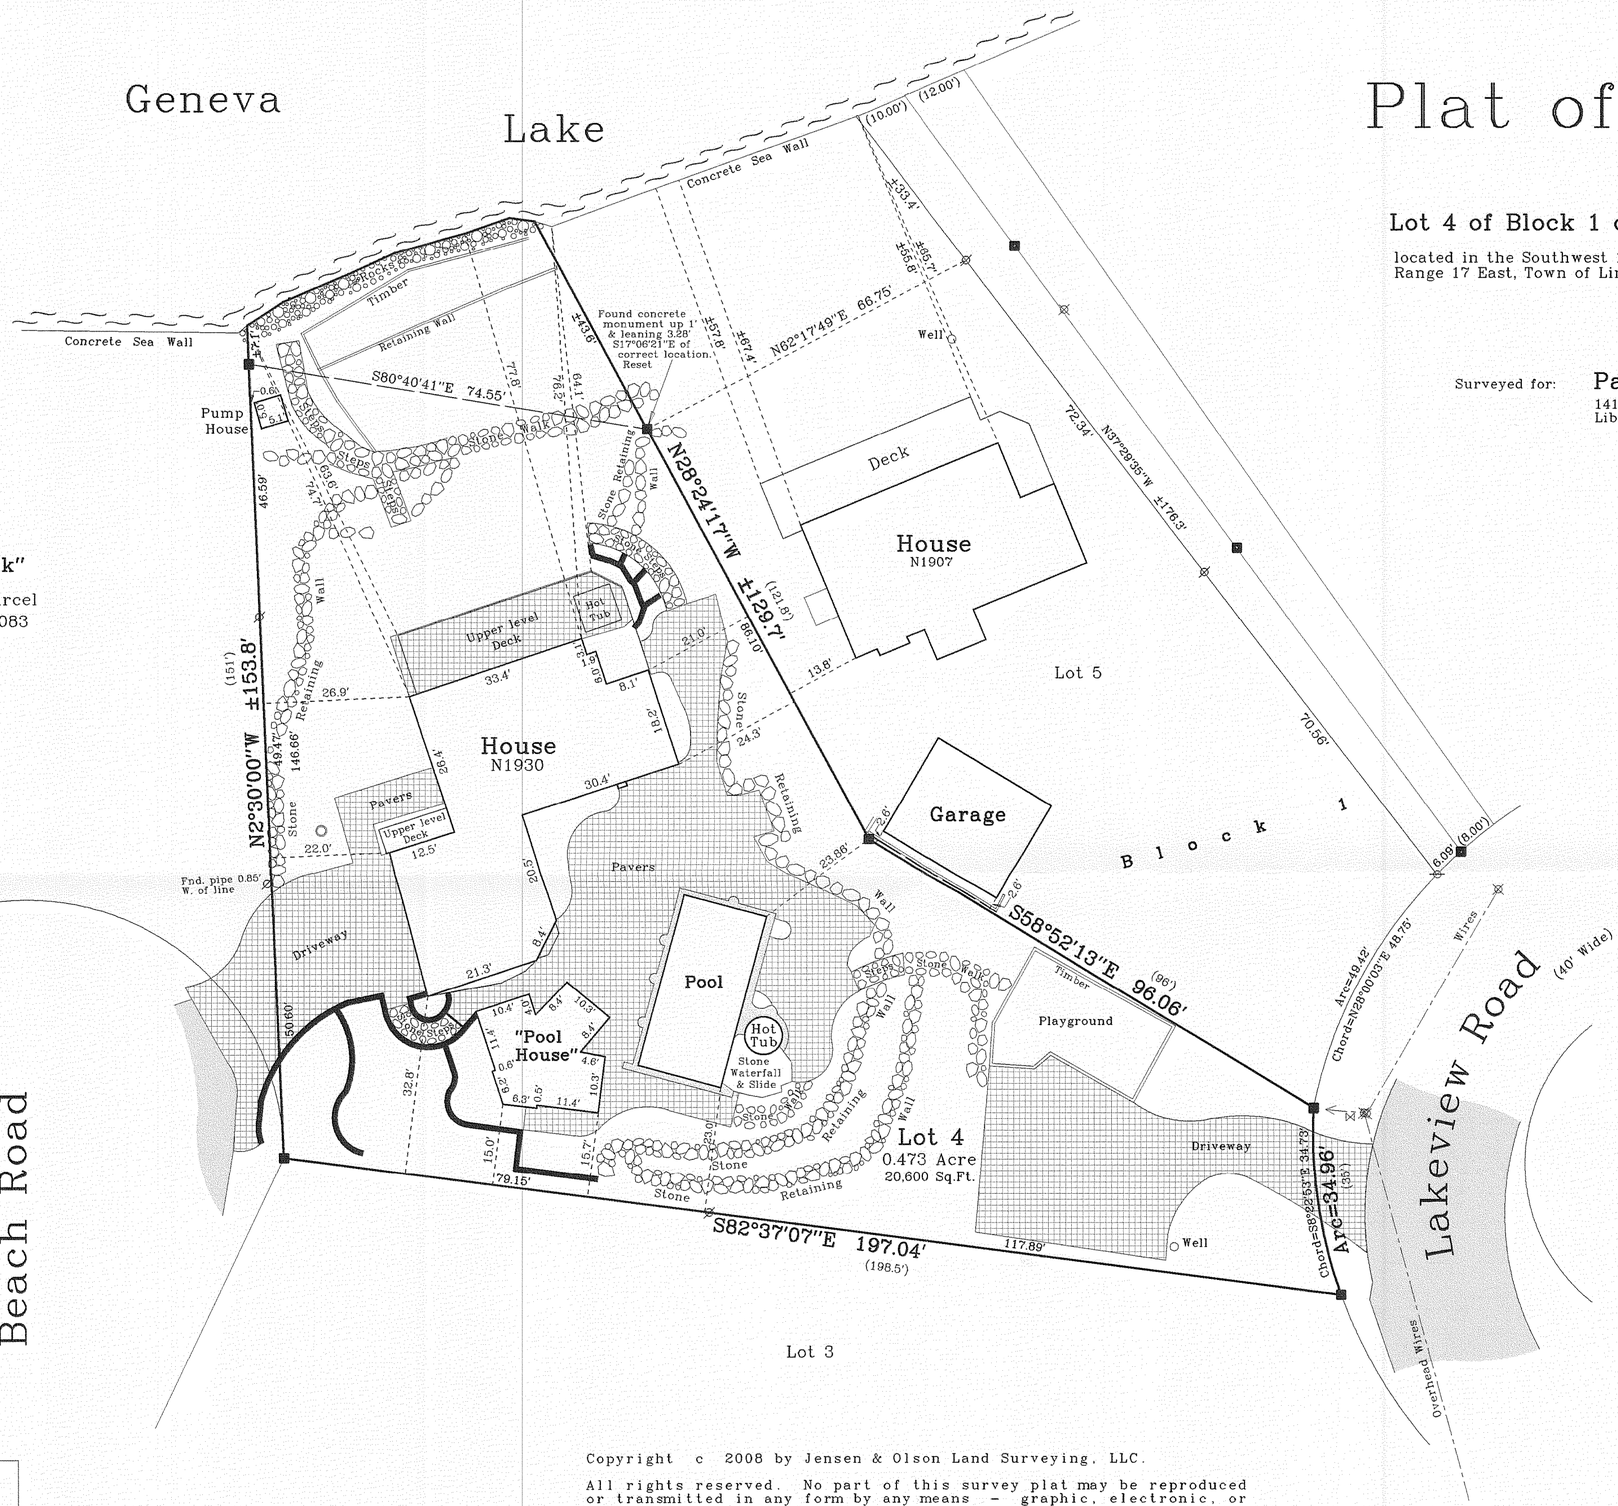

Bearings reference to previous surveys of record.

Note:
Lot 5 dimensions showing the distance from the House and Deck to the shore of Geneva Lake were derived from field measurements made in 1998. No new field measurements were been made to confirm these dimensions.

RECEIVED
MAY - 2 2008

WISCONSIN
DOUGLAS G. OLSON
S-2093
ELKHORN, WI
LAND SURVEYOR
Not Certified Unless Stamped in Red.

Notes:

1) This survey plat is not certified unless signed and sealed in red ink.

2) This survey is subject to Wisconsin lien laws. This Plat of Survey is the notice of intent to file lien. Lien waiver required.

Copyright c 2008 by Jensen & Olson Land Surveying, LLC.

All rights reserved. No part of this survey plat may be reproduced or transmitted in any form by any means - graphic, electronic, or mechanical, including photocopying, tracing, or information storage and retrieval systems - without permission in writing from Douglas G. Olson, Jensen & Olson Land Surveying, LLC.

I, Douglas G. Olson, Wisconsin Registered Land Surveyor, do hereby certify that this survey was performed by me or under my direction in full compliance with the owner's/agent's instructions and Chapter A-E 7 of the Wisconsin Administrative Code "Minimum Standards for Property Surveys"; and that this map is an accurate representation thereof to the best of my knowledge and belief.

Douglas G. Olson
Wisconsin Registered Land Surveyor - 2093

Survey Date: January 10, 2008.
Revisions:

Scale in Feet
1" = 20'
0' 10' 20' 40'

Jensen & Olson Land Surveying, LLC
45 South Wisconsin Street P.O. Box 322
Elkhorn, Wisconsin. 53121
Telephone (262) 723-3434
Facsimile (262) 723-8044

Legend
- Found Concrete Monument
- Found Iron Pipe
- (Recorded Information
- Concrete Surface
- Asphalt Surface
- Pavers
- Block Retaining Wall

Sheet 1 of 1 Sheets

Job Reference Number
2008.007
tlnr17e-2008007-2008007.sbp

2008.007

IW-4

117-2938