
HAROLD H. KOLB

REGISTERED PROFESSIONAL LAND SURVEYOR

LAKE GENEVA, WISCONSIN

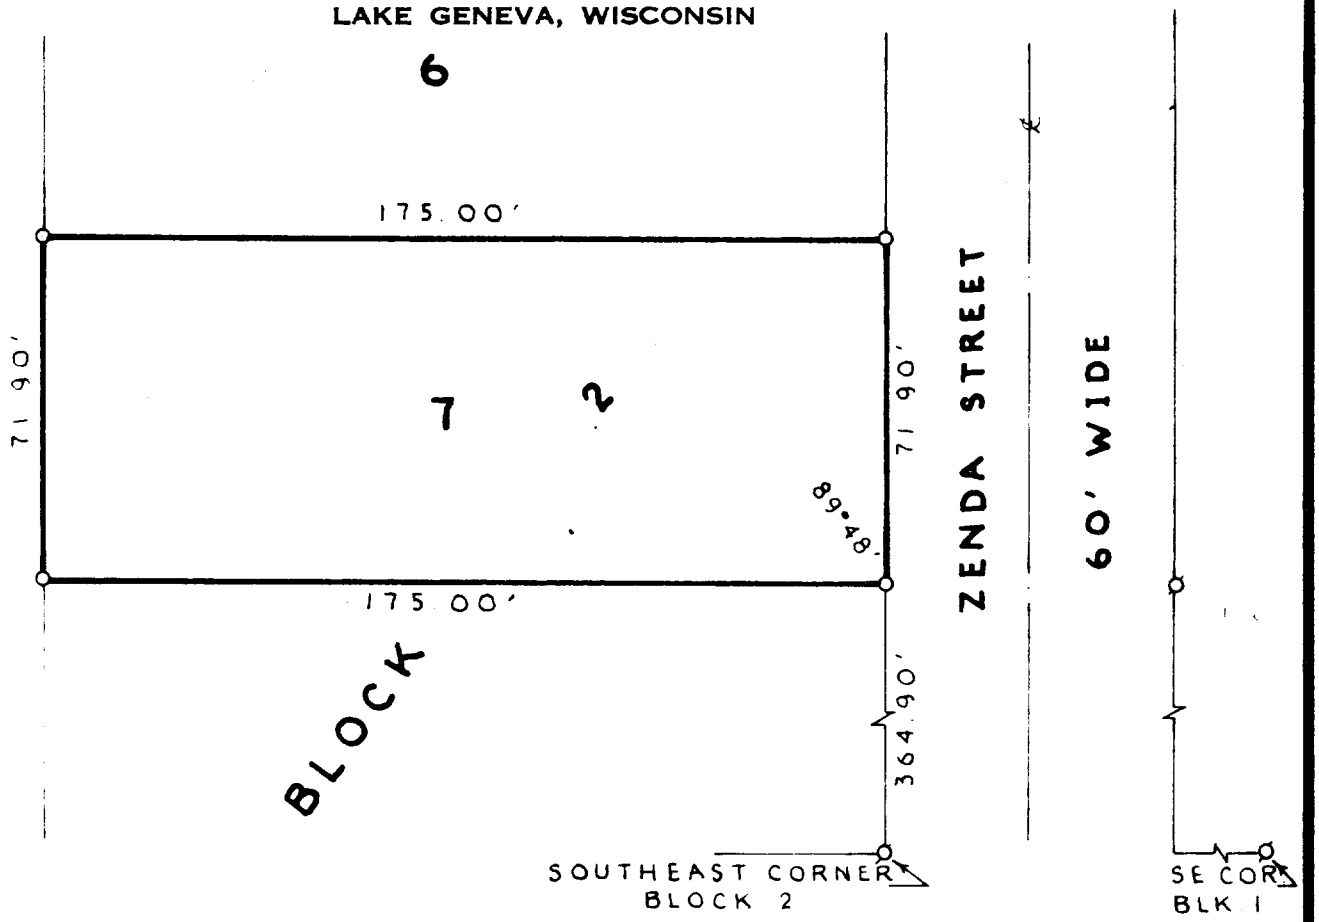

N

SCALE 1"=40'

LEGEND

- ϕ – IRON PIPE FOUND
- O – IRON PIPE PLACED
- ● – CONCRETE MONUMENT
- x – SPIKE

I, HAROLD H. KOLB, DO HEREBY CERTIFY THAT I HAVE SURVEYED THE PROPERTY HEREON DESCRIBED ACCORDING TO THE OFFICIAL RECORDS AND THAT THE PLAT HEREON IS A CORRECT REPRESENTATION OF THE LOT LINES.

Harold H. Kolb

HAROLD H. KOLB

WISCONSIN REGISTERED LAND SURVEYOR, S-187

DATE Sept. 26, 1971

IZK-9A

117-297

BRUNING 40-105 1M 6-71