PREPARED FOR
MARIANE WEIGLEY

PLAT OF SURVEY


-OF-

KROTT SURVEYING INC.
N3705 WILLOW BEND LANE
LAKE GENEVA WI. 53147
PHONE # (262)248-3697
FAX # (262)249-0639

PARCEL "A" LOT 10, BLOCK 4 LAKE GENEVA TERRACE, A SUBDIVISION LOCATED IN SECTION 15, TOWN 1 NORTH, RANGE 17 EAST, WALWORTH COUNTY, WISCONSIN. SAID PARCEL CONTAINING 12,981 SQ FT MORE OR LESS.

PARCEL "B" LOT 9, BLOCK 4 LAKE GENEVA TERRACE, A SUBDIVISION LOCATED IN SECTION 15, TOWN 1 NORTH, RANGE 17 EAST, WALWORTH COUNTY, WISCONSIN. SAID PARCEL CONTAINING 12,977 SQ FT MORE OR LESS.

NOTE : THIS IS A PARCEL SPLIT.

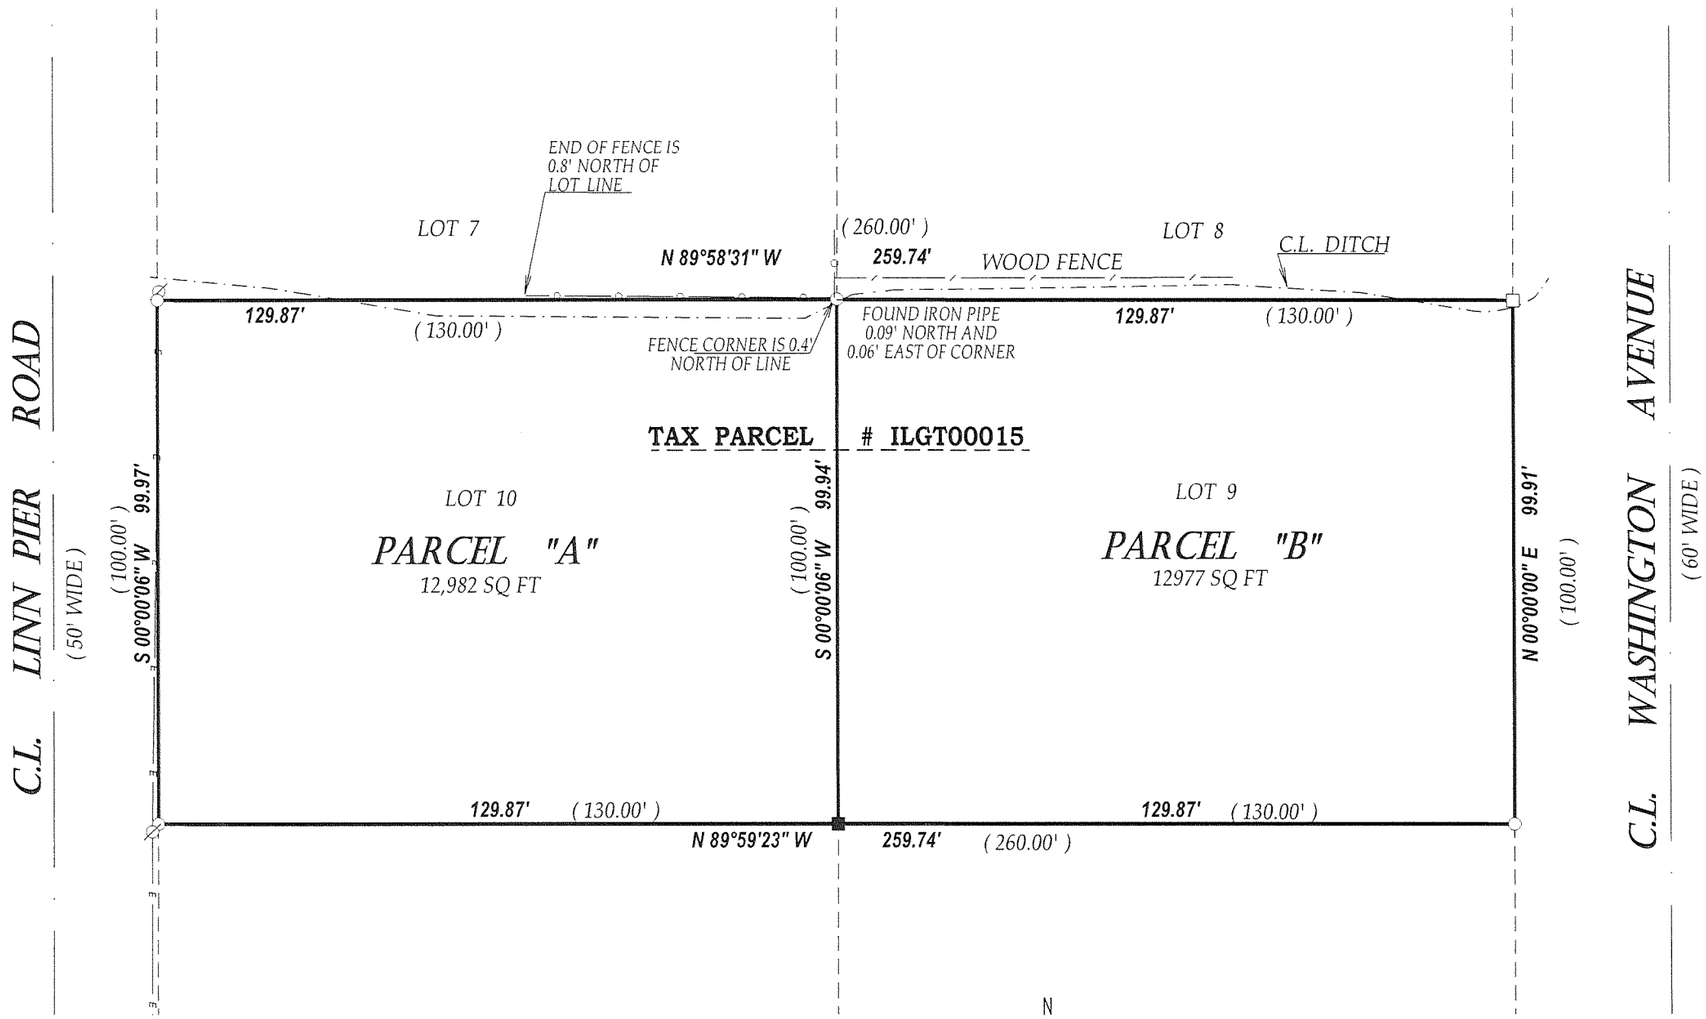

RECEIVED
AUG 12 2008

LEGEND
- ○ FOUND IRON PIPE
- ■ SET IRON BAR
- ⌀ POWER POLE
- E OVERHEAD WIRES
- (XX) RECORDED AS

JOB # 08-057 TAX ID # ILGT00015

COMPARE LEGAL DESCRIPTION ABOVE AND DRAWING WITH DEED. FOR BUILDING RESTRICTIONS AND EASEMENTS NOT SHOWN,REFER TO DEED, ABSTRACT SOURCES AND LOCAL MUNICIPAL CODES. NOTIFY THE SURVEYOR IMMEDIATELY OF ANY DISCREPANCY.

"I hereby certify that I have surveyed the above described property and that the above map is a true representation thereof and shows the size and location of all visible structures, apparent easements and encroachments if any."
This survey is made for the present owners of the property, and those who purchase, mortgage, or guarentee the title thereto, within one year from the date hereof.

N W E S SCALE 1"=30'

0 30 60 90

WISCONSIN JOHN P. KROTT S-2258 LAKE GENEVA WIS. LAND SURVEYOR

DATED THIS 17th, DAY OF JULY, 2008

JOHN KROTT S - 2258
Wisconsin Registered Land Surveyor
(original if signed in red)

117-2970