
44-3

DESCRIPTION:

Commencing at the east ¼ corner of Section Eleven, Town 1 north, Range 17 east, of the 4th P.M., thence north in the east line of said sectionll, 482 feet, thence west 426.75 feet to a point in the easterly line of the P. T. Stark property, thence south 27°-25' east 14.8 feet, to the place of beginning of this, description; thence north 62°-35' east 226.8 feet, thence north 26°-10' west 225 feet, thence north 36°-32' we st 394 .5 feet to a point in the shore of Lake Geneva, thence southwesterly along the shore of said Lake geneva 260 feet more or less to a point in the easterly line of the P. T. Stark property, thence s outh 36°-32' east 588 feet, thence south 27°-25' east 14.8 feet to the place of beginning.

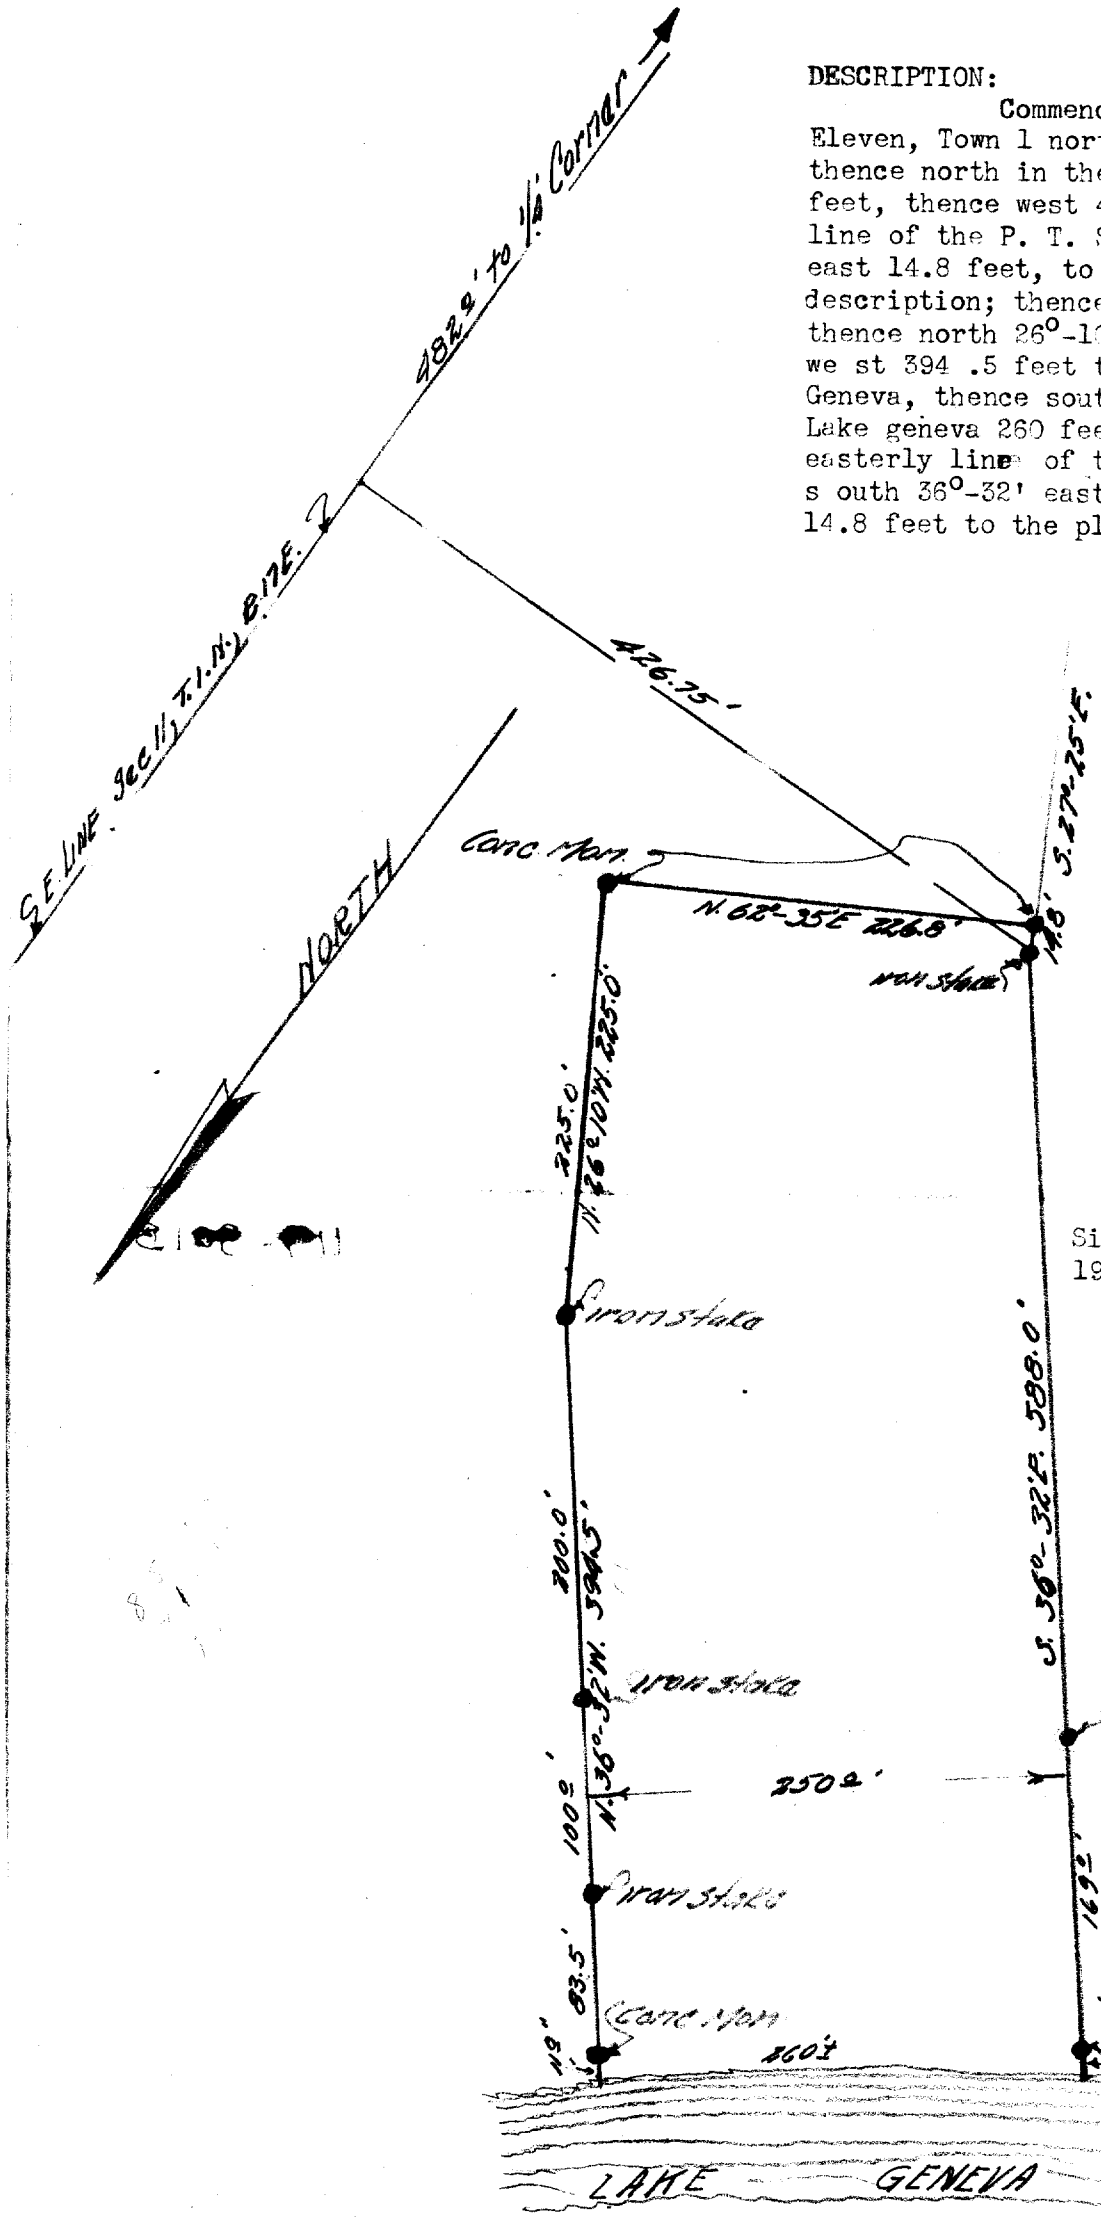

CERTIFICATE:

I hereby certify that I have on this the 1st day of August, 1944, surveyed the above described property, according to the official records on file in the office of the Recorder of Deeds in and for Walworth County Wisconsin, and find that encroachments exist.

Signed and sealed this 2nd day of Aug. 1944.

Joseph M. Biagi.
Professional Engineer
Elkhorn Wisconsin.

L-11-1A

P# 11-2 Before division of property

117-3[illegible]5