
John Walker

PLAT OF SURVEY

LOCATION: 1742 North Linn Road, Lake Geneva, Wisconsin

LEGAL DESCRIPTION: Lot 3 in Block 2 in **LAWRENCE'S ADDITION TO GENEVISTA**, located in Section 10, Town 1 North, Range 17 East, in Walworth County, Wisconsin.

March 26, 2009 Survey No. 101928

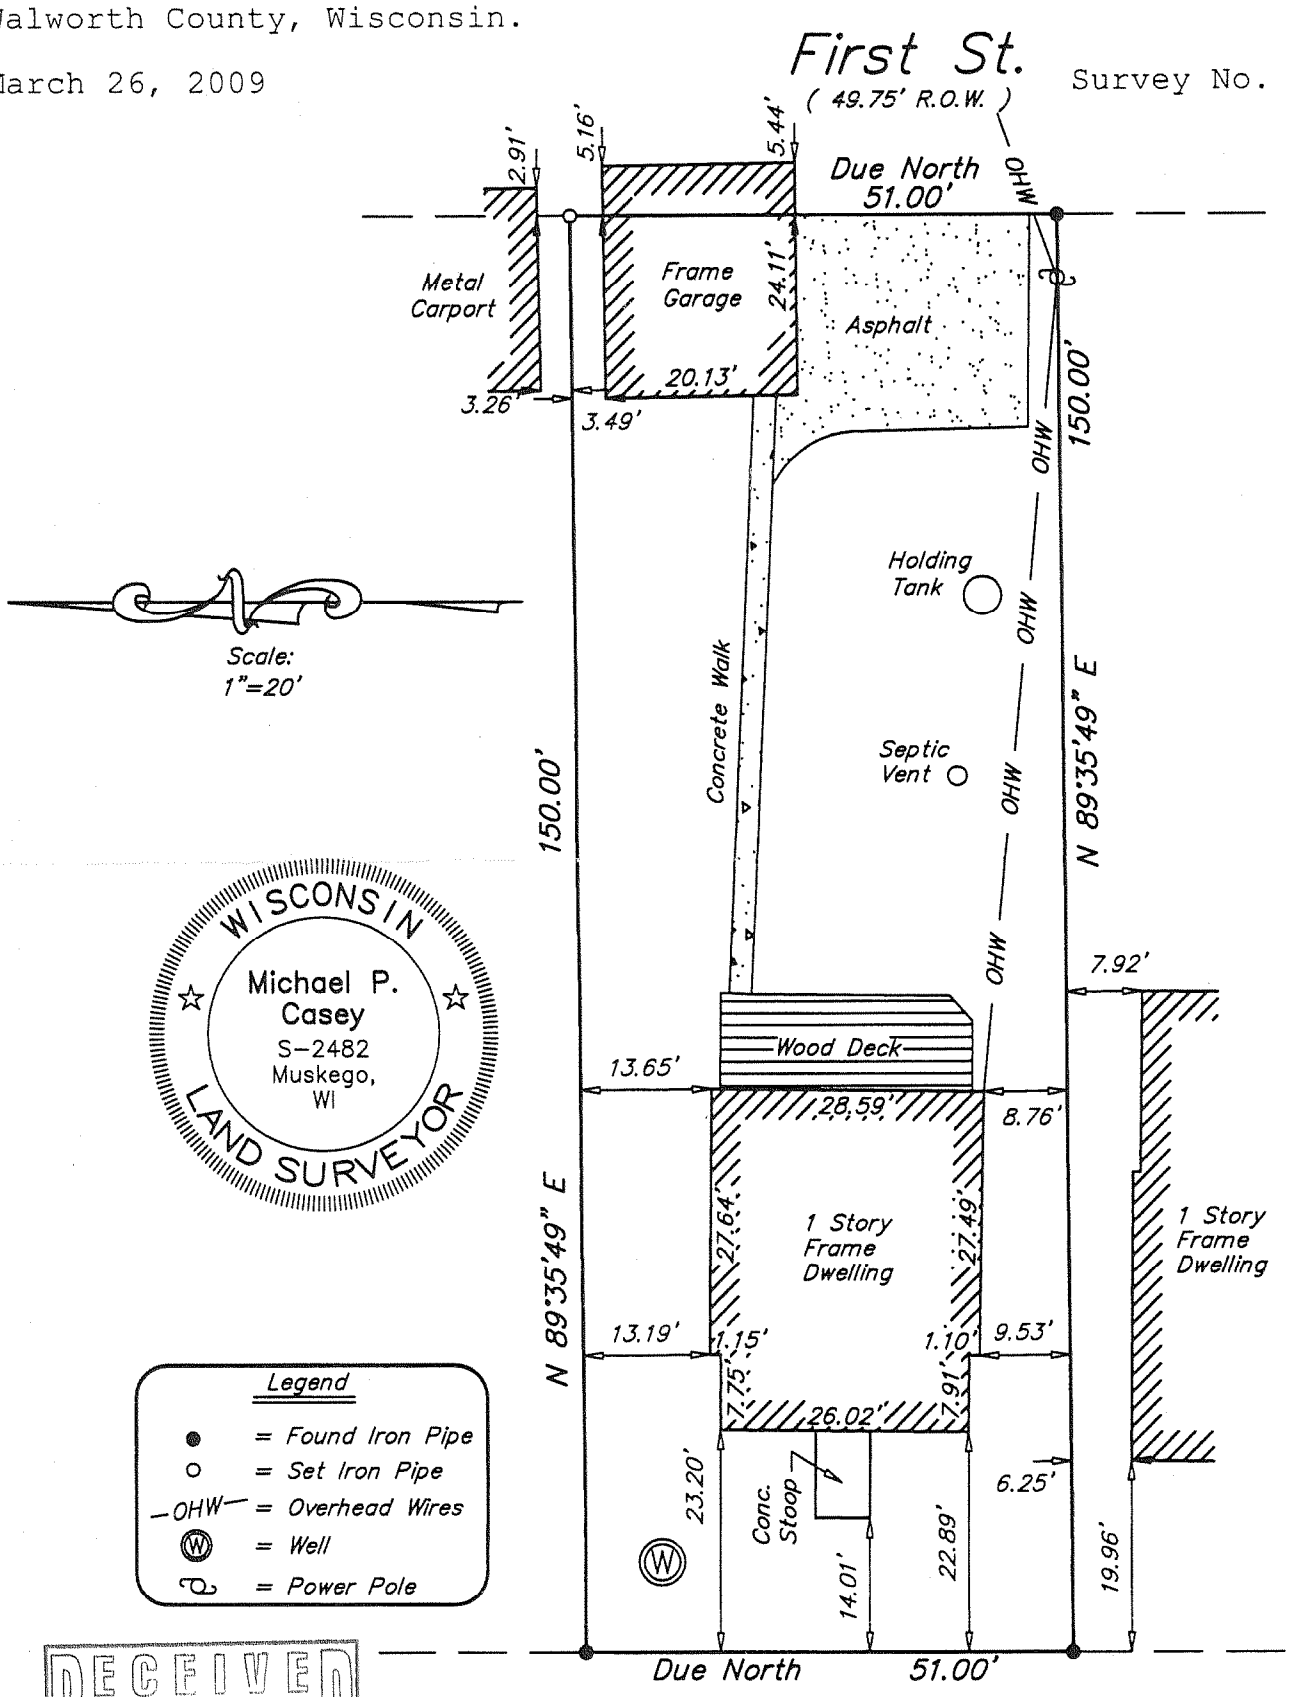

WISCONSIN
Michael P. Casey
S-2482
Muskego, WI
LAND SURVEYOR

Legend
- ● = Found Iron Pipe
- ○ = Set Iron Pipe
- OHW = Overhead Wires
- Ⓦ = Well
- = Power Pole

RECEIVED
MAY 08 2009
By SMF

METROPOLITAN SURVEY SERVICE, INC.

REGISTERED LAND SURVEYORS AND CIVIL ENGINEERS
5307 S. 92nd Street Suite 140 Hales Corners, WI 53130
PH. (414) 529-5380 FAX (414) 529-9787
email address survey@bizwi.rr.com

I HEREBY CERTIFY THAT I HAVE SURVEYED THE ABOVE DESCRIBED PROPERTY AND THAT THE ABOVE MAP IS A TRUE REPRESENTATION THEREOF AND SHOWS THE SIZE AND LOCATION OF THE PROPERTY. ITS EXTERIOR BOUNDARIES, THE LOCATION OF ALL VISIBLE STRUCTURES AND PRINCIPAL BUILDINGS THEREON, BOUNDARY FENCES, APPARENT EASEMENTS AND ROADWAYS AND VISIBLE ENCROACHMENT, IF ANY.

THIS SURVEY IS MADE FOR THE EXCLUSIVE USE OF THE PRESENT OWNERS OF THE PROPERTY, AND ALSO THOSE WHO PURCHASE, MORTGAGE, OR GUARANTEE THE TITLE THERETO WITHIN ONE (1) YEAR FROM THE DATE HEREOF.

SIGNED Michael P. Casey
Michael P. Casey
Registered Land Surveyor S-2482

IGVL-6 11-2006