
ABELL
SURVEYING & MAPPING

1140 SEQUOIA STREET • DELAVAN, WISCONSIN 53115
262-728-6737

LOT 111

SURVEYED BY ROBERT M. BAERENWALD MAY 7, 2002

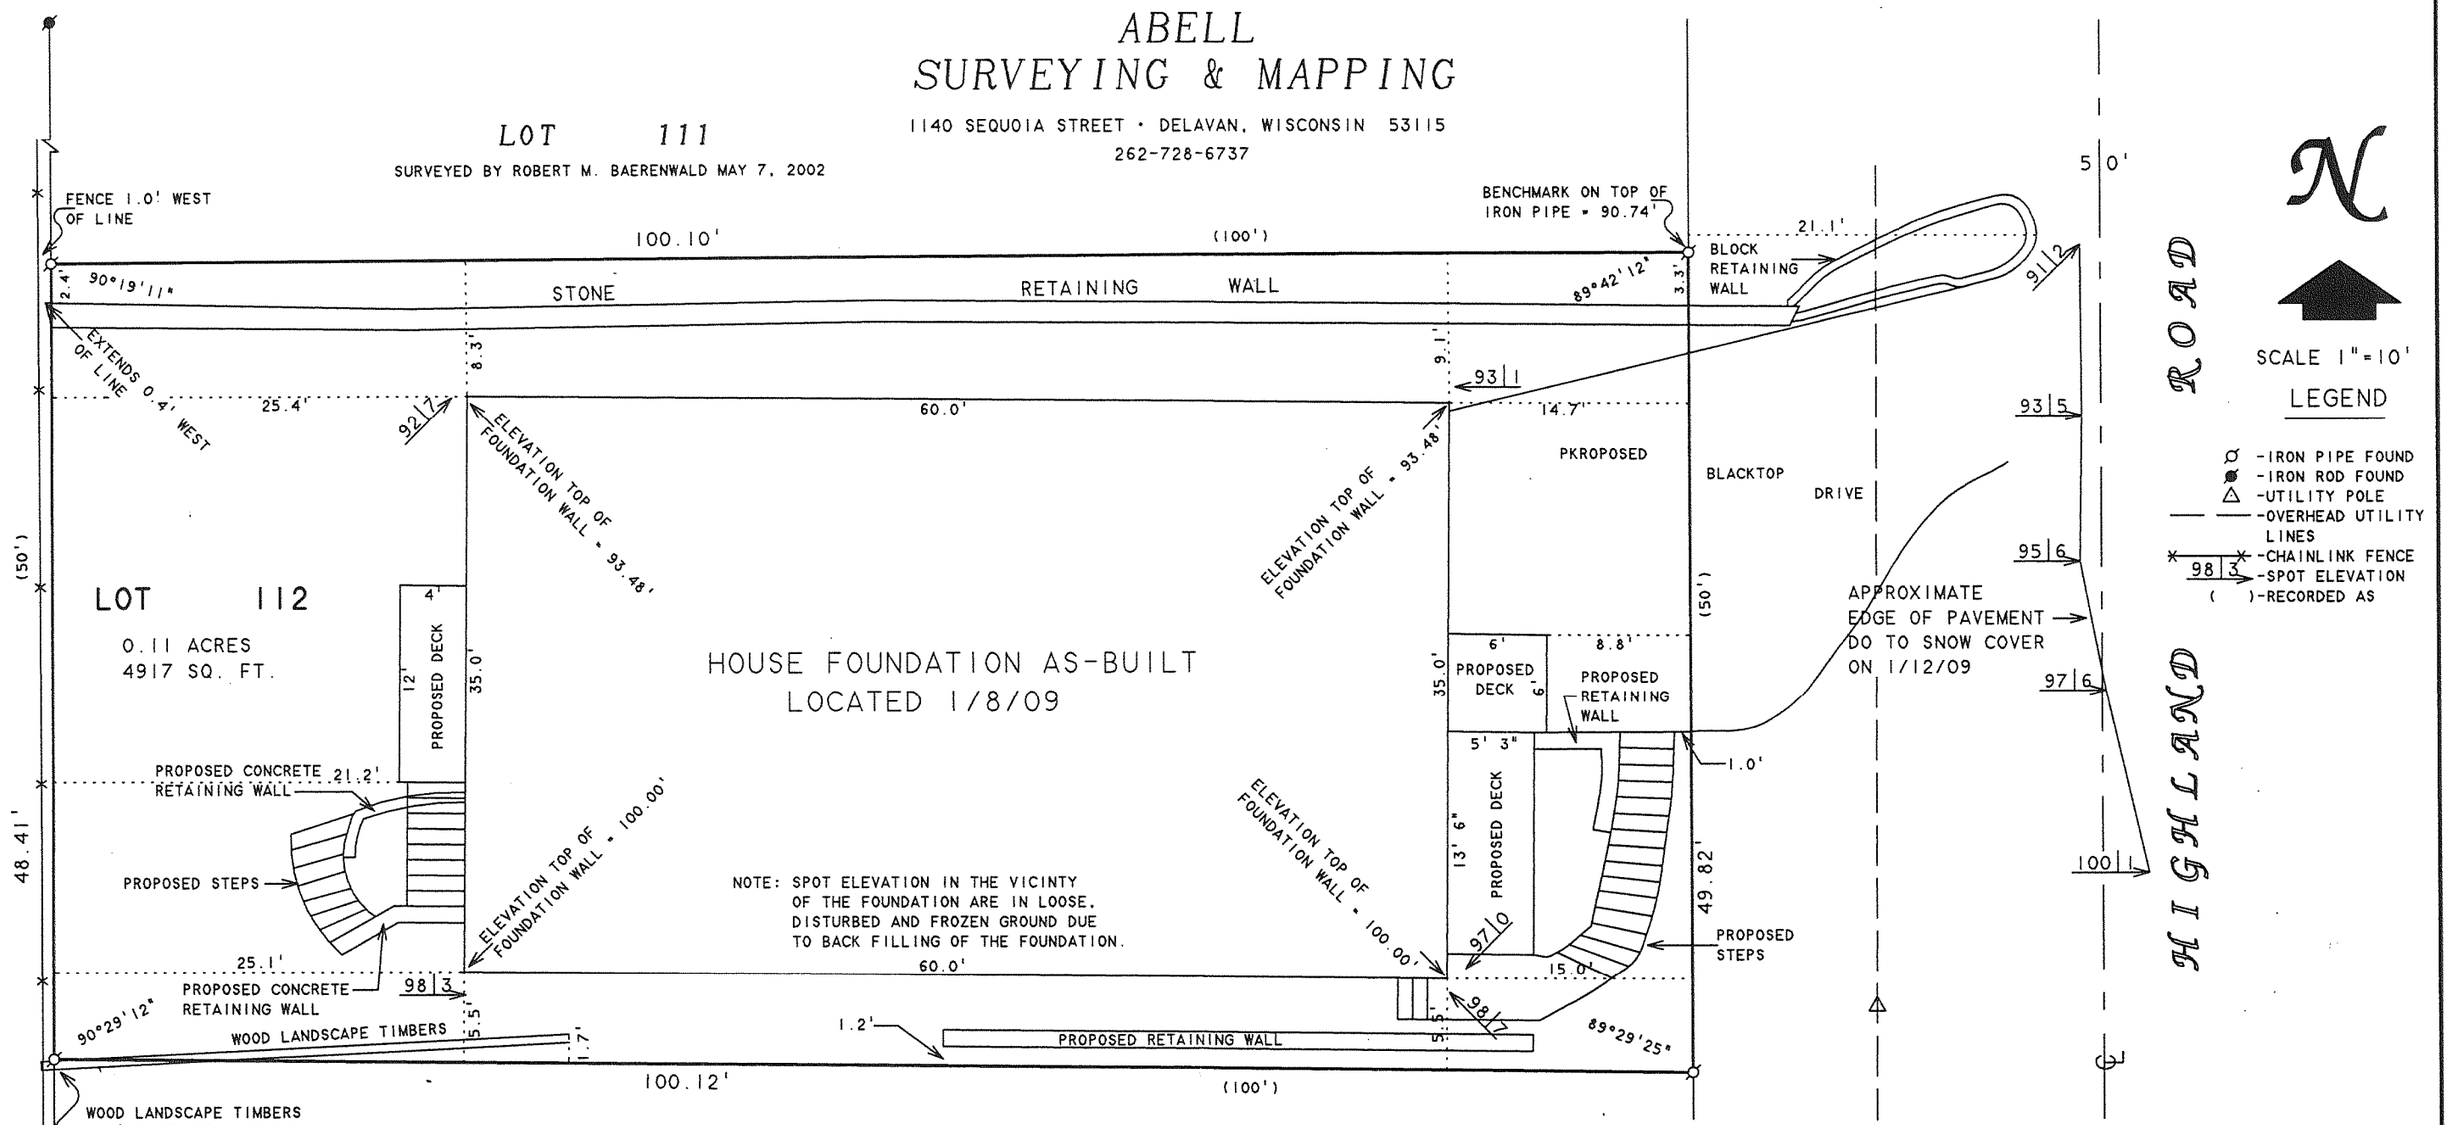

LOT 113

SURVEYED BY ROBERT M. BAERENWALD MAY 22, 1988

RECEIVED
MAY 14 2009
By

PLAT OF SURVEY OF

LOT 112, LAKE GENEVA HIGHLANDS, LOCATED IN T1N, R17E, TOWN OF LINN, WALWORTH COUNTY, WISCONSIN.

ORDERED BY: TAGGART REALTY
98 E. MAIN STREET
LAKE GENEVA, WI 53147

REVISED: FEBRUARY 26, 2009 TO SHOW PROPOSED DECKS, RETAINING WALLS, STEPS AND BLACKTOP DRIVE.

I HEREBY CERTIFY THAT I HAVE SURVEYED THE ABOVE DESCRIBED PROPERTY AND THAT THE ABOVE MAP IS A TRUE REPRESENTATION THEREOF AND SHOWS THE SIZE AND LOCATION OF THE PROPERTY, ITS EXTERIOR BOUNDARIES, THE LOCATION OF ALL VISIBLE STRUCTURES AND DIMENSIONS OF ALL PRINCIPAL BUILDINGS THEREON, BOUNDARY FENCES, APPARENT EASEMENTS, ROADWAYS AND VISIBLE ENCROACHMENTS, IF ANY, TO THE BEST OF MY KNOWLEDGE AND BELIEF.

THIS SURVEY IS MADE FOR THE USE OF THE PRESENT OWNERS OF THE PROPERTY, AND ALSO THOSE WHO PURCHASE, MORTGAGE, OR GUARANTEE THE TITLE THERETO WITHIN ONE (1) YEAR FROM DATE HEREON.

David F. Abell

DAVID F. ABELL
WISCONSIN REGISTERED LAND SURVEYOR, S-1596

January 12, 2009

DATE JOB NUMBER - 08028G

NOTE: THIS IS NOT A CERTIFIED COPY UNLESS SEALED.

ILGH-109

117-3029