
PREPARED FOR
PETER EDWARDS
W4029 ELGIN CLUB DR.
LAKE GENEVA WI. 53147

PLAT OF SURVEY

-OF-

LOT 8 OF ELGIN CLUB, ACCORDING TO THE RECORDED PLAT THEREOF ON FILE IN THE OFFICE OF THE REGISTER OF DEEDS FOR WALWORTH COUNTY, WISCONSIN, RECORDED IN VOLUME 8 OF PLATS, AT PAGES 145 AND 146.


KROTT SURVEYING INC.
N3705 WILLOW BEND LANE
LAKE GENEVA WI. 53147
PHONE # (262)248-3697
FAX # (262)249-0639

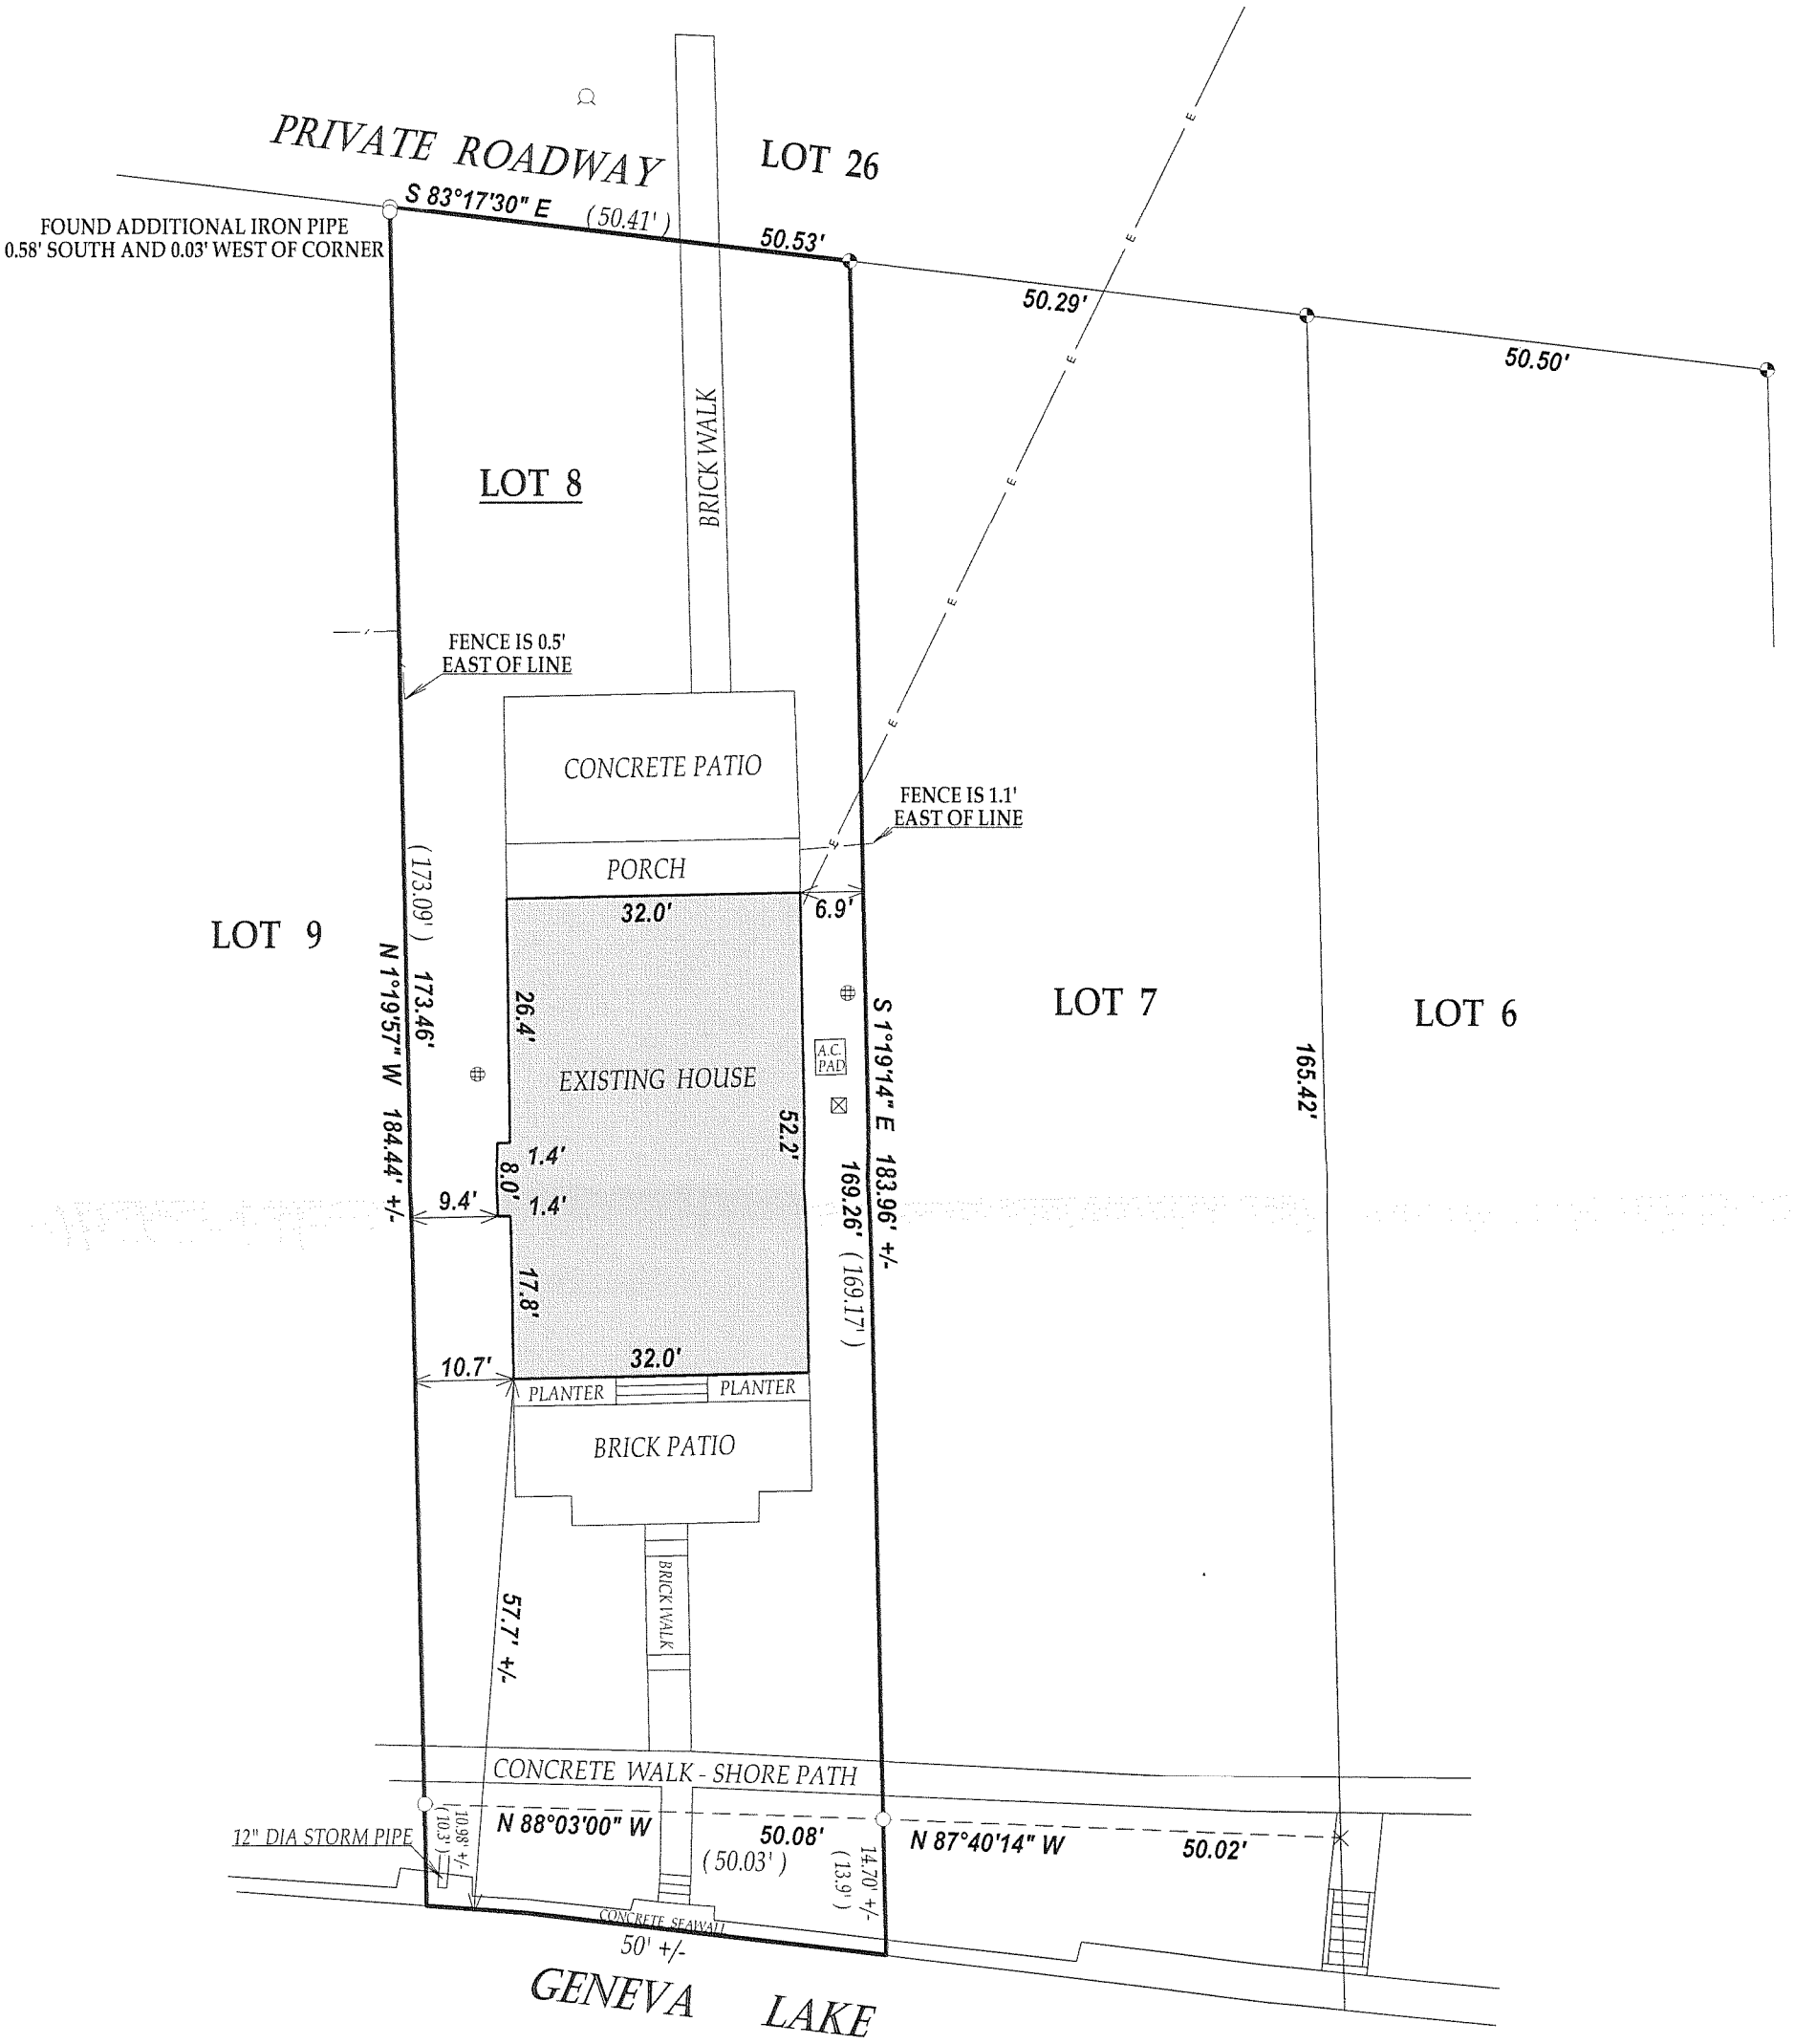

LEGEND

- ○ FOUND IRON PIPE
- × FOUND CUT CROSS IN CONCRETE
- ◒ FOUND CONCRETE MONUMENT
- ⊕ CONCRETE LID
- ⊠ TV ANTENA
- ⍜ WELL
- ⌀ UTILITY POLE
- —E— OVER HEAD WIRES
- (XX) RECORDED AS

JOB # 09-026 TAX ID # 1EC00008

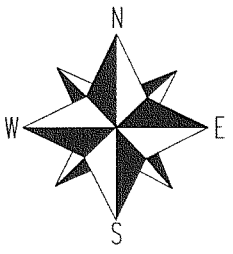



SCALE 1" = 20'

0 20 40 60

BASIS OF BEARING IS THE RECORD PLAT

"I hereby certify that I have surveyed the above described property and that the above map is a true representation thereof and shows the size and location of all visible structures, apparent easements and encroachments if any."
This survey is made for the present owners of the property, and those who purchase, mortgage, or guarentee the title thereto, within one year from the date hereof.

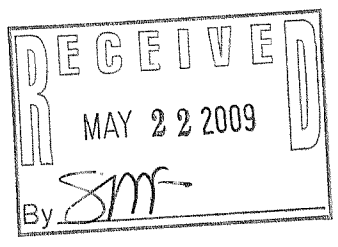

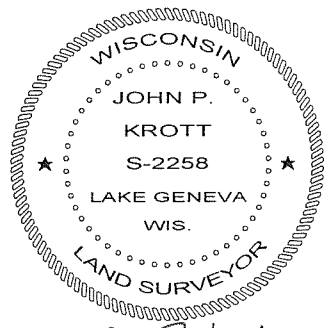

JOHN KROTT S - 2258
Wisconsin Registered Land Surveyor
(original if signed in red)

DATED THIS 3rd DAY OF APRIL 2009.

IEC-8

117-3046