
RECEIVED
JUN 24 2009
By SMF

FARRIS, HANSEN & ASSOC. INC.
7 RIDGWAY COURT– P.O. BOX 437
ELKHORN, WISCONSIN 53121
PHONE (262) 723–2098
FAX (262) 723–5886

WORK ORDERED BY:
JOHN LAW–REMAX–GENEVA REALTY LTD.
101 BROAD STREET, SUITE 102
LAKE GENEVA, WI 53147

PLAT OF SURVEY

LOT 1 OF CERTIFIED SURVEY MAP NO. 4017 LOCATED IN PART OF THE NE 1/4 OF THE SE 1/4 OF SECTION 22, TOWN 1 NORTH, RANGE 17 EAST, TOWN OF LINN, WALWORTH COUNTY, WISCONSIN

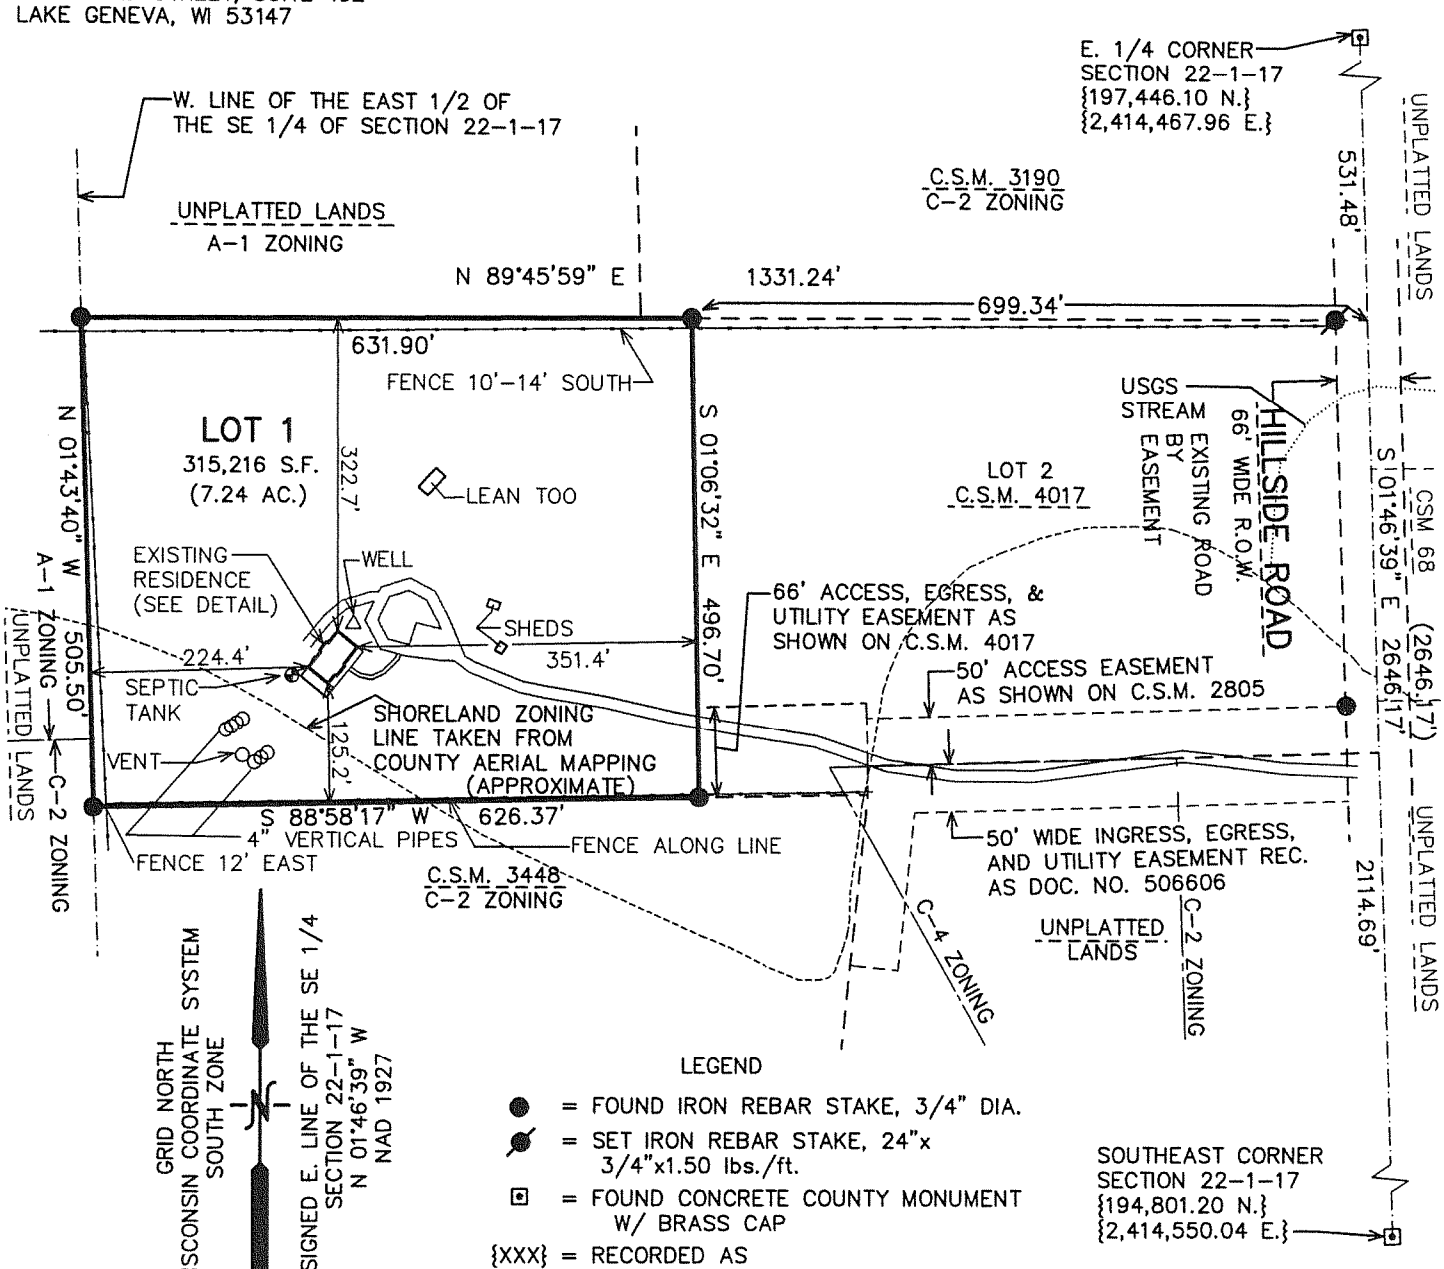


LEGEND

- ● = FOUND IRON REBAR STAKE, 3/4" DIA.
- ⁄● = SET IRON REBAR STAKE, 24"x 3/4"x1.50 lbs./ft.
- ⊡ = FOUND CONCRETE COUNTY MONUMENT W/ BRASS CAP
- {XXX} = RECORDED AS

200 100 0 200 400 600 800

MAP SCALE IN FEET ORIGINAL 1"= 200'

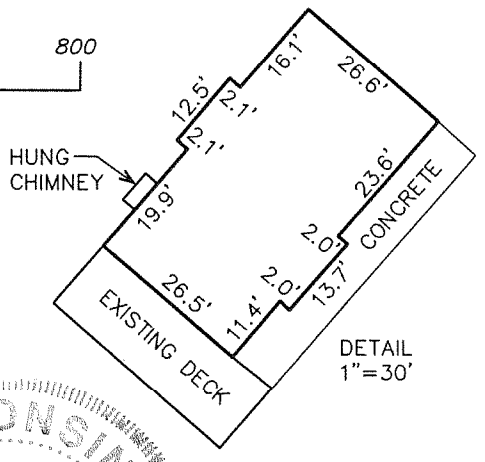

DETAIL
1"=30'

NOTE: COPIES OF THIS MAP TO WHICH THE FOLLOWING CERTIFICATE WILL APPLY SHOW THE SURVEYOR'S ORIGINAL SEAL AND SIGNATURE IN RED INK. COPIES BY ANY OTHER MEANS MAY HAVE ALTERATIONS WHICH DO NOT REPRESENT THE SURVEYOR'S WORK PRODUCT.

I HEREBY CERTIFY THAT THE ABOVE DESCRIBED PROPERTY HAS BEEN SURVEYED UNDER MY DIRECTION AND THAT THE ABOVE MAP IS A TRUE REPRESENTATION THEREOF AND SHOWS THE SIZE AND LOCATION OF THE PROPERTY AND ITS EXTERIOR BOUNDARIES. THIS SURVEY IS MADE FOR THE USE OF THE PRESENT OWNERS OF THE PROPERTY, AND ALSO THOSE WHO PURCHASE, MORTGAGE, OR GUARANTEE THE TITLE THERETO WITHIN ONE YEAR FROM THE DATE HEREOF.

DATED: MAY 26, 2009

PETER S. GORDON R.L.S. 2101

WISCONSIN
PETER S. GORDON
S-2101
ELKHORN, WI
LAND SURVEYOR

PROJECT NO. 5538.06.09
DATED: 5/26/2009
SHEET 1 OF 1 SHEETS

MAY 29 2009

IN4017-1

17-2059