

Plat of Survey

of


Lands described in Title Commitment No. 71839 by Security Title of Walworth County, effective date June 8, 2000 as shown below:

Parcel 1 - The S. 561 ft. of Lot 7 Block 3, Rowena Park, being a subdivision in the Town of Linn, Walworth County, Wisconsin, except that part conveyed by Warranty Deed to Walworth County dated June 23, 1959 and recorded July 31, 1959 in Vol. 542 of Deeds page 409, #511743. Also excepting Certified Survey #118 recorded in the office of the Register of Deeds for Walworth County, Wisconsin, on the 7th day of January, 1972, in Vol. 1 of CS on page 118, County of Walworth, State of Wisconsin.


Parcel 2 - Lot No. 1 of Certified Survey No. 118, according to the plat thereof, recorded in Volume 1 of Certified Surveys on page 118 as Document No. 645263, Walworth County Records.

Tax Key No. 1A11800001 and IRP 00034B

Surveyed for: **Robert Reesman**
3825 North Central Avenue
Chicago, Illinois. 60634

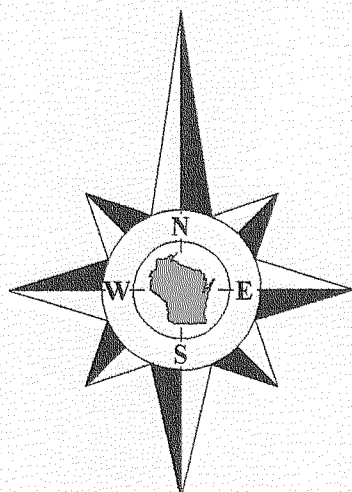

Bearings referenced to Certified Survey Map No. 1260.

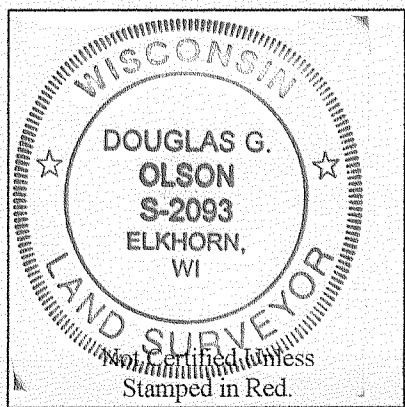

Notes:



- 1) This survey plat is not certified unless signed and sealed in red ink.
- 2) This survey is subject to Wisconsin lien laws. This Plat of Survey is the notice of intent to file lien. Lien waiver required.

Copyright 2000 by Jensen & Olson Land Surveying, LLC.

All rights reserved. No part of this survey plat may be reproduced or transmitted in any form by any means - graphic, electronic, or mechanical, including photocopying, tracing, or information storage and retrieval systems - without permission in writing from Douglas G. Olson, Jensen & Olson Land Surveying, LLC.

I hereby certify that I have surveyed the above described property and the map hereon is correct to the best of my professional knowledge and belief and shows the size and location of the property, its exterior boundaries, the location and dimensions of all visible structures thereon, boundary fences, apparent easements and roadways and visible encroachments, if any.
This survey is made for the exclusive use of the present owners of the property, and also those who purchase, mortgage or guarantee title thereto, within one year from the date hereof.

Douglas G. Olson
Wisconsin Registered Land Surveyor - 2093

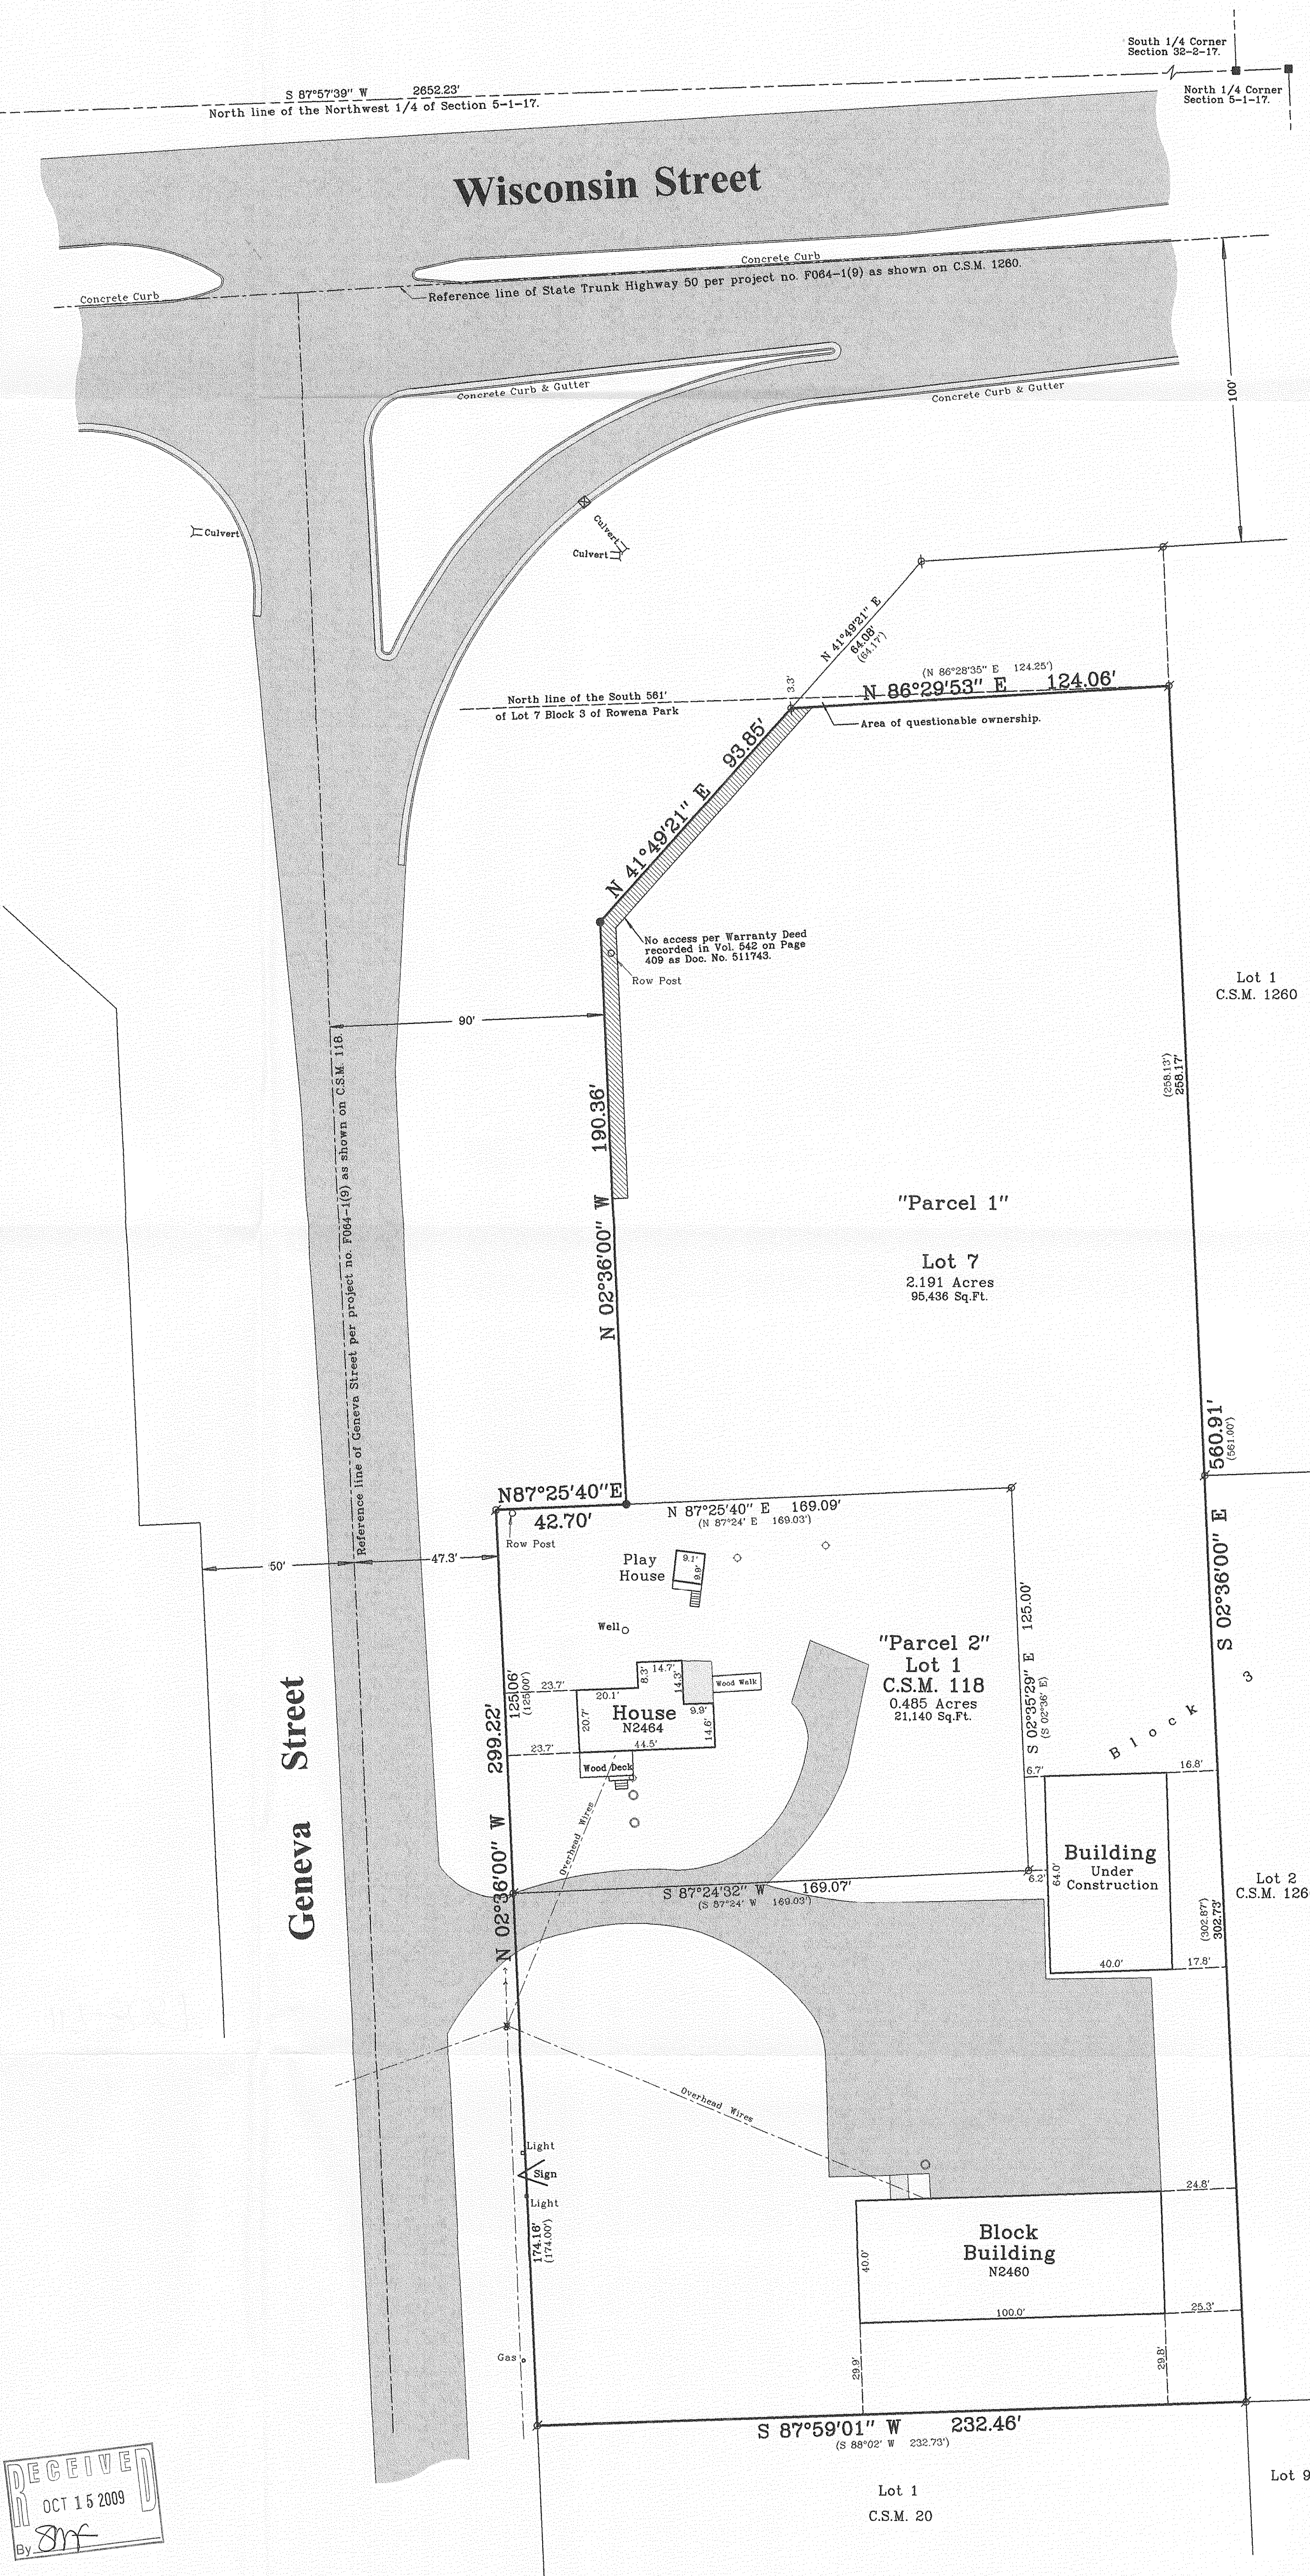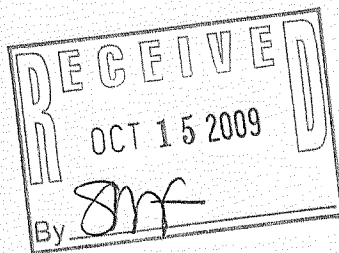

2009.038	Sheet 1 of 1 Sheets	Legend - Found County Section Corner - Found Iron Pipe - Set Iron Rod, 3/4" diameter - Recorded Information - Utility Pole - Concrete Surface - Asphalt Surface - Manhole or Concrete Cover - PVC Pipe	Jensen & Olson Land Surveying, LLC 45 South Wisconsin Street * P.O. Box 322 * Elkhorn, Wisconsin. 53121 Telephone: (262) 723-3434 * Facsimile: (262) 723-8044 Email: jensen.olson@elknet.net	Scale in Feet 1" = 30' 0' 15' 30' 60' 90'	Survey date: July 3, 2000. Revisions: No. 1 - Building under Construction, Shed removed
	Drawing Name: 11w176-2009038-2009038 Plat.sj				
	Job Reference Number 2009.038				

IRP-34B

1A118-1

117-3087