
#1052-72

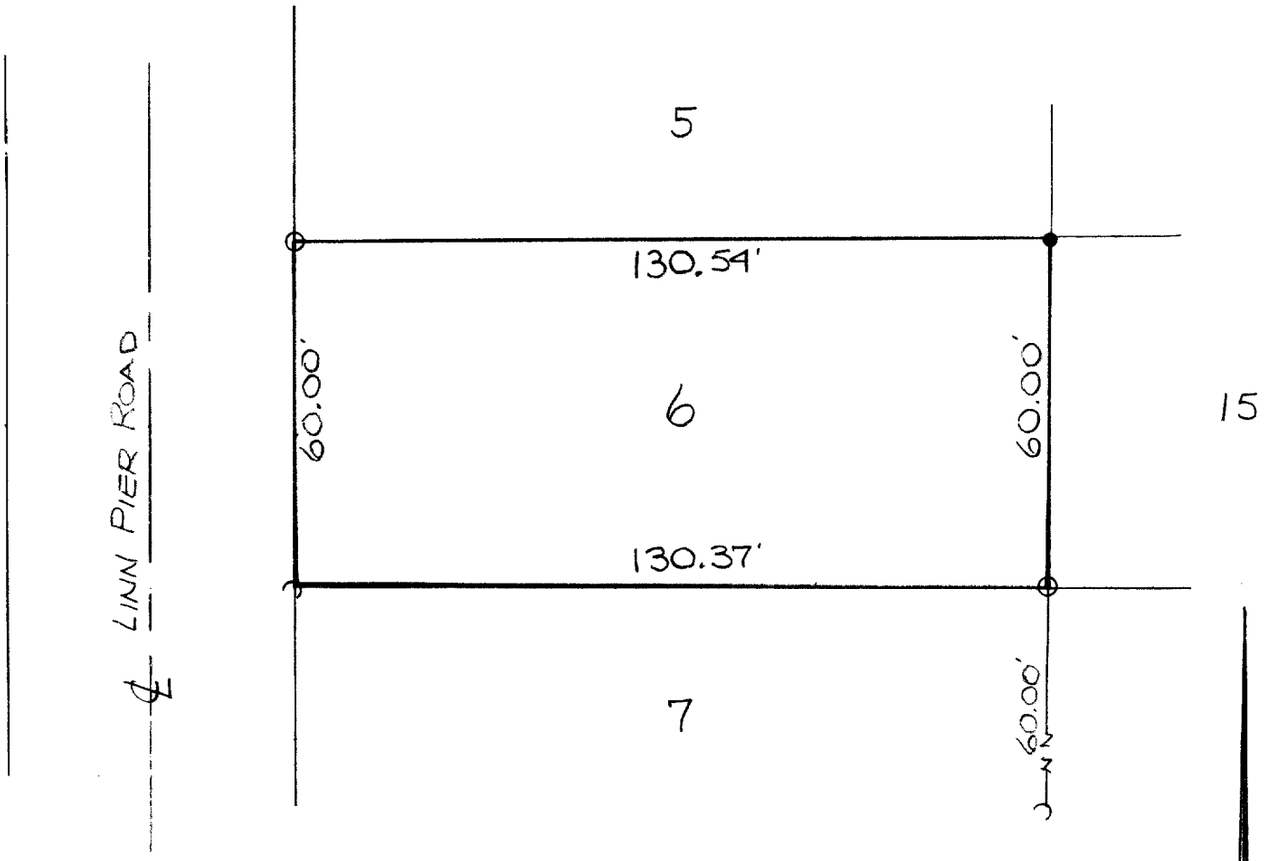

● - INDICATES IRON PIPE FOUND

⊃ - INDICATES IRON TUBULAR SECTION FOUND

O - INDICATES IRON PIPE SET

DESCRIPTION:

A parcel of land described as follows to-wit; All of lot #6 of The Birches 2nd Addition, located in the NW¼ of Section 10, T.1N., R.17E., Walworth County, Wisconsin.

CERTIFICATE:

I, James F. Biagi, surveyor, do hereby certify that I have surveyed the lands hereon described.

DATE:

August 14, 1972

James F. Biagi RLS #272

WISCONSIN JAMES F. BIAGI MILWAUKEE, WIS. LAND SURVEYOR

1BA2-2c

117-30 B