RECEIVED
NOV 19 2009
By


FARRIS, HANSEN & ASSOC. INC.
7 RIDGWAY COURT– P.O. BOX 437
ELKHORN, WISCONSIN 53121
PHONE (262) 723–2098
FAX (262) 723–5886

PLAT OF SURVEY

LOT 42, LAKE GENEVA HIGHLANDS

LOCATED IN THE SE 1/4 SECTION 8
TOWN 1 NORTH, RANGE 17 EAST
WALWORTH COUNTY, WI.

TAX KEY NO. ILGH 00041

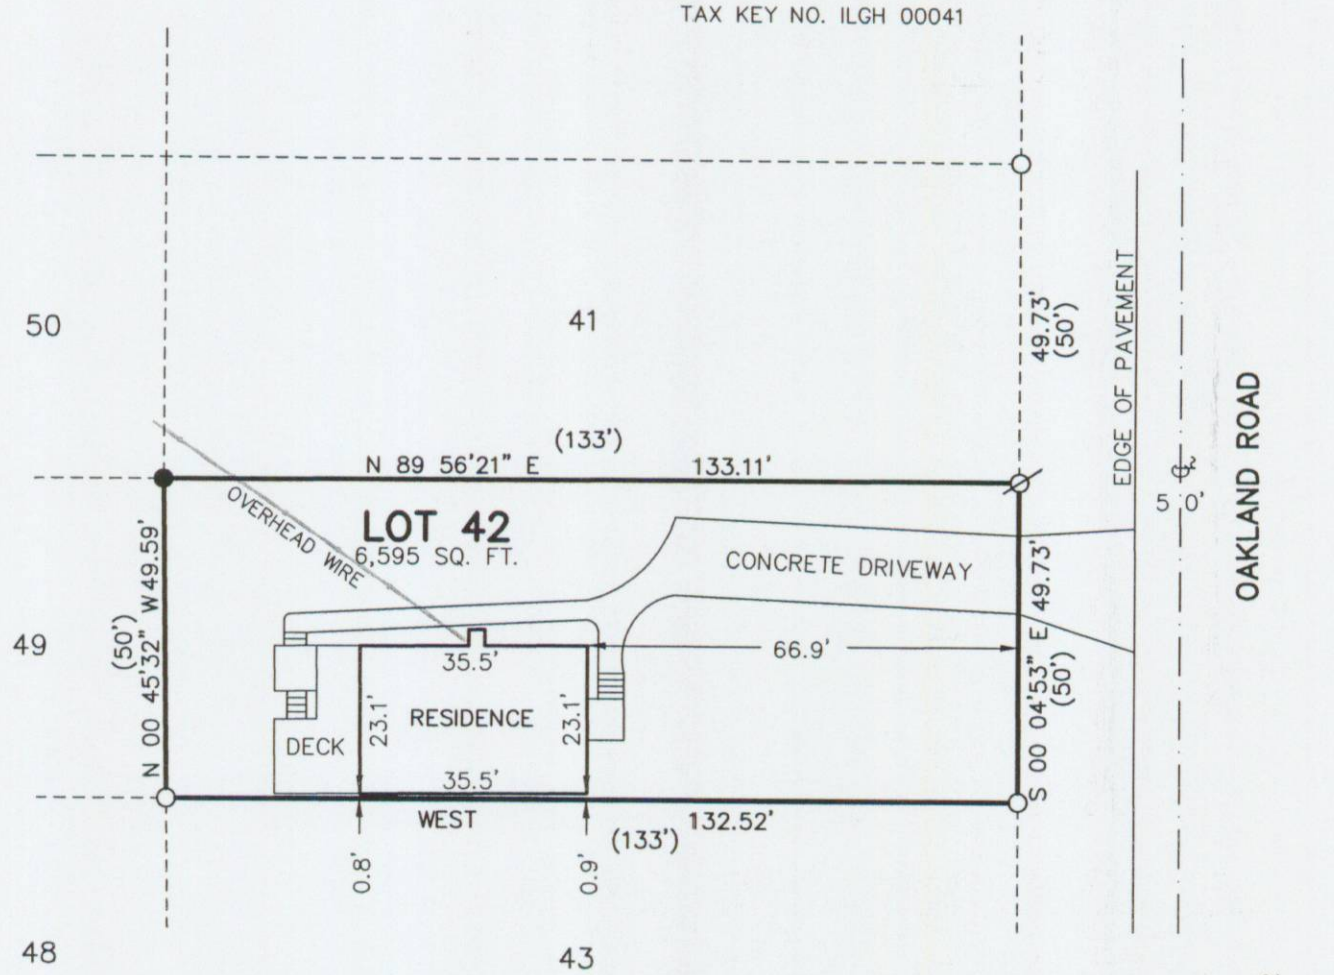

ORDERED BY: KEEFE REAL ESTATE
751 N LAKE GENEVA PARKWAY
LAKE GENEVA, WI. 53147

LEGEND

- ○ = FOUND IRON PIPE STAKE
- ● = FOUND IRON REBAR STAKE
- ⌀ = SET IRON PIPE STAKE
- (XXX) = RECORDED AS

ASSIGNED THE SOUTH LINE OF LOT 42 AS WEST

100 90 80 70 60 50 40 30 20 10 0 50

MAP SCALE IN FEET ORIGINAL 1" = 30'

NOTE: COPIES OF THIS MAP TO WHICH THE FOLLOWING CERTIFICATE WILL APPLY SHOW SURVEYOR'S ORIGINAL SEAL AND SIGNATURE IN RED INK. COPIES BY ANY OTHER MEANS MAY HAVE ALTERATIONS WHICH DO NOT REPRESENT THE SURVEYOR'S WORK PRODUCT.

I HEREBY CERTIFY THAT THE ABOVE DESCRIBED PROPERTY HAS BEEN SURVEYED UNDER MY DIRECTION AND THAT THE ABOVE MAP IS A TRUE REPRESENTATION THEREOF AND SHOWS THE SIZE AND LOCATION OF THE PROPERTY, ITS EXTERIOR BOUNDARIES, THE LOCATION OF ALL VISIBLE STRUCTURES, AND DIMENSIONS OF ALL PRINCIPLE BUILDINGS THEREON, BOUNDARY FENCES, APPARENT EASEMENTS, ROADWAYS, AND VISIBLE ENCROACHMENTS, IF ANY. THIS SURVEY IS MADE FOR THE USE OF THE PRESENT OWNERS OF THE PROPERTY, AND ALSO THOSE WHO PURCHASE, MORTGAGE, OR GUARANTEE THE TITLE THERETO WITHIN ONE YEAR FROM THE DATE HEREOF.

DATED: OCTOBER 20, 2009

PETER S. GORDON R.L.S. 2101

WISCONSIN PETER S. GORDON S-2101 ELKHORN, WI LAND SURVEYOR

PROJECT NO. 8022
DATED: 10–20–2009
SHEET 1 OF 1 SHEETS

OCT 20 2009 ILGH-41